


358
02

5 cm

SOUTH LODE

Scale 25 Feet = 1 Inch


N 32° 00' W H. S 37° 00' E

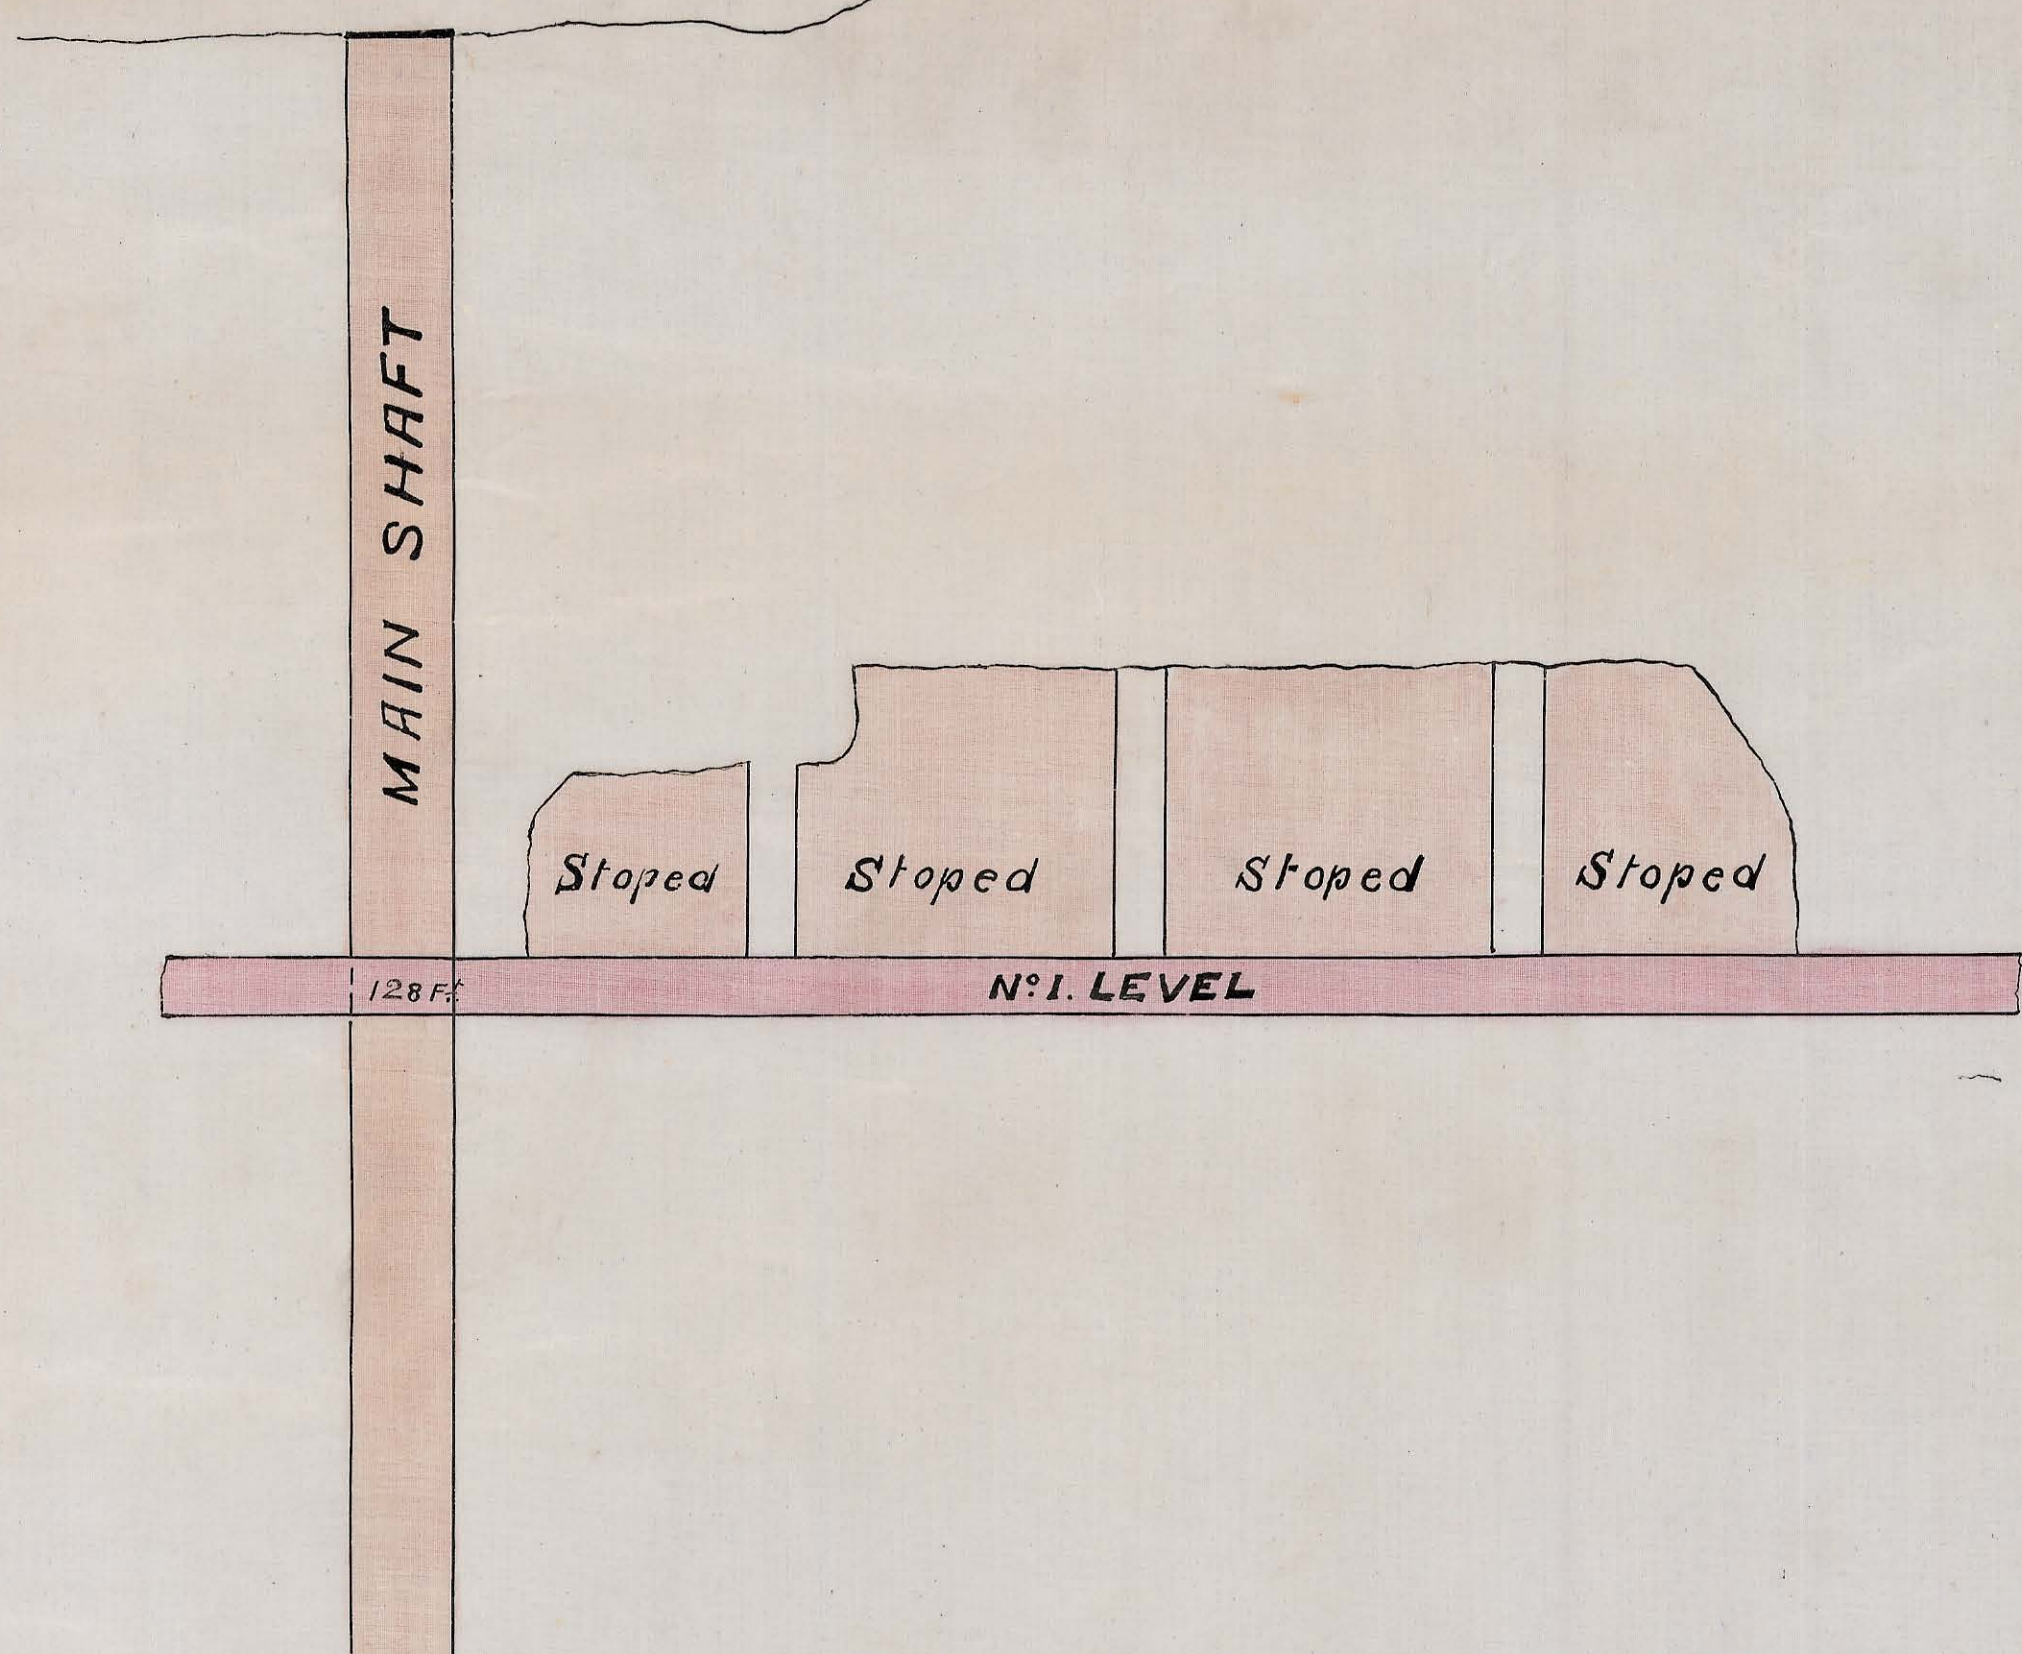

CURRIES LODE

Scale 25 Feet = 1 Inch


N 4° 45' W D E S 4° 45' E

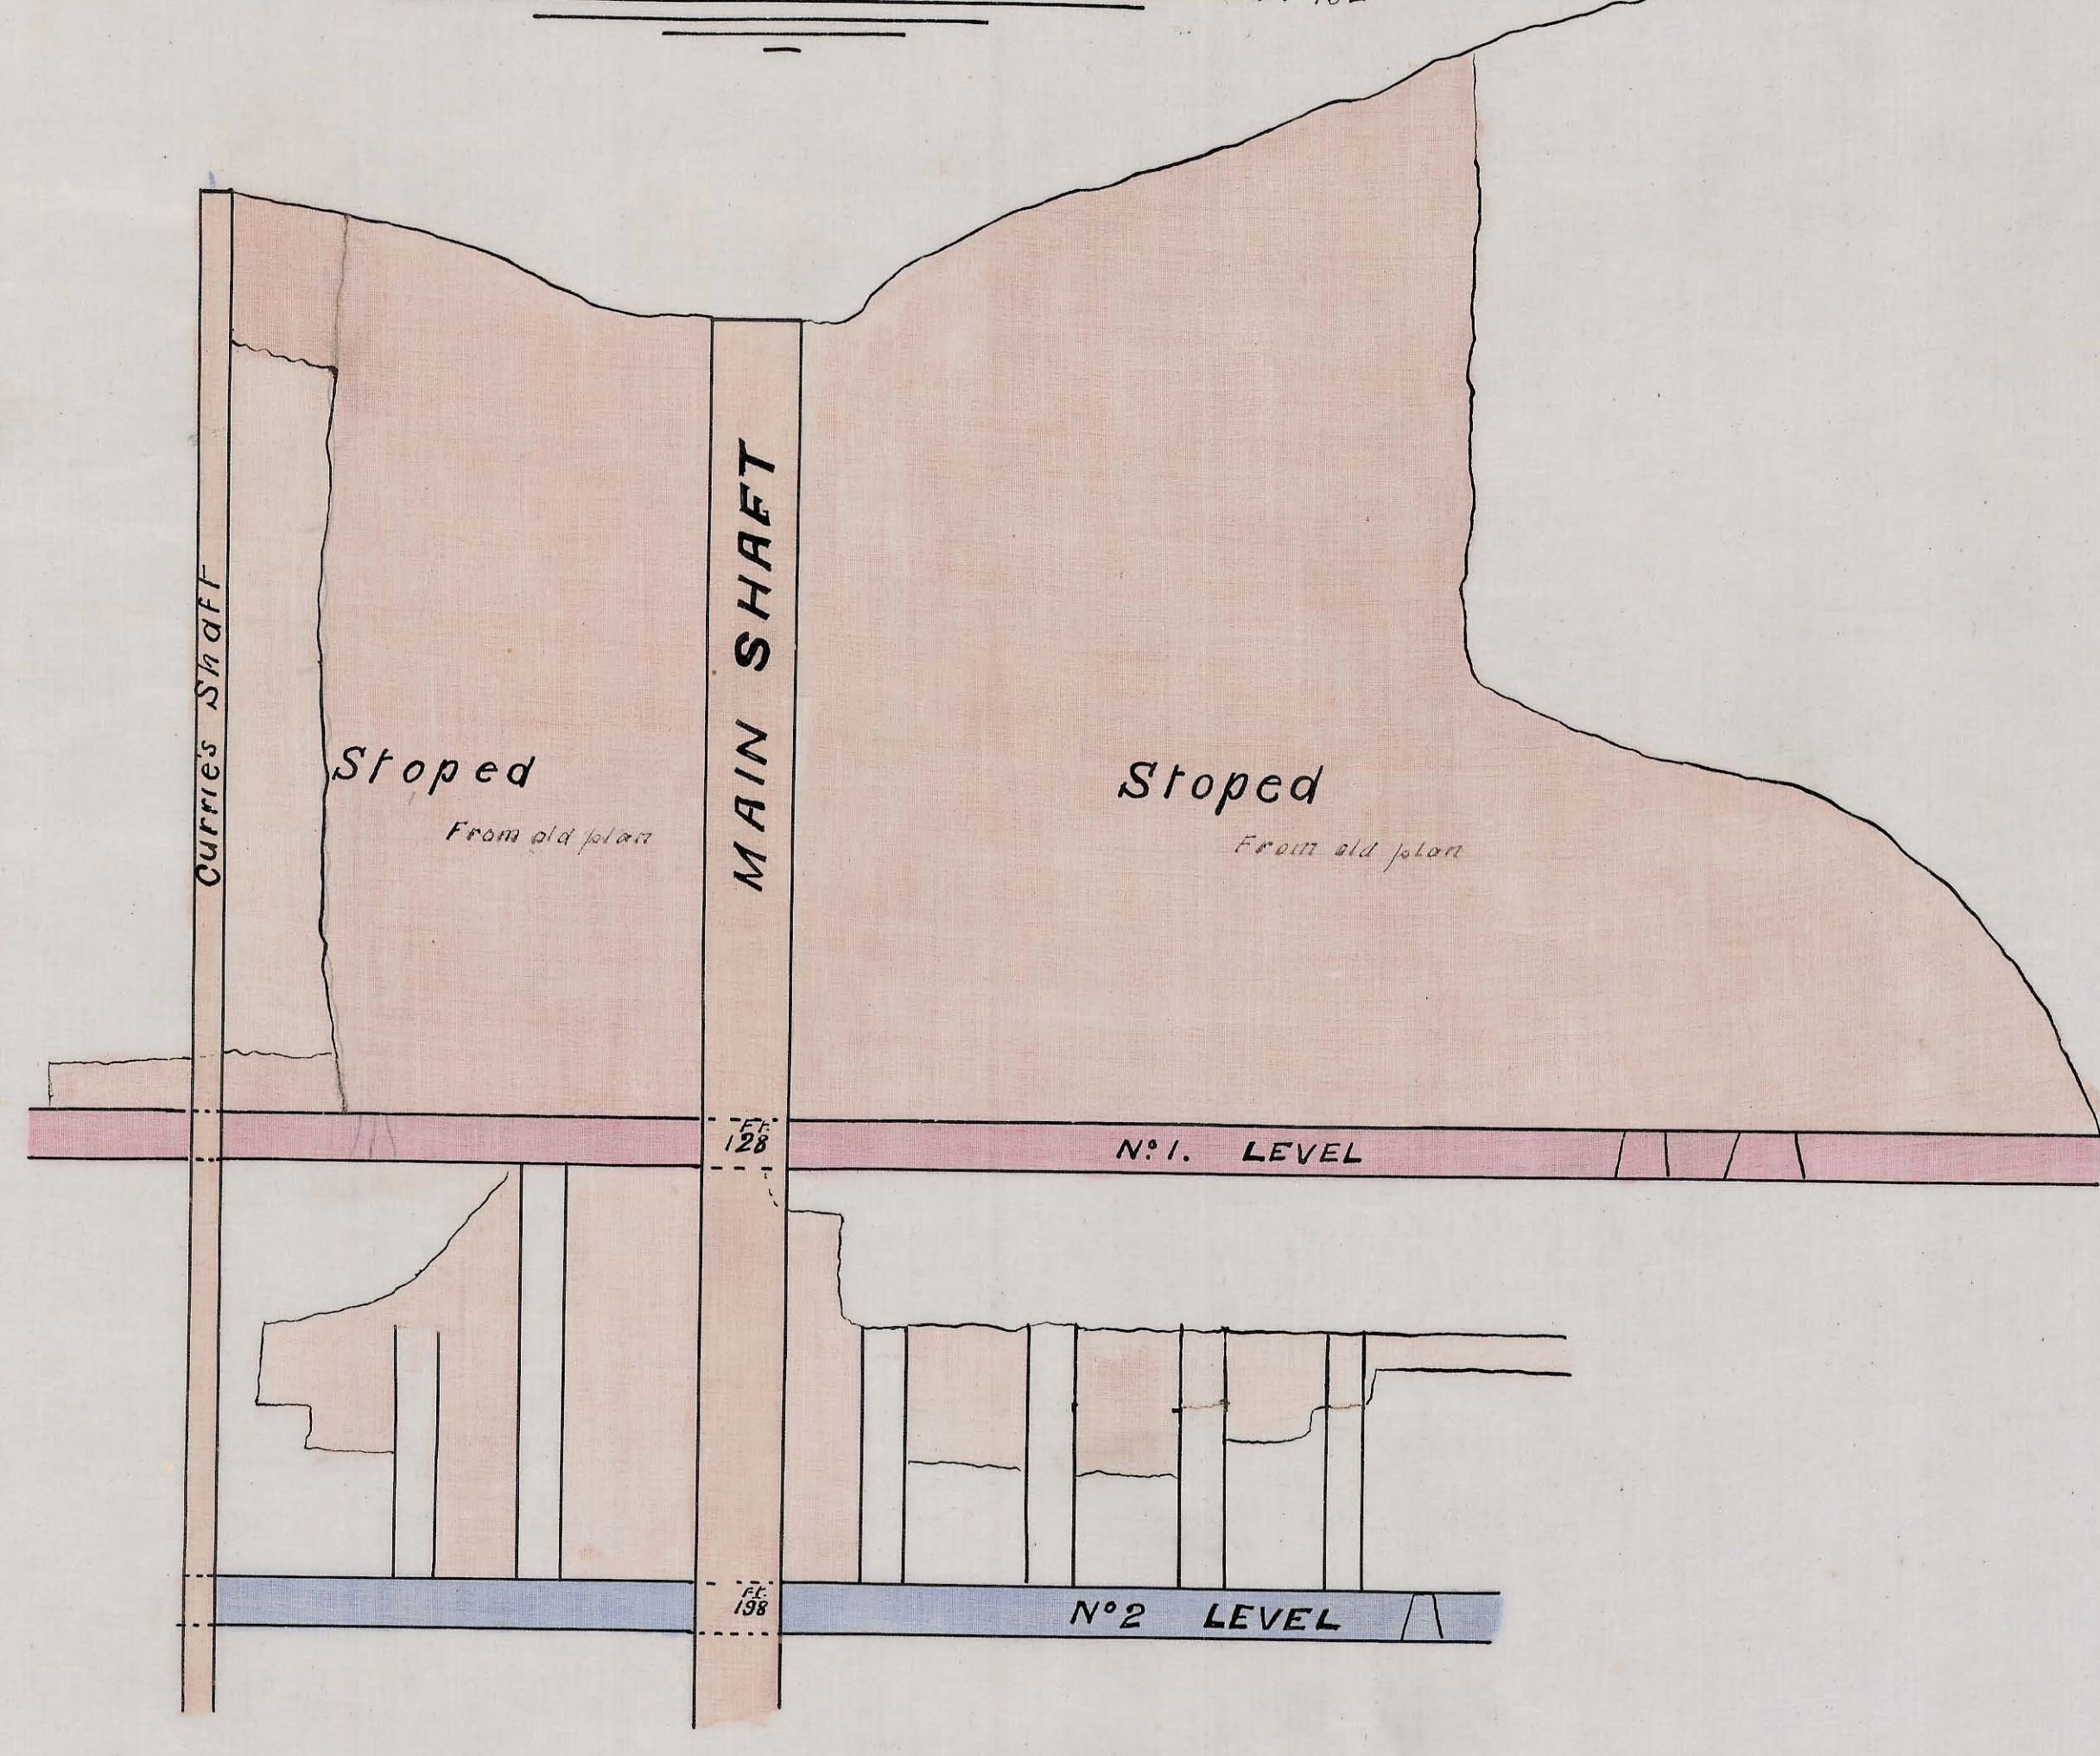

ASTELL'S LODE

Scale 25 Feet = 1 Inch

N 18° 00' W F G S 18° 30' E

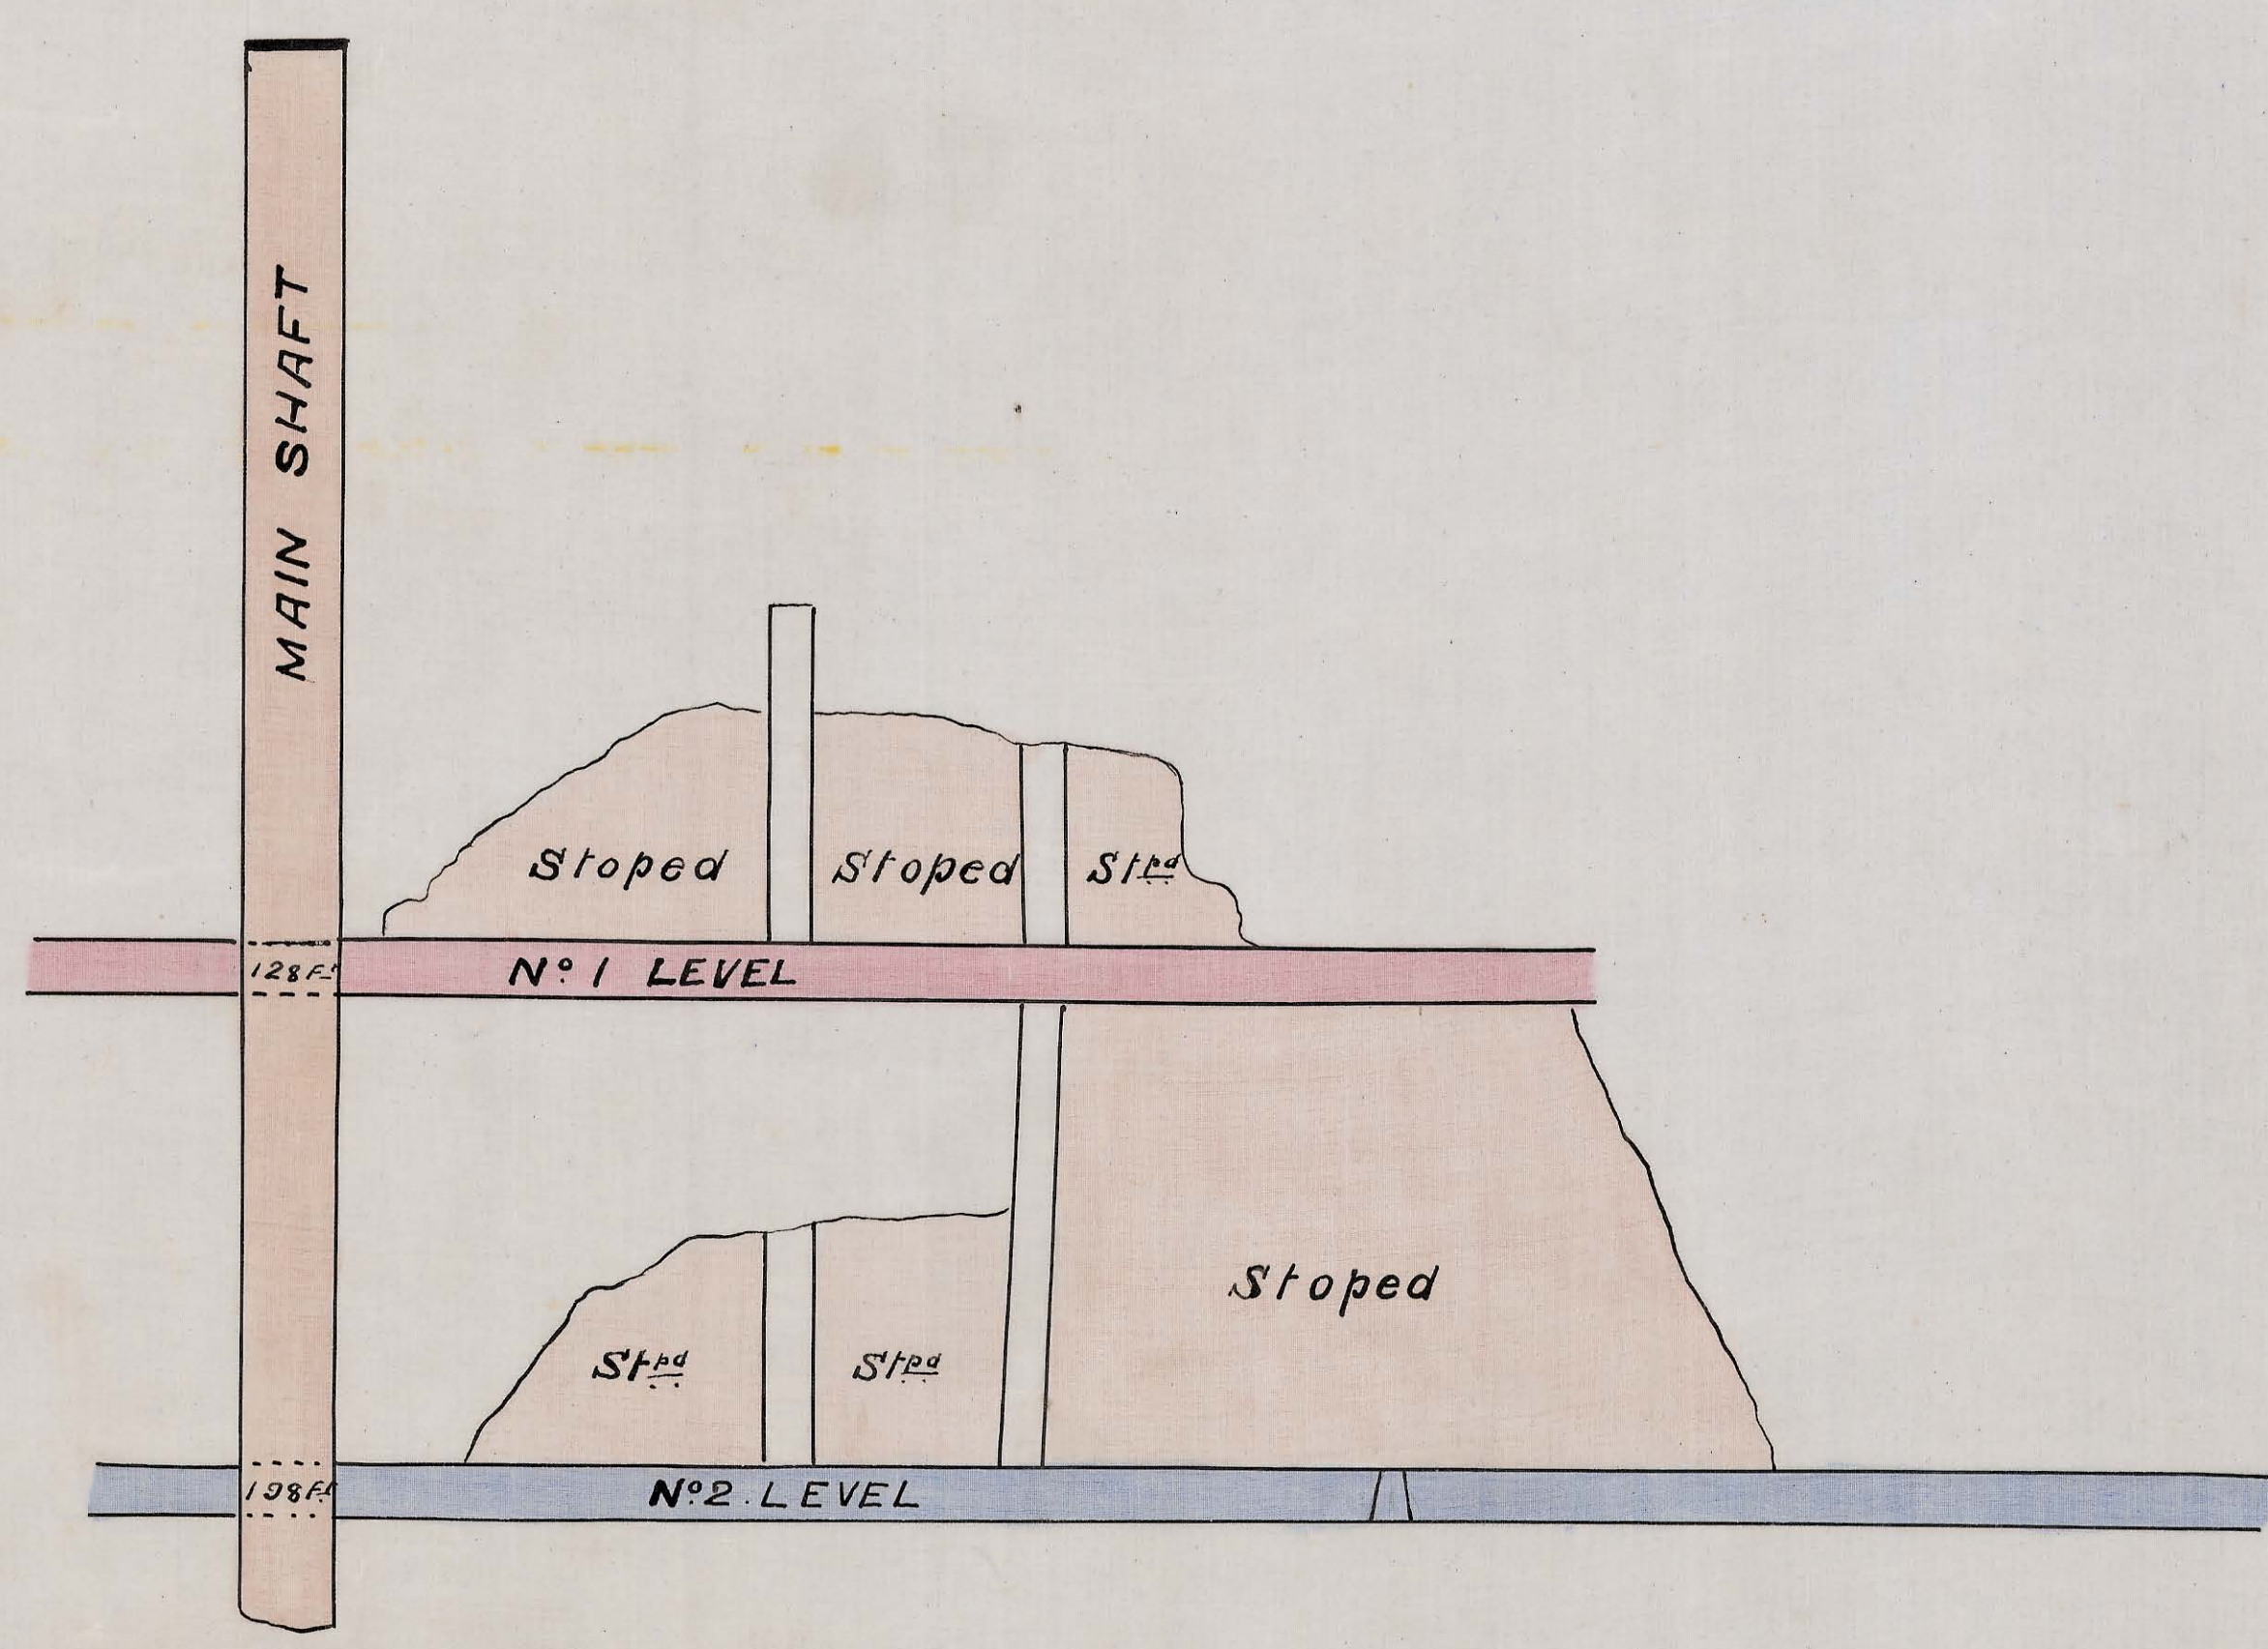

Wm. H. Briggs
Wm. H. Briggs
Florence & H. H. H. H.
15/3/1905

358
02