


# ZEEHAN-BELL MINE

Late New Silver Bell

Scale 30 feet to an inch

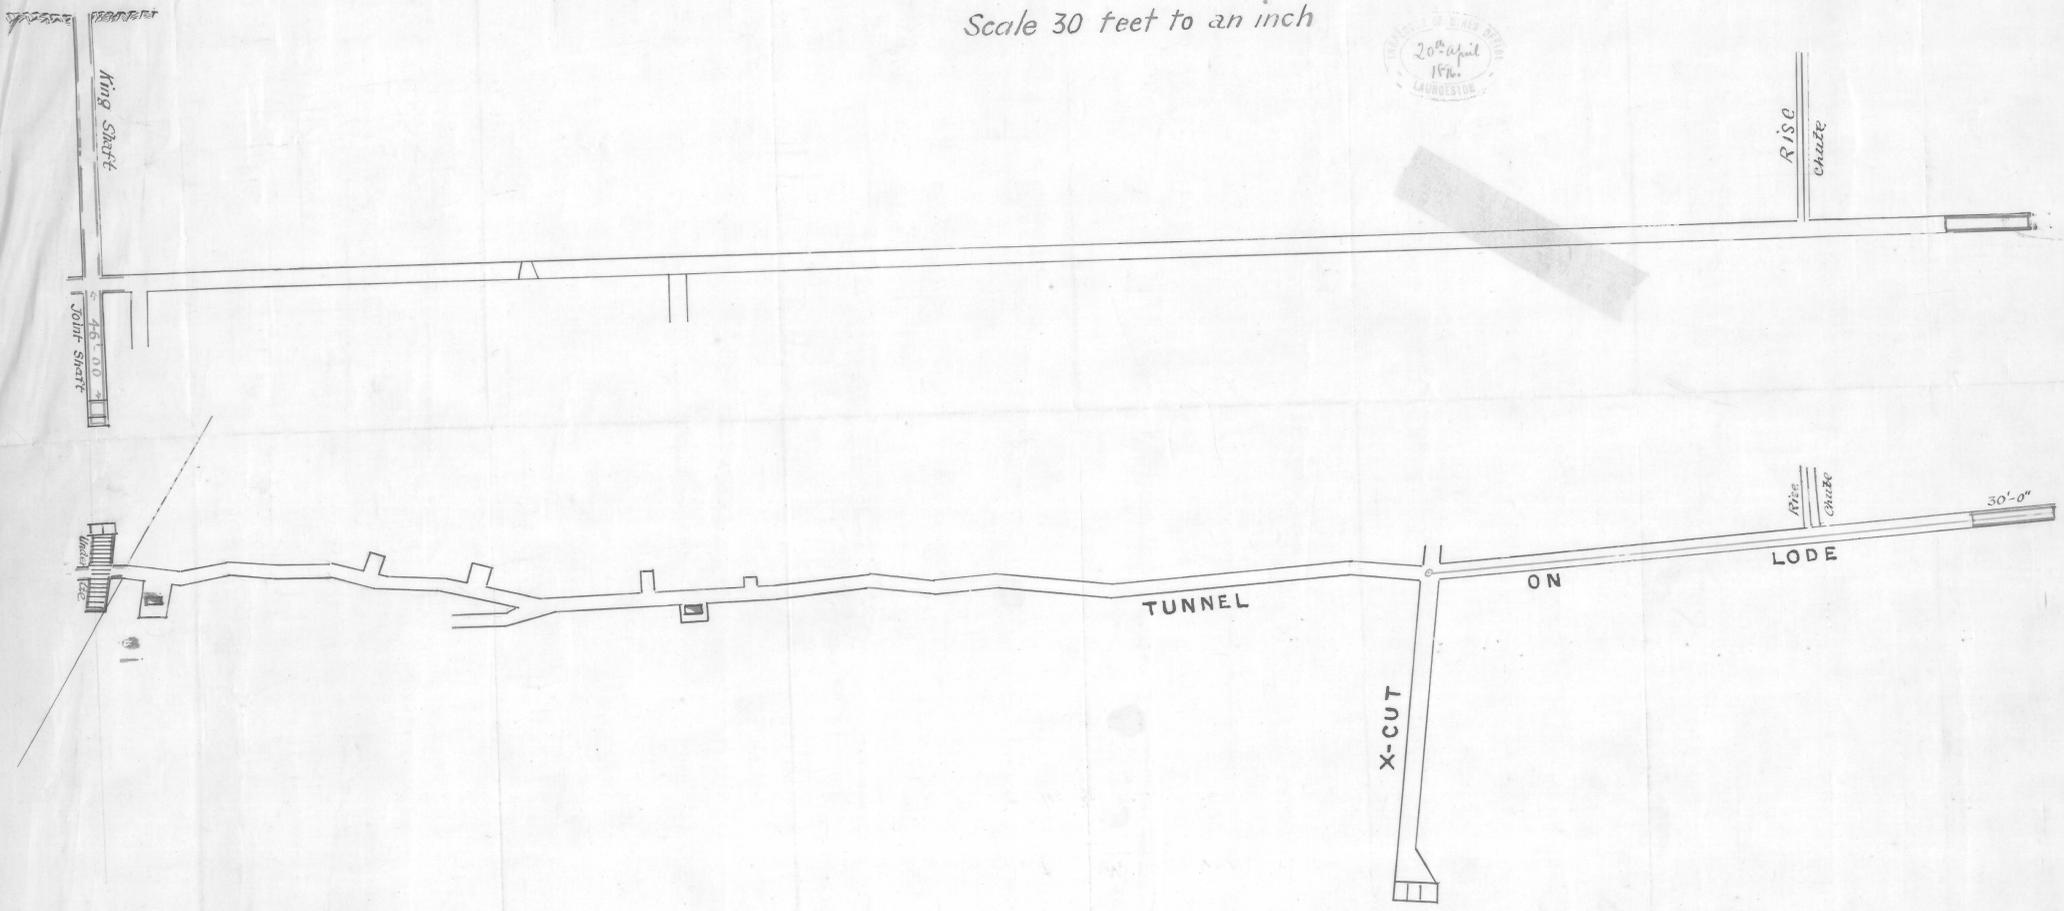

359  
01

*Ch. Glover  
Auto Survey  
Zeehan Jan '96*

359  
01