

359
03

359
03

11581 mds
11581 mds

500
500

PLAN

OF

UNDERGROUND WORKS

SILVER BELL S. M. CO.


Scale 50 feet to inch

Magnetic Meridian

SILVER KING CO.

SILVER BELL CO.

480 M
87

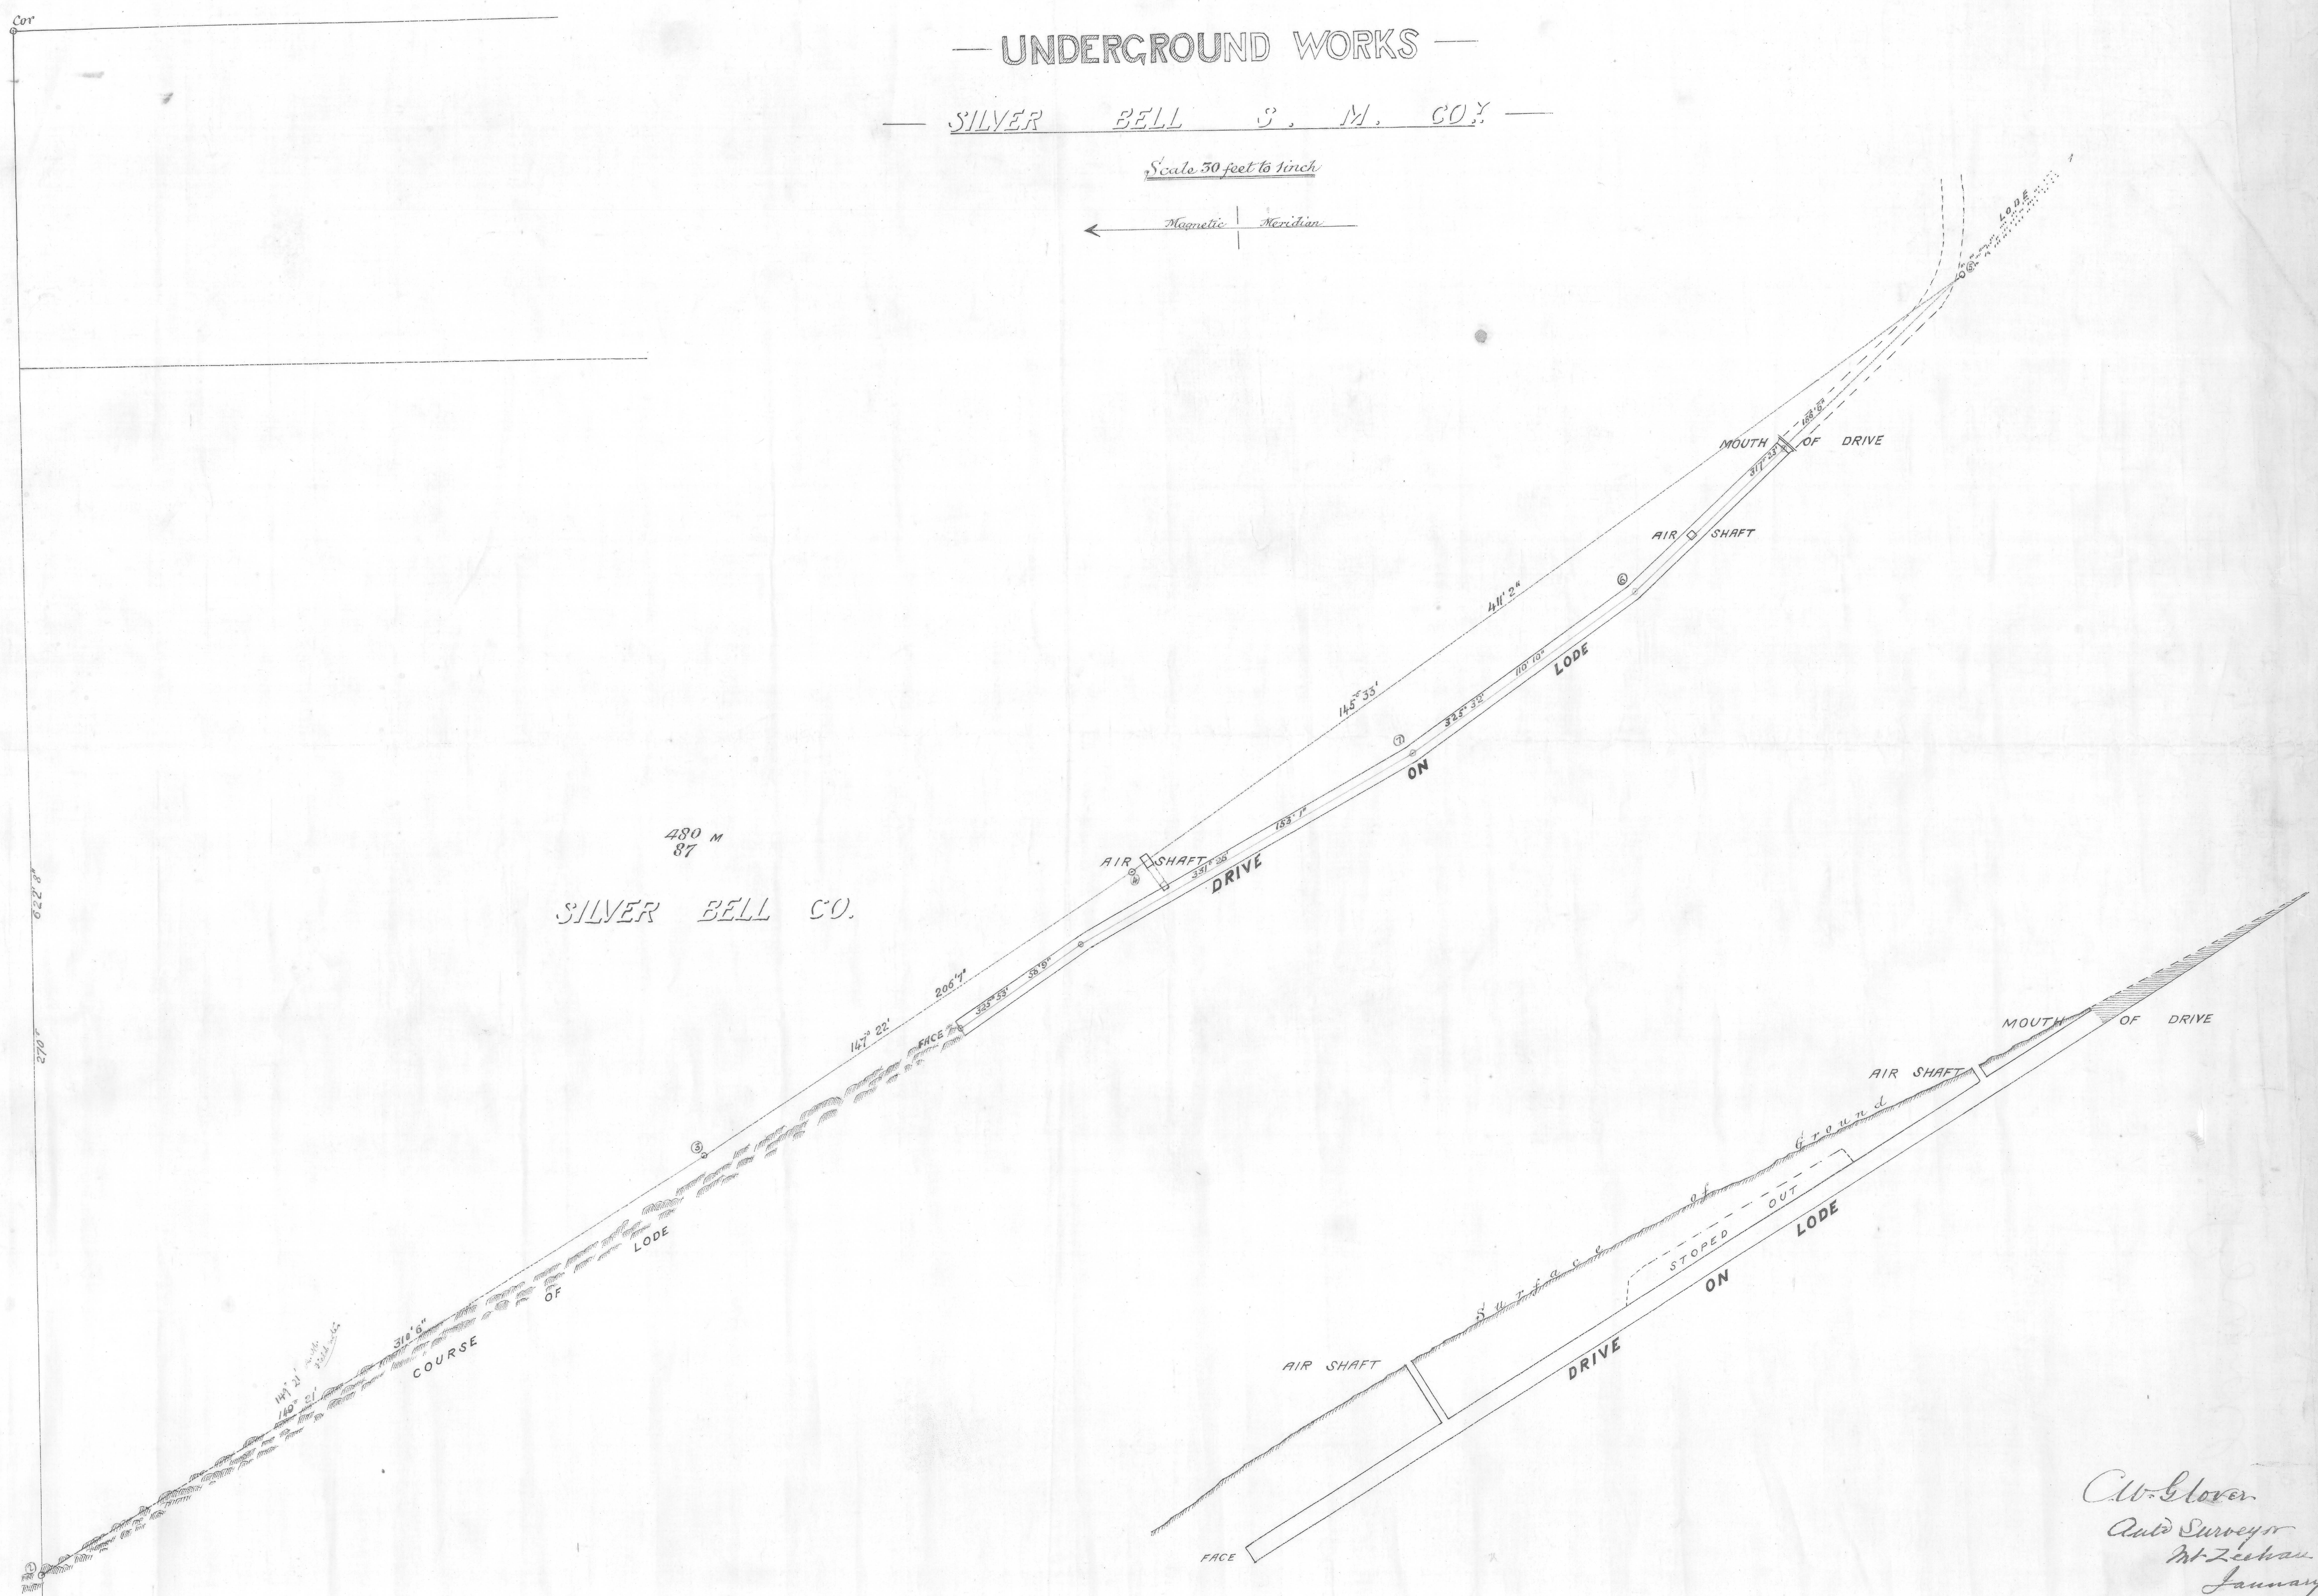

C. W. Glover
Auto Surveyor
Mt. Zeehan
January 1891