


MADE IN
GREAT
BRITAIN

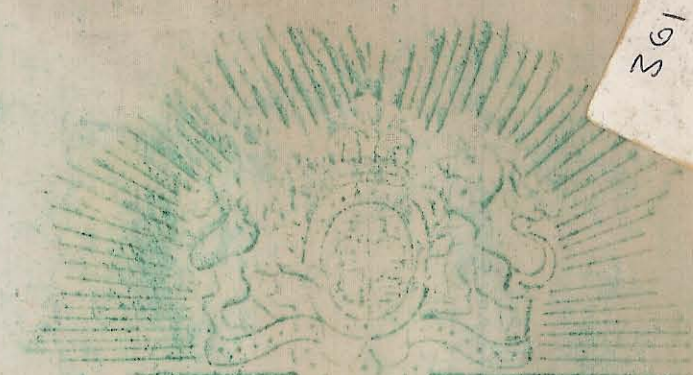

THE
VELLUM TRACING CLOTH
Sagars Patent
1861 No 122
POUGHAM WORKS, MANCHESTER


Colonel North Mine

LONGITUDINAL SECTION

Scale 30 feet = 1 inch

By W. J. Yates
Mine Manager

23/12/08

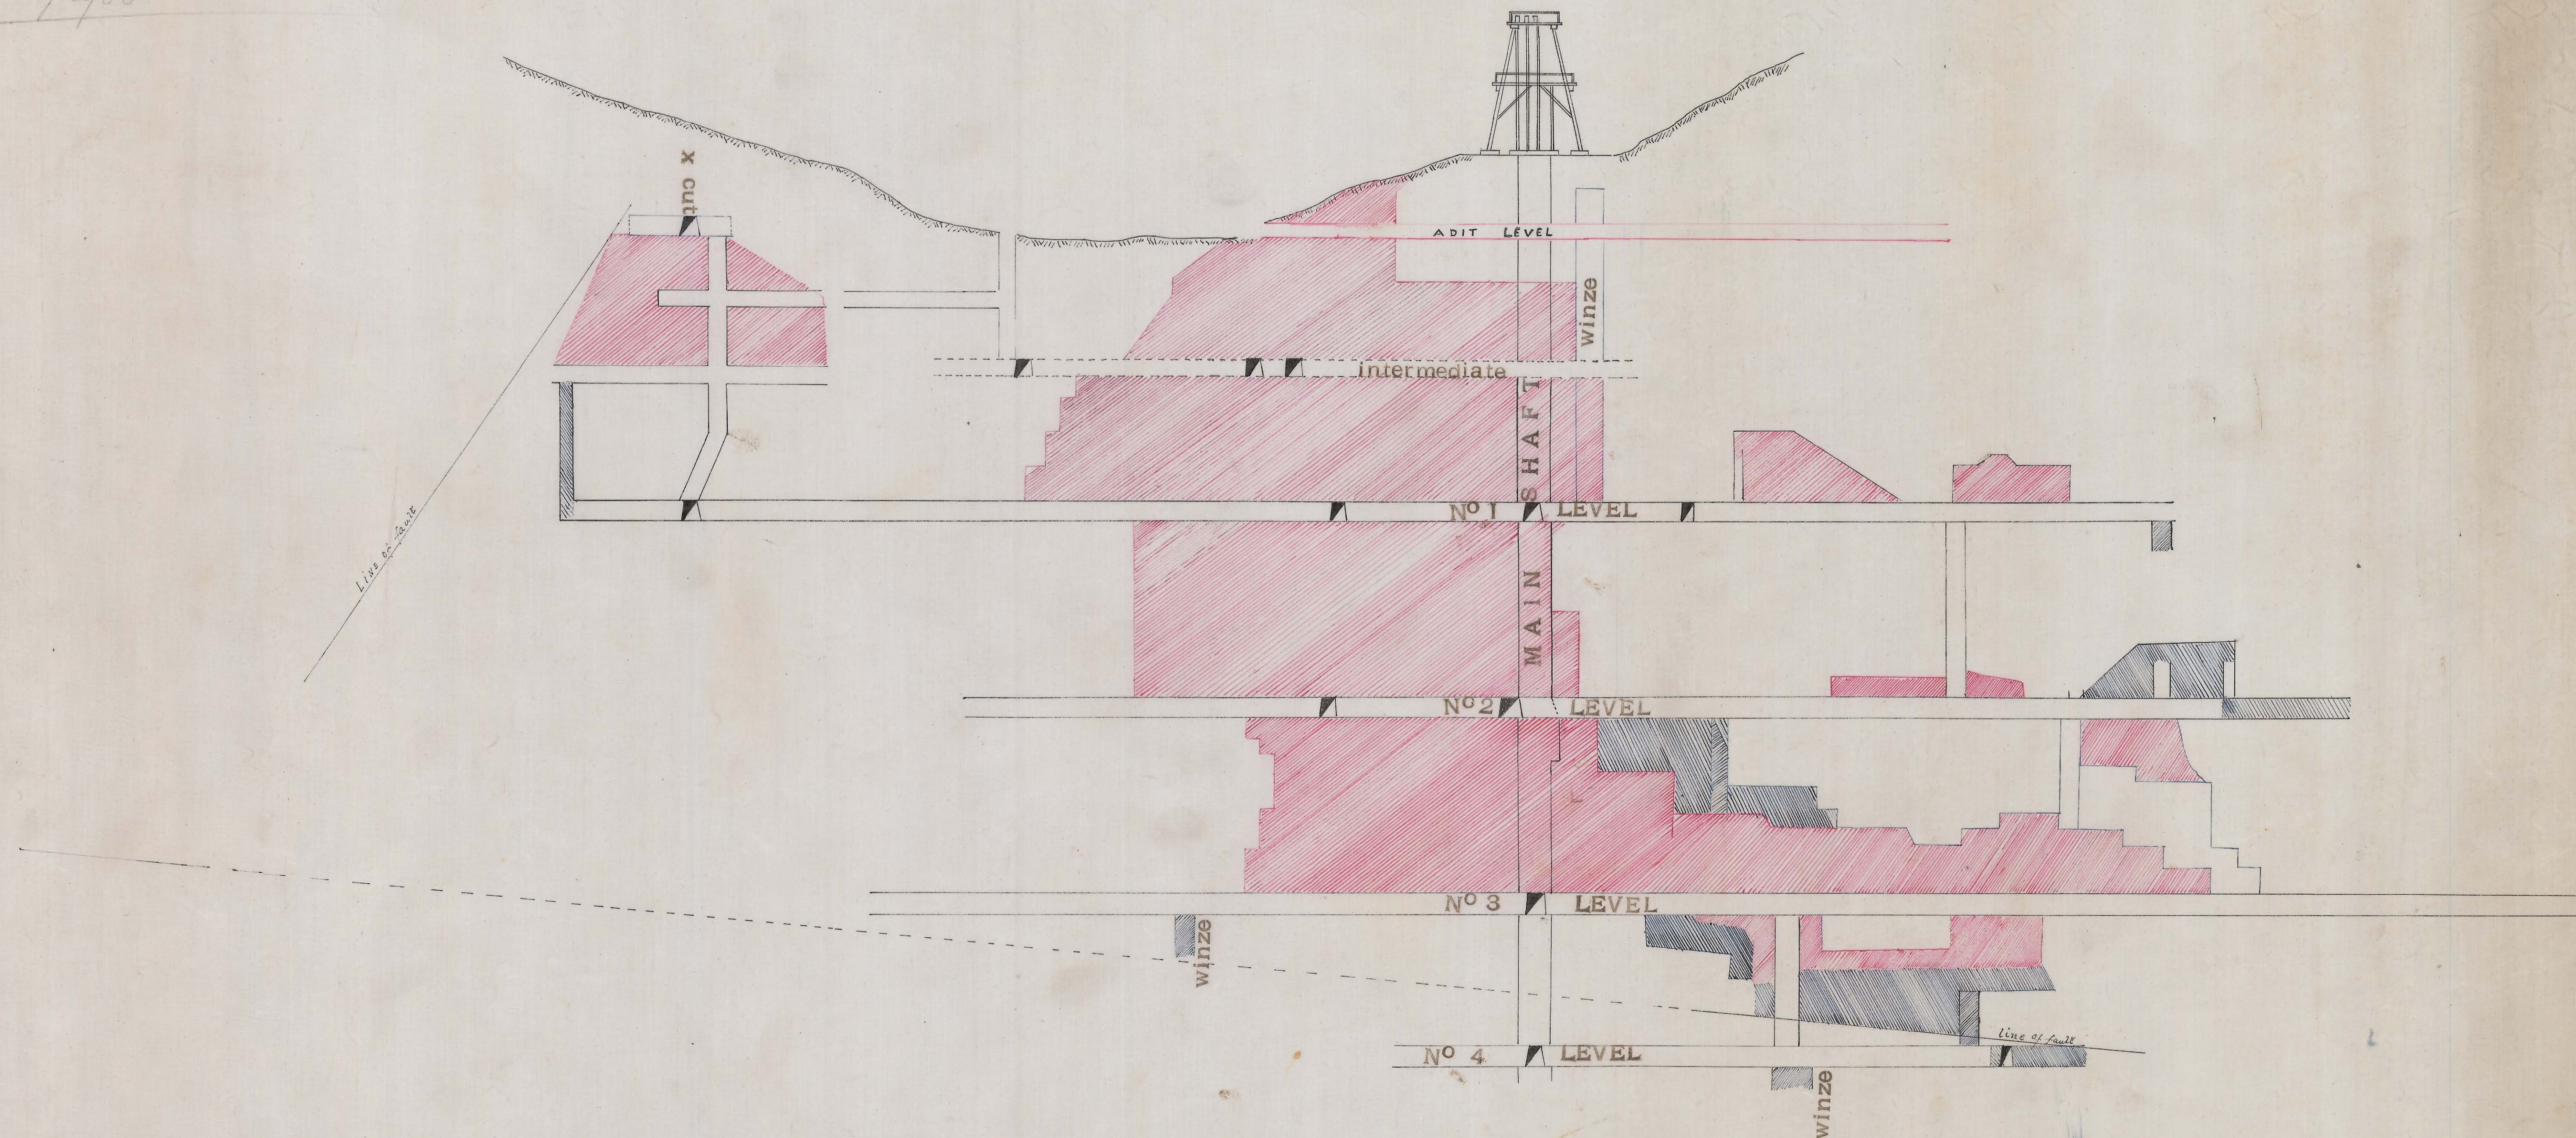

REFERENCE

Stoping Prior to 1908

work Done During 1908

5 cm