
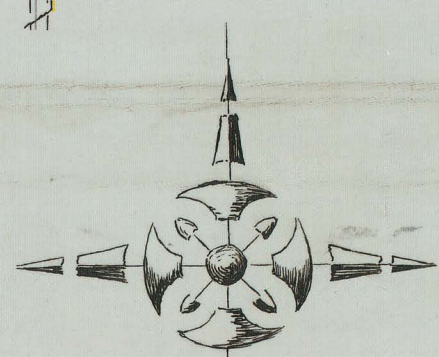


NEW M^r ZEEHAN S^r M^r C^r L^r BY: J.M.
ADIT WORKINGS ON BLOCK 559

Scale - thirty feet to an inch


5th transit used
Has been 21 days 1901

R.B. Montgomery
Auth. Surveyor
Aug. 14, 1901

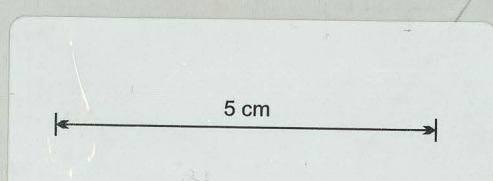


Mag. N. 10° E.

PROJECTION OF DRIVE NORTH

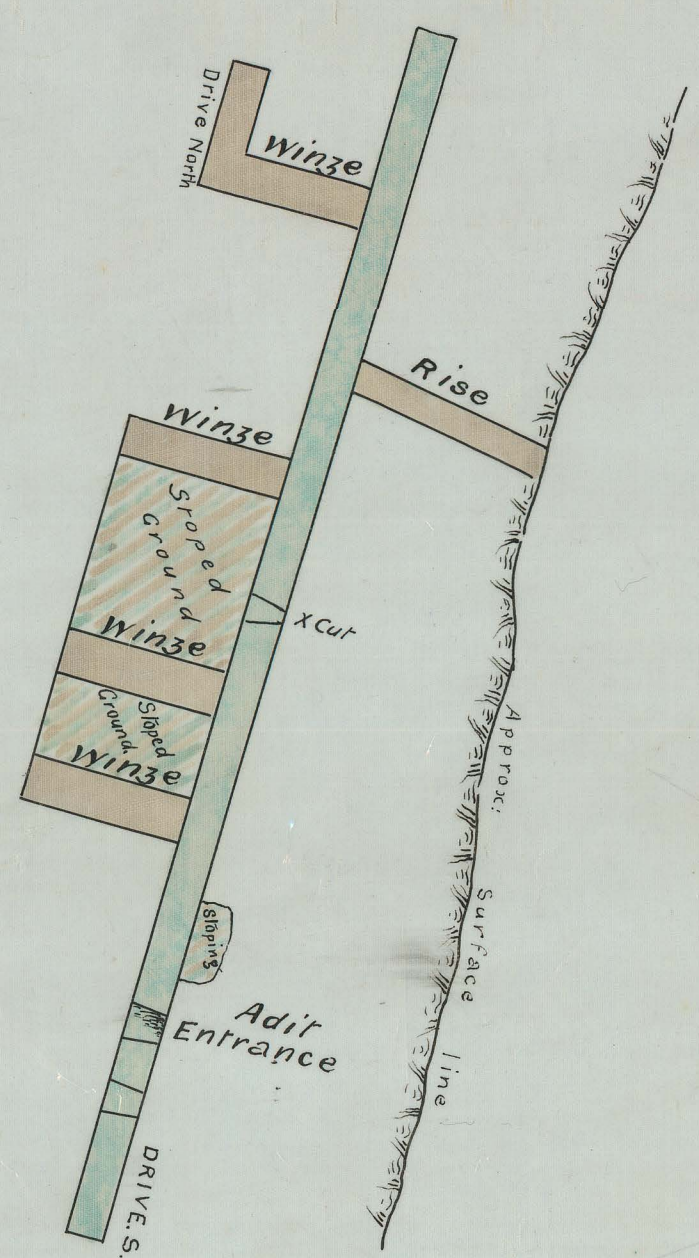

8.55' Engine shaft 72' x 12'

DRIVE NORTH

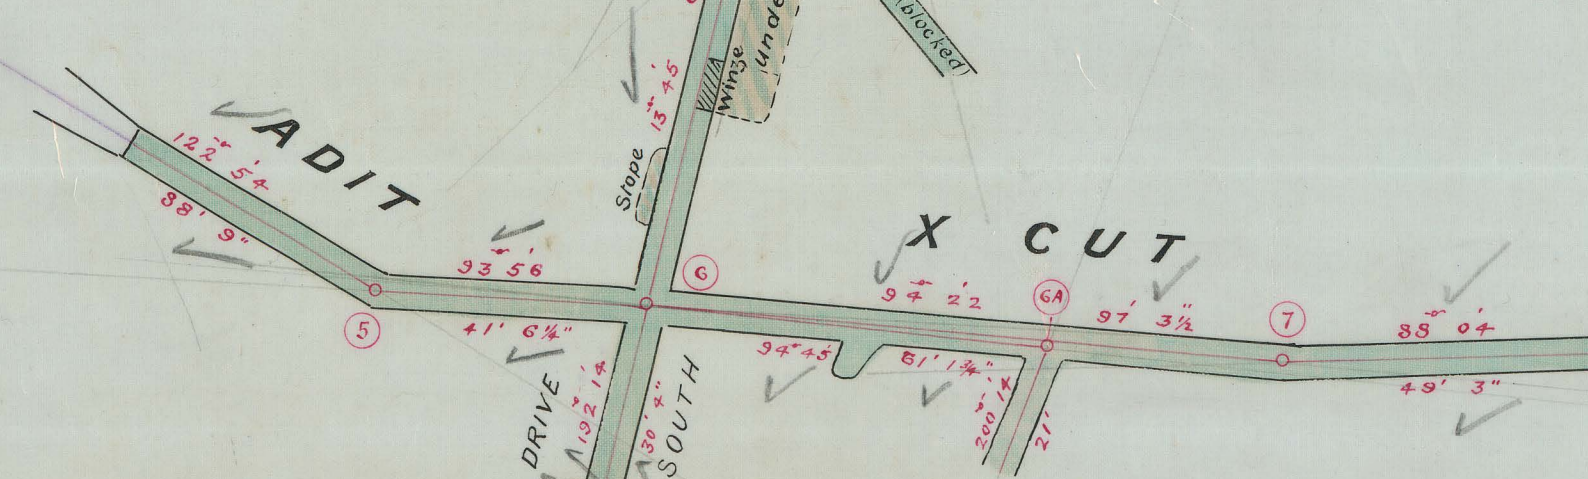

X CUT ADIT

X CUT ADIT

SECTION

PROJECTION OF CROSS CUT