


363
- 02

INSPECTOR OF MINES OFFICE
LAUNCESTON
11/2/92
A. J. J.

—Longitudinal Section—

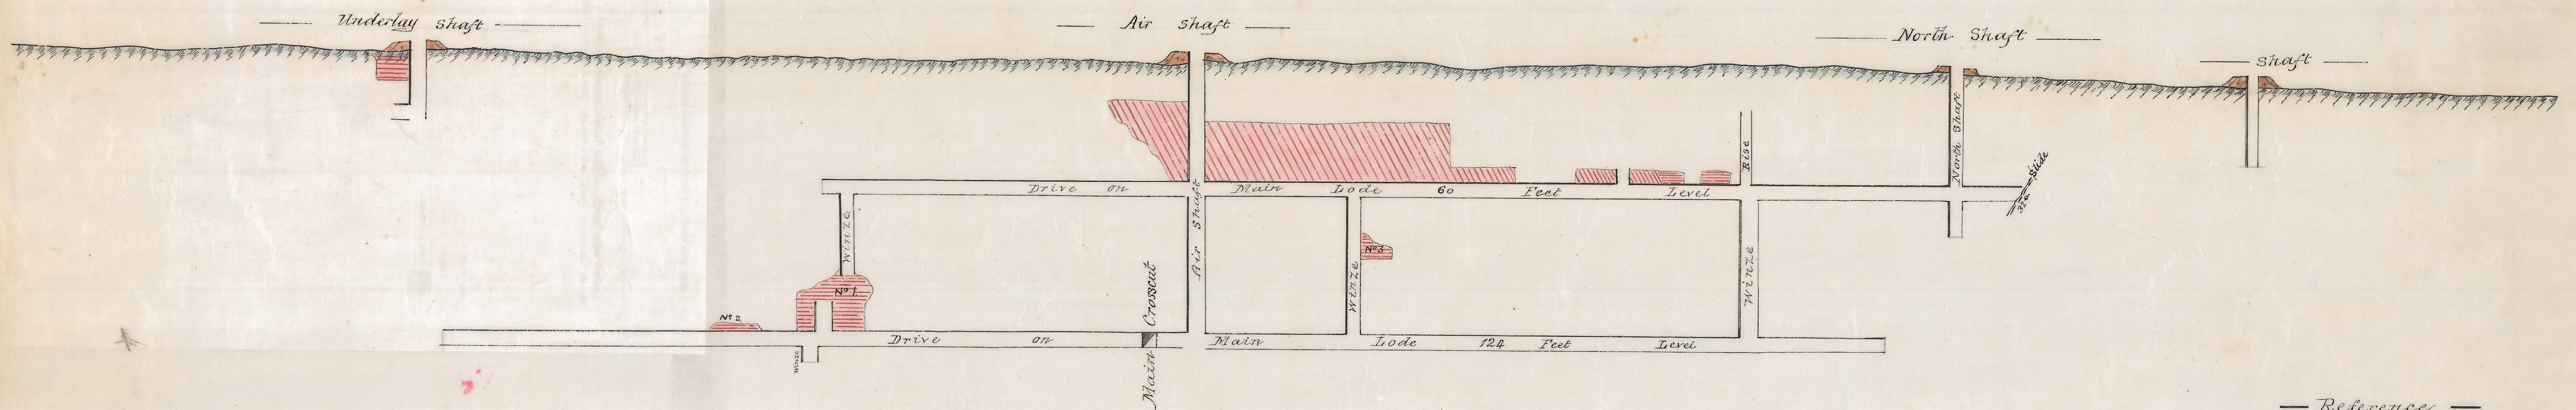

— Reference —

 Stopped to the 30th June 1891.

 Stopped for Half Year ending 31st Decr 1891.

Scale 30 feet to 1 inch.

W H Wesley
Graham
9/19/1

63

2