


making the map  
1881 map




# PLAN OF UNDERGROUND WORKS OF THE M<sup>T</sup> ZEEHAN SILVER LEAD MINING CO LIM<sup>TD</sup>


Scale 30 feet to one Inch

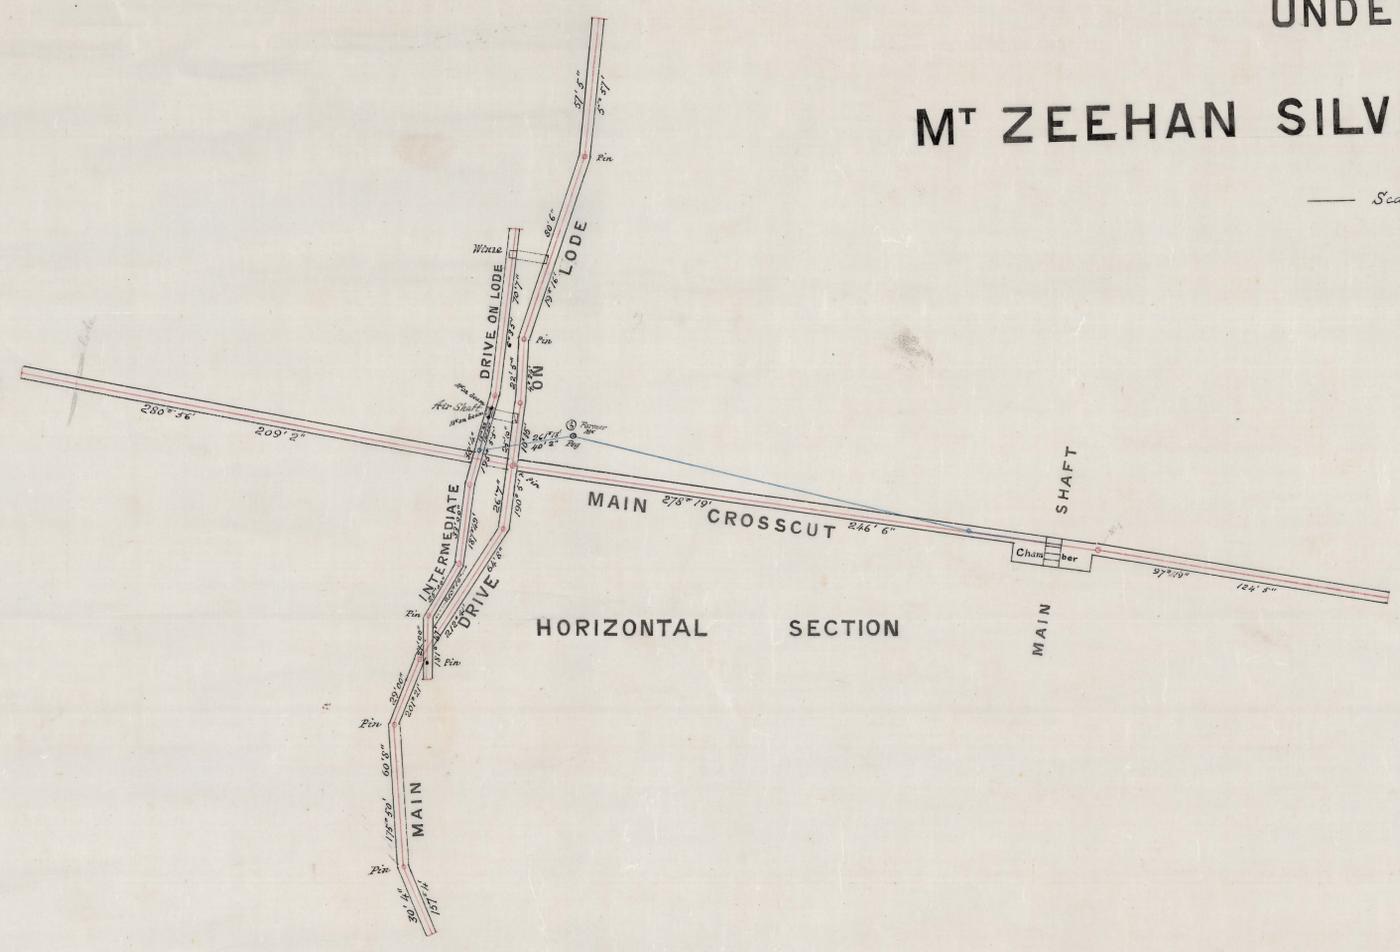

HORIZONTAL SECTION

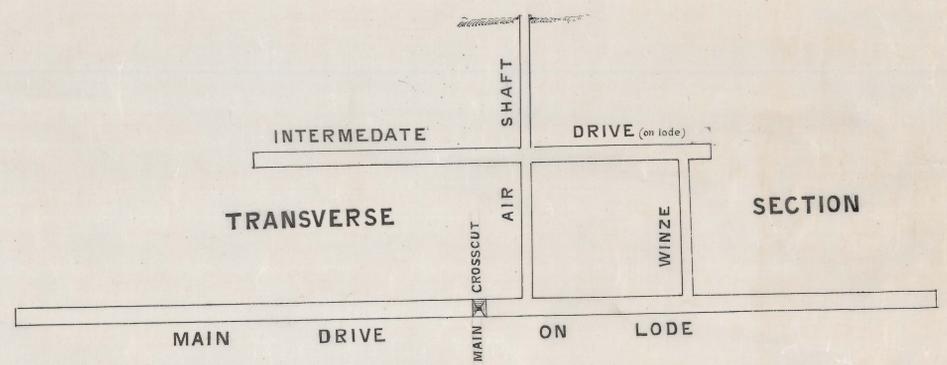

TRANSVERSE SECTION

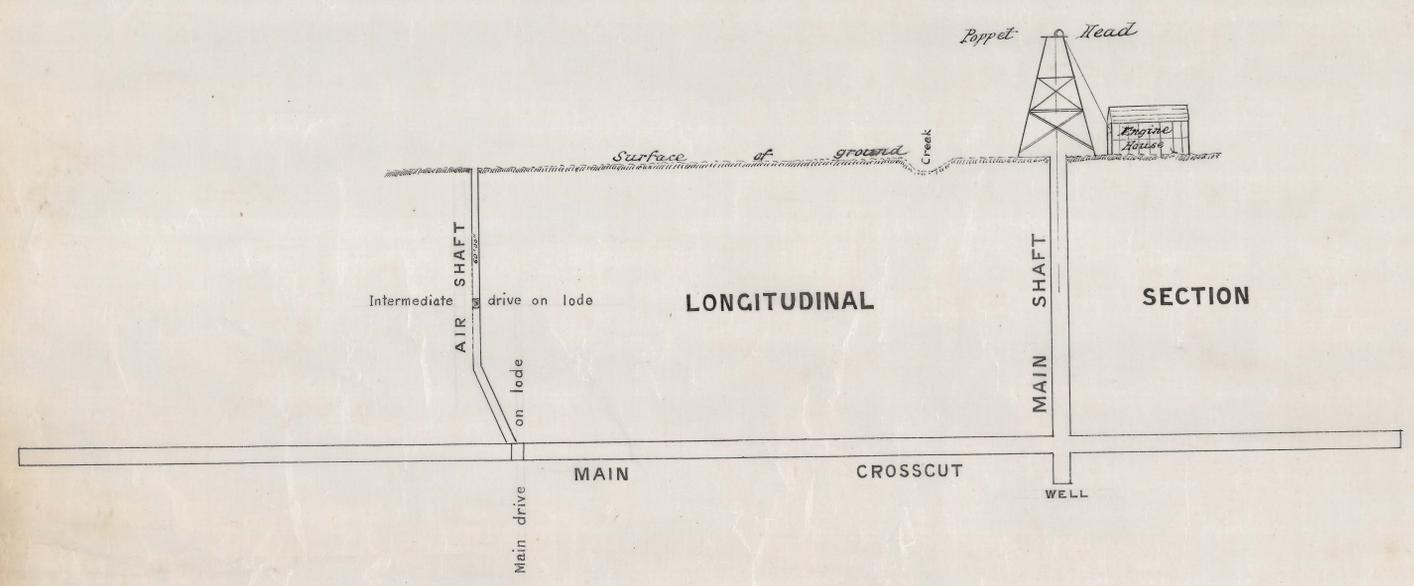

LONGITUDINAL SECTION

*W. A. Love*  
Chief Surveyor  
Mt Zeehan  
January 1891