

363
44

909 M
Mt Zeehan Co.
164 M
Silver Queen Co.





PLAN

OF THE

Mount Zeehan Silver Lead Mining Company Limited

made by Mr. J. J. Smith
for 1881
3/1/1884

REGISTRAR OF MINES
3/1/1884
TASMANIA

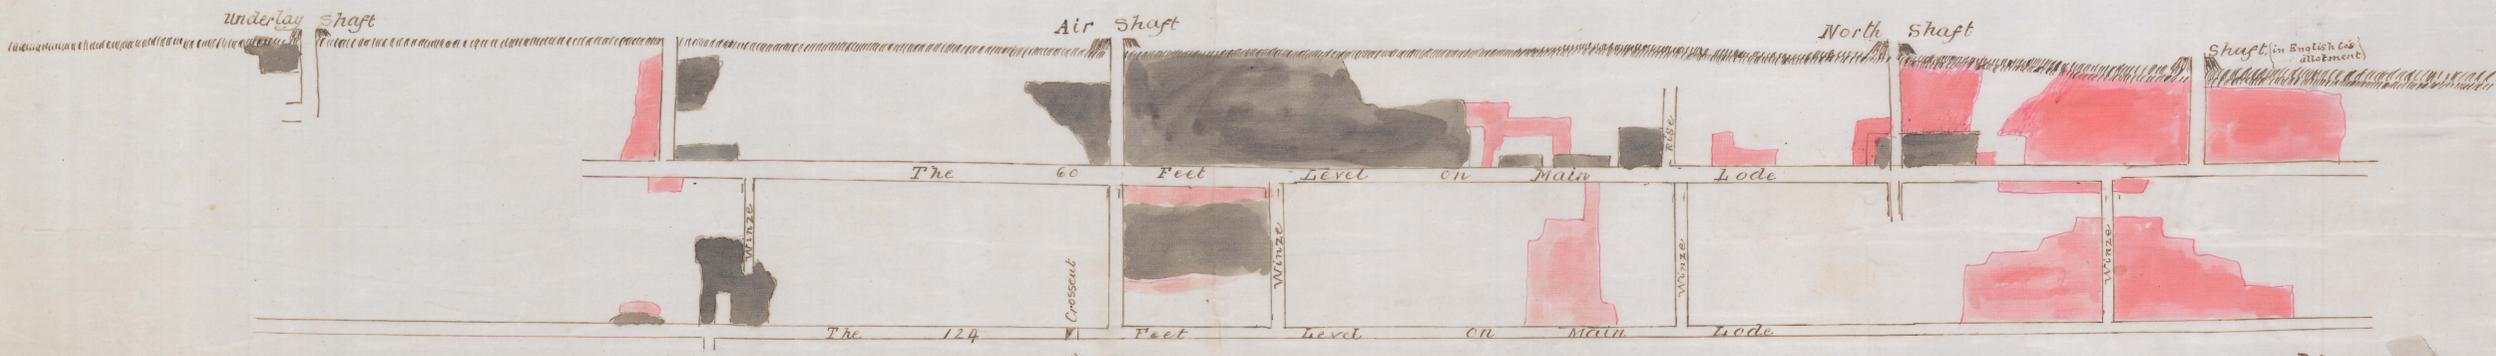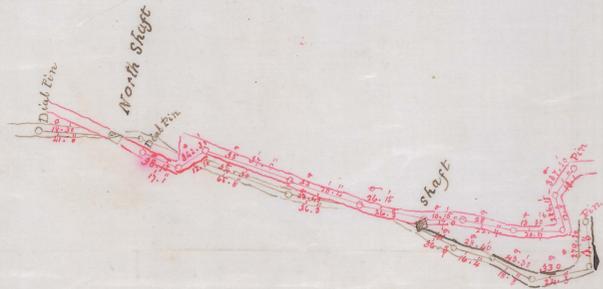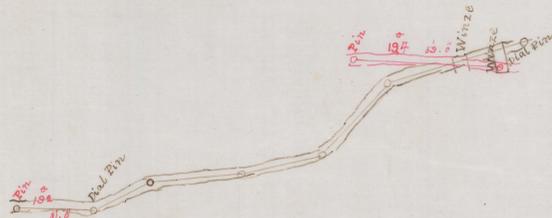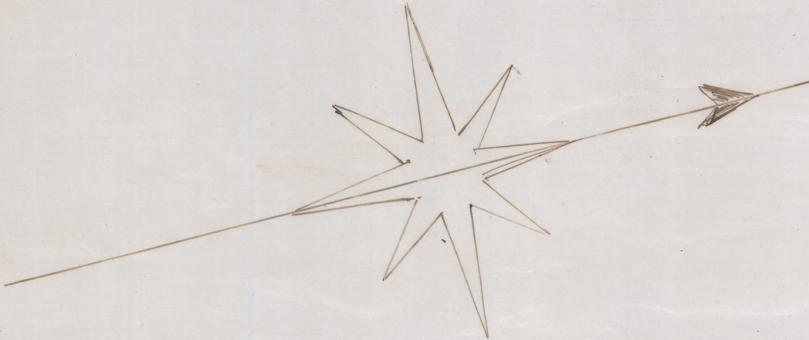


LONGITUDINAL SECTION

Scale 30 feet to 1 inch

References

- Stoped to the 31st Dec 1892
- do for 4 months to 1st May 1893

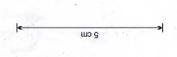

1881 - J. J. Smith

363 - 04