

363
08



Handwritten notes:
New Mt. Zeehan
Jan 1890



PLAN OF UNDERGROUND WORKS OF THE M^T ZEEHAN SILVER LEAD MINING CO LIM^{TD}

Scale 30 feet to One Inch

SILVER QUEEN P. A.
M^T ZEEHAN S. L. M^S CO.

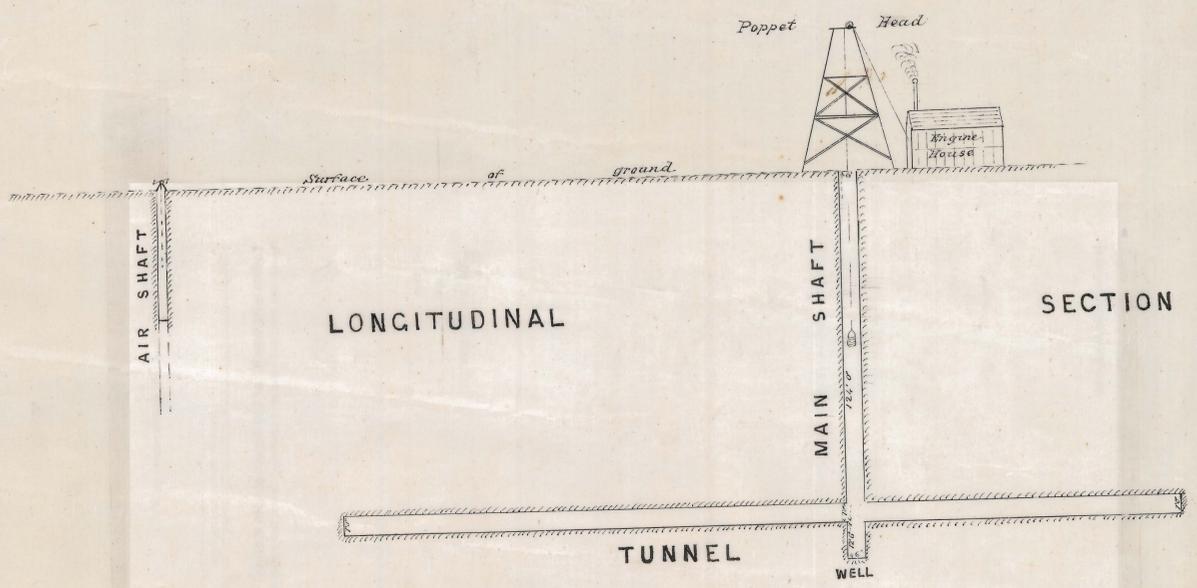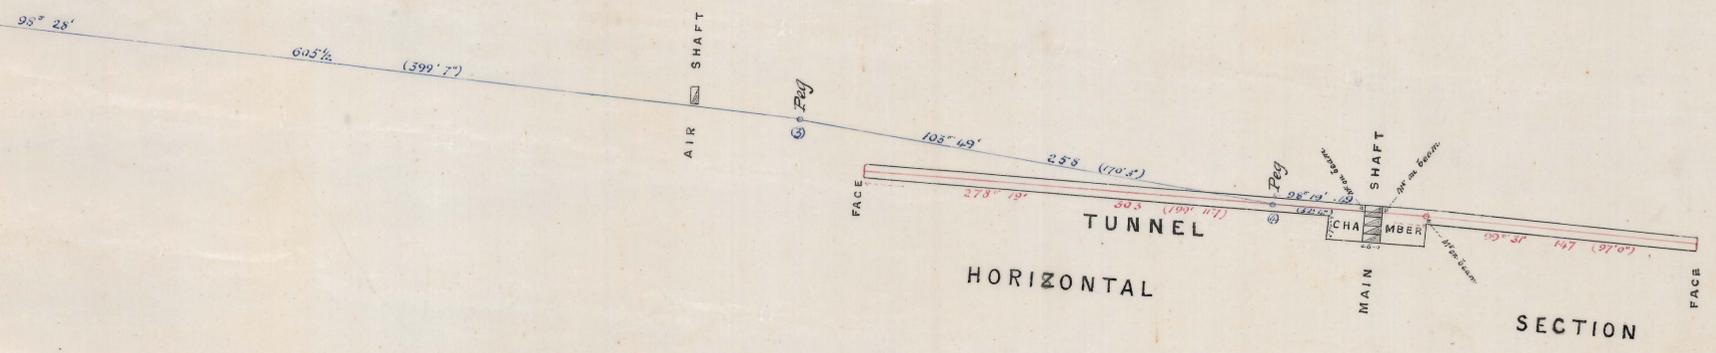

Handwritten signature:
C. J. Colston
Authorized Surveyor
Mt. Zeehan
24th January 1890

363
08