


363  
10

5 cm

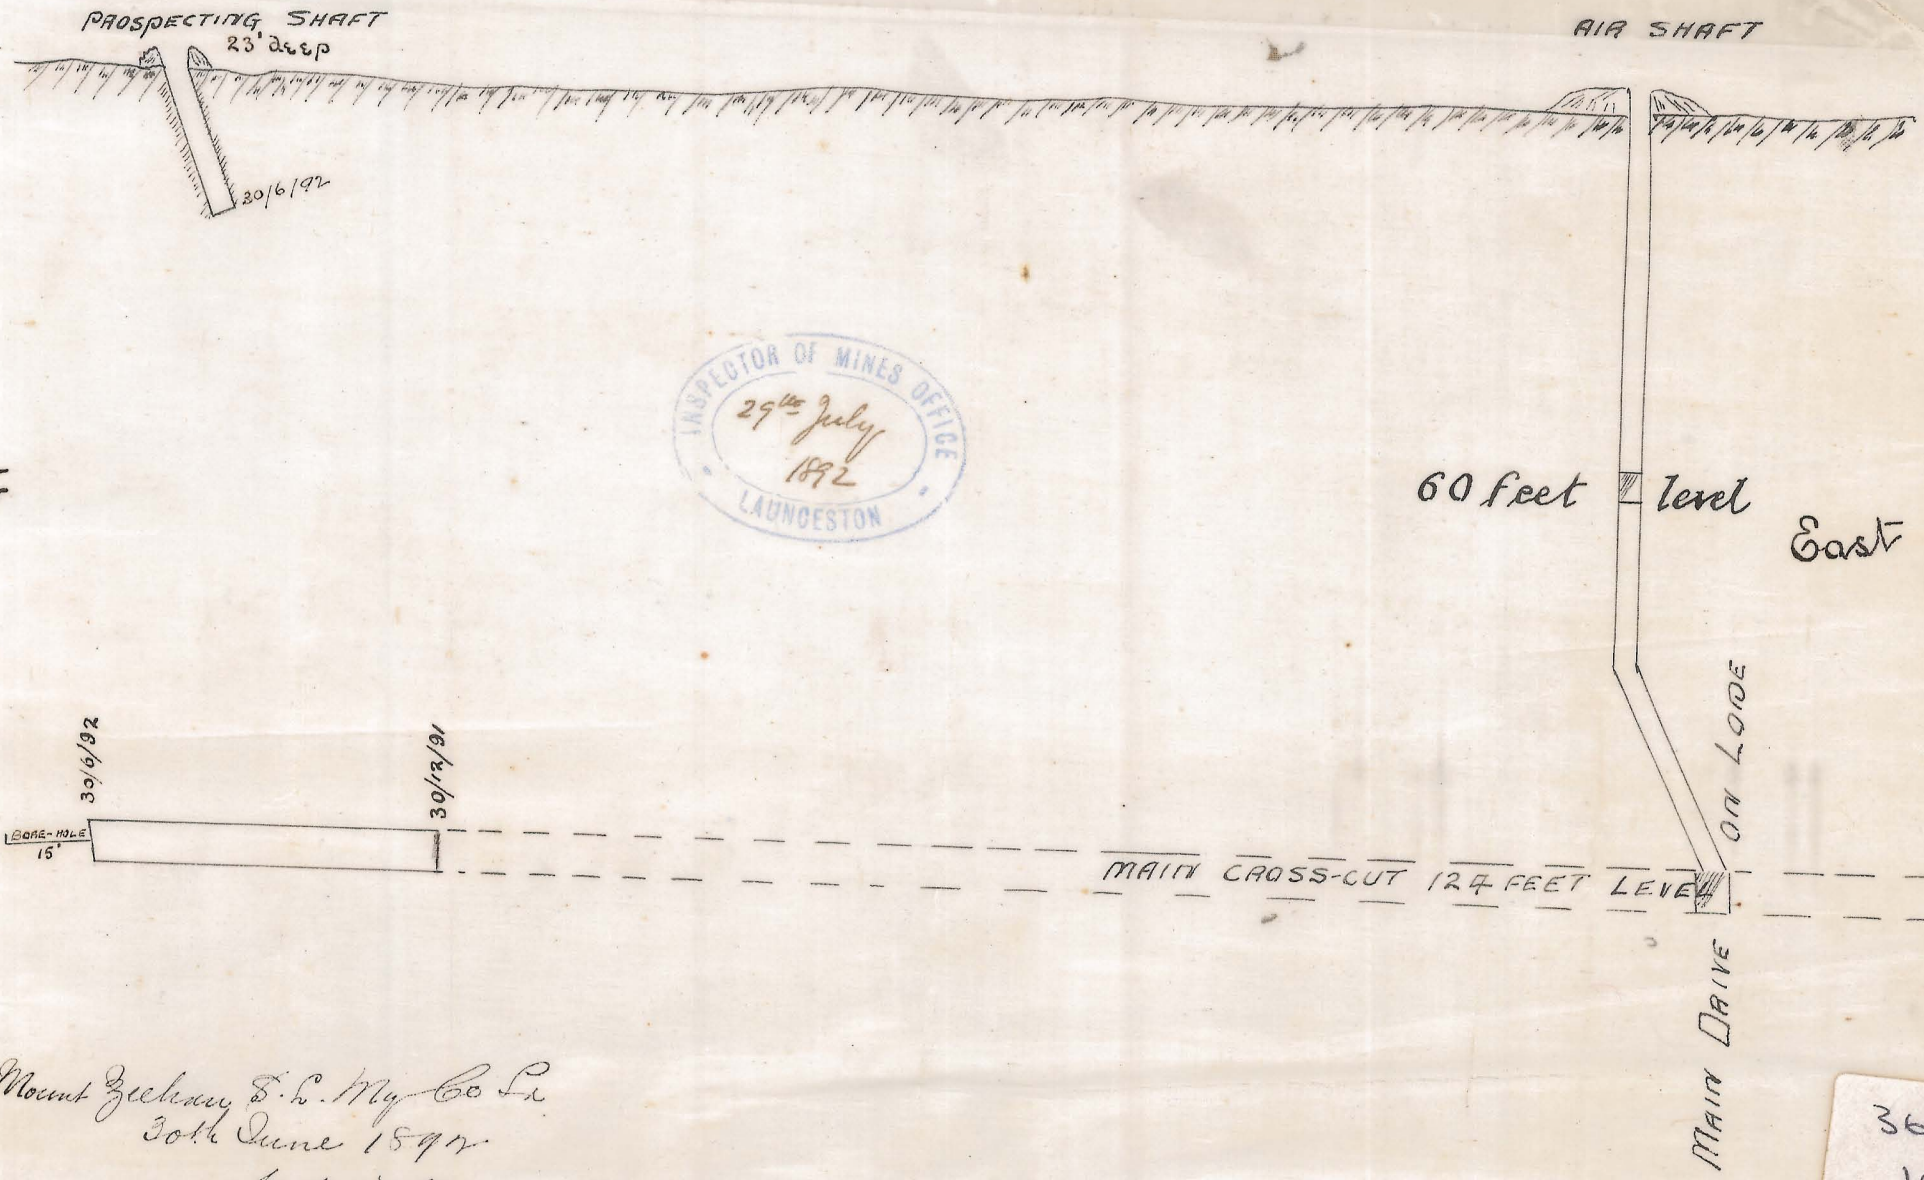

West

Mount Zeehan S. L. M. Co. Ld.  
30th June 1892  
W. H. Westley

363  
10