

NEW MOUNT ZEEHAN M.C.

363/15


Scale 30ft = 1 Inch

J. Briggs, Mining Manager Jan 20th 1900




LONGITUDINAL SECTION

N° 2 Lode W

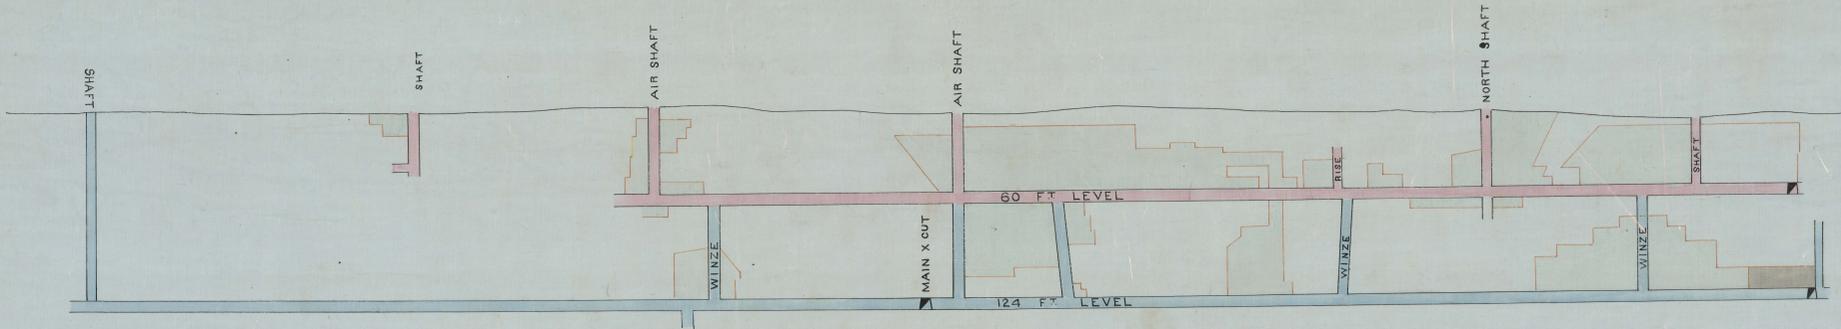


TRANSVERSE SECTION

N° 2 Lode W

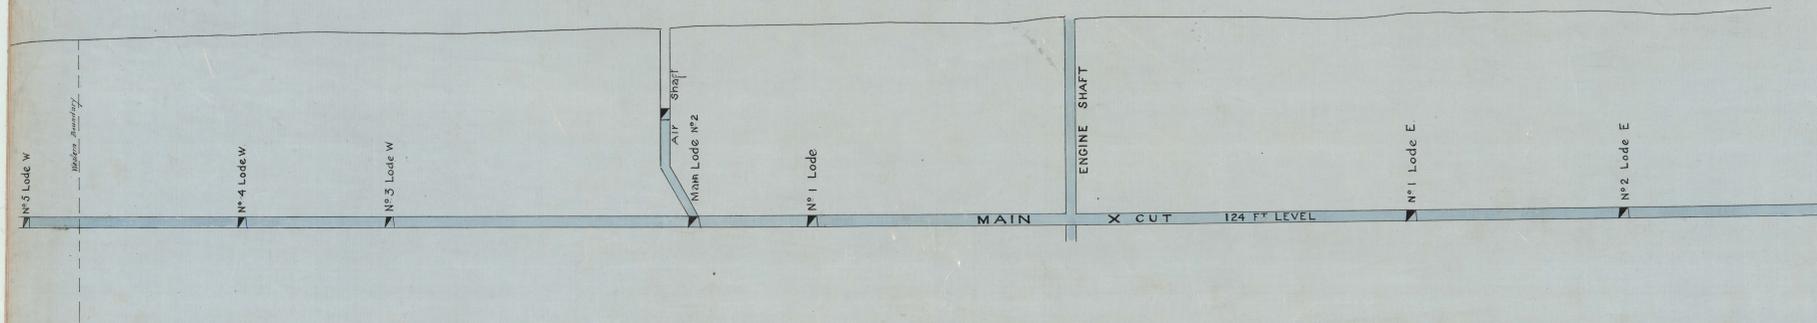


N° 1 Lode E

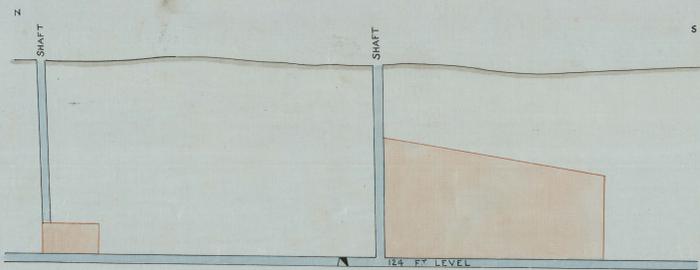

N° 3 Lode W



 N° 4 Lode W



Reference to Longitudinal sections

□ Stopping done to Dec 31st 1898

□ from Dec 31st 1898 to Dec 31st 1899