
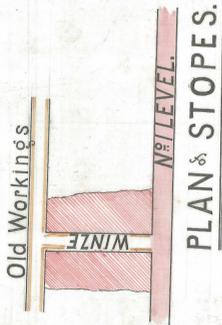


PLAN

OCEANA MINING CO^Y

Scale 20 feet to an inch.

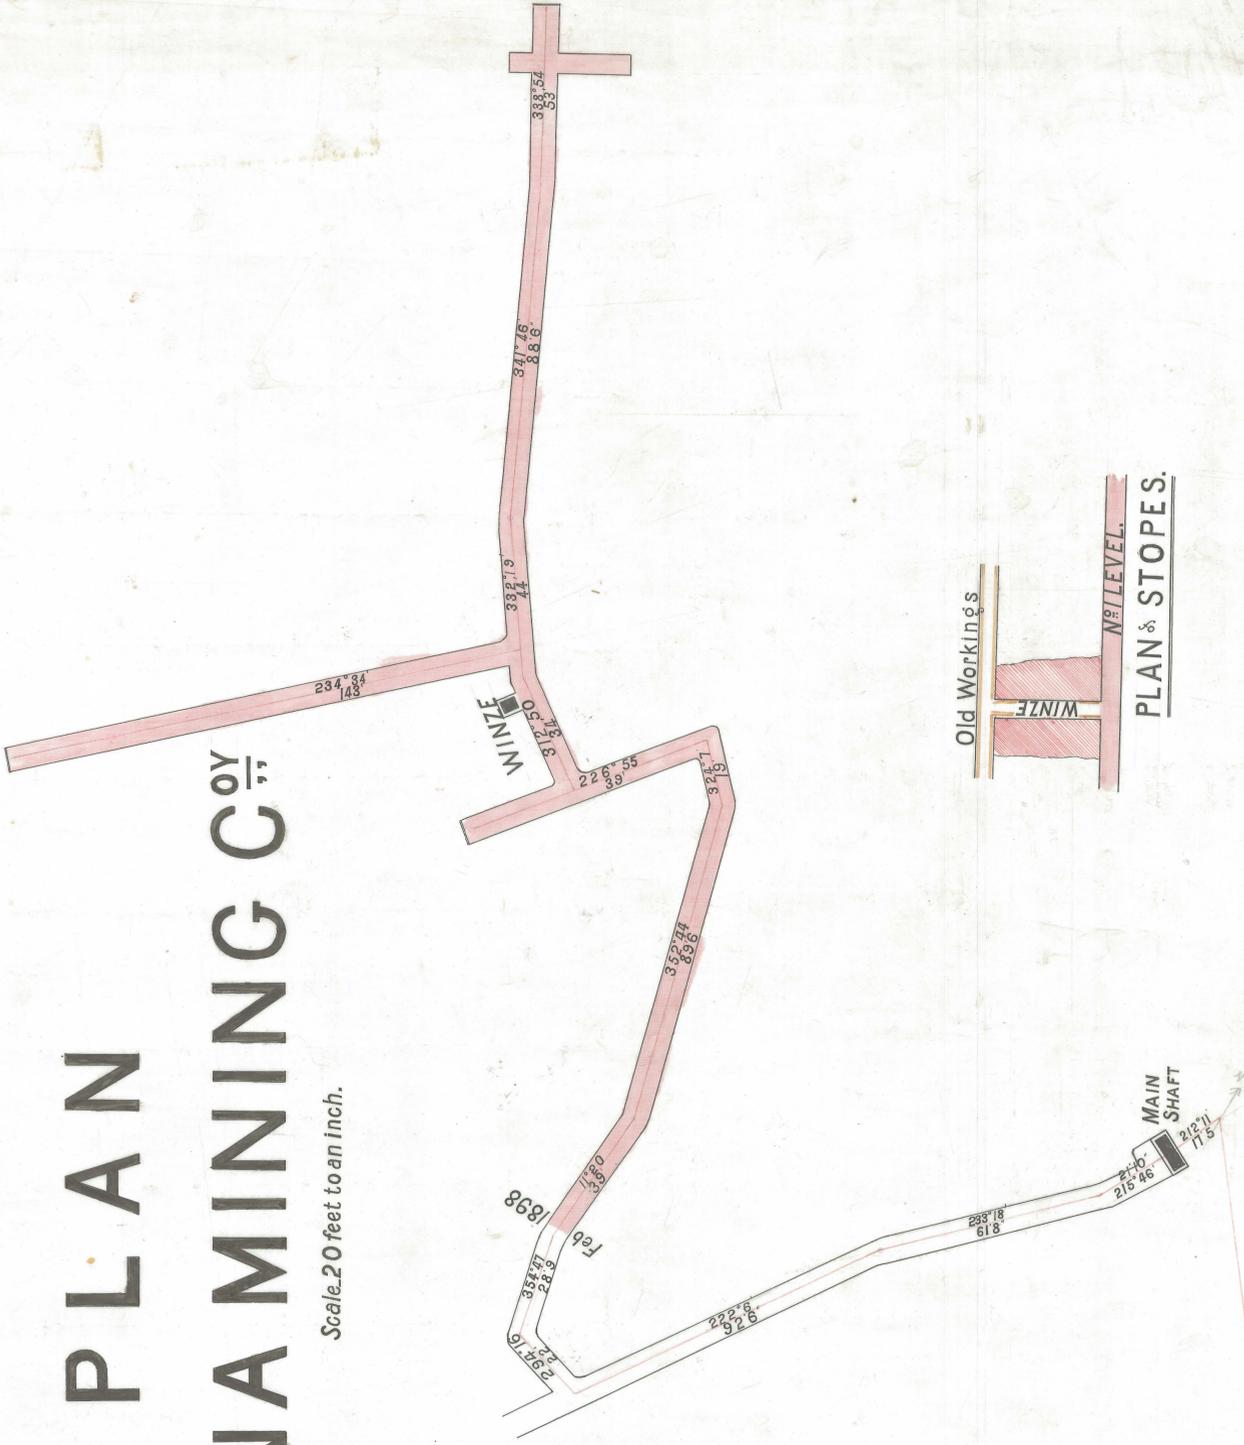


320
93 M

330° 16' 30"
409'

DATUM
360° 00'

Instrument used, Sine theodolite.

March 11th 1899

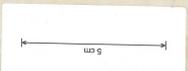

364
03