

364
21

2005

150 S

100 S


50 S

00

50 N


100 N

Ht of Back on W side 29'
Ht of Fill 44'
2.10.56

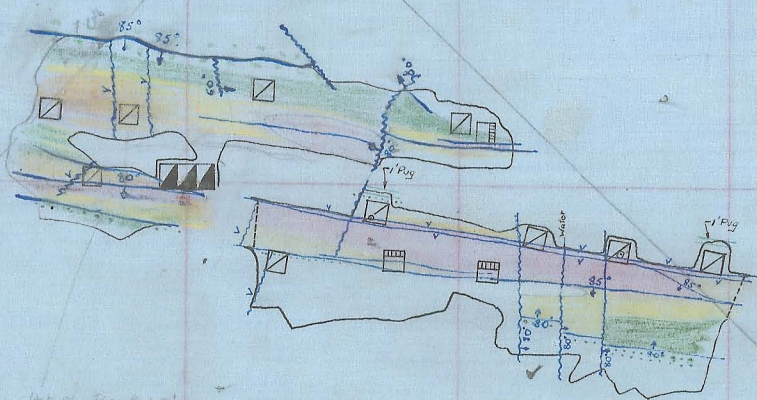

Ht of Back 37'
Ht of Fill 44'

Hgt of Back 31'
Hgt of Fill 26'

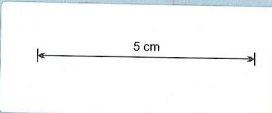

364
21