


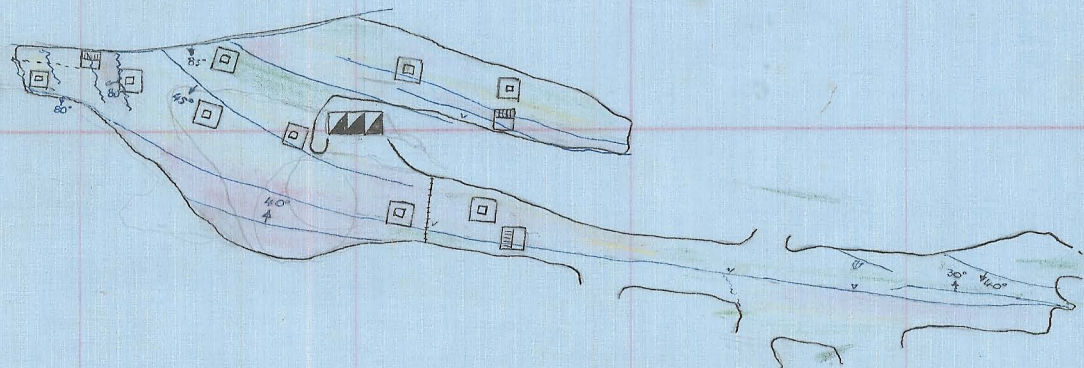

Back in W. slope & S. End 70'
Fill S. End 57'

Back E. Slope 75'
Fill E. Slope 69'

31.12.57

364
- 24