


21. 2.6% Grad
22. 2.6%
23. 10.7%
24. 3.7%

25. 17.3% Bulk 4 Tks.
26. 14.0% Bulk (6 Tks)
27. 6.5% Bulk
28. 13.9% Bulk (20 Tks)
Previous Cut over.

5 cm

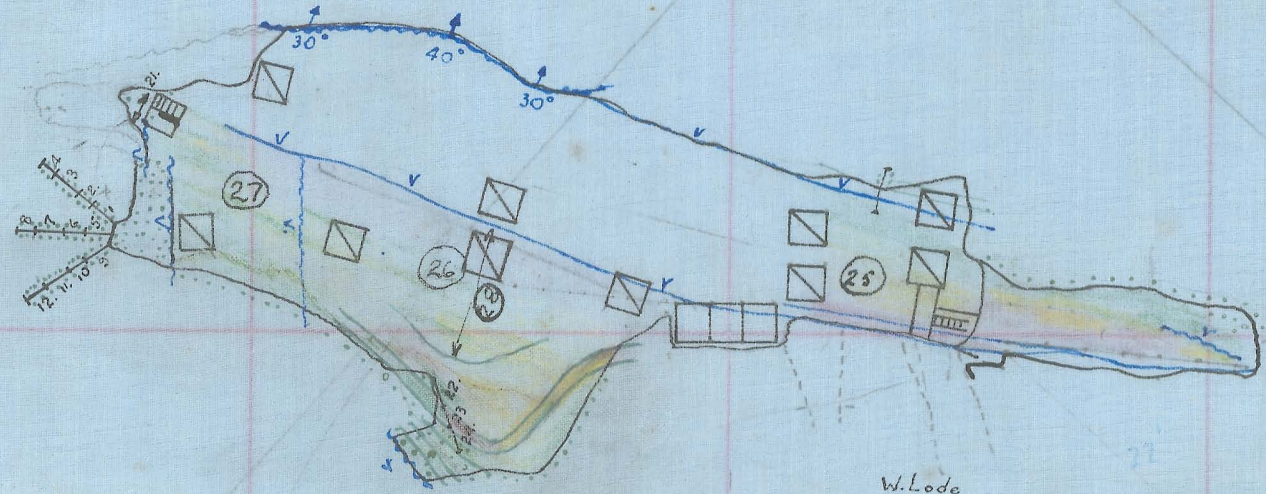

Vertical Shear & Major fault intersect
41 ft above Level.

W. Lode
above fault.

13. Trace
14. Trace
15. 2%
16. 6.0%
17. 6.0%
18. 3.0%
19. Trace
20. Trace

1. Trace
2. Trace
3. Trace
4. Trace
5. Trace
6. Trace
7. Trace
8. Trace
9. Trace
10. Trace
11. Trace
12. Trace

By
Washing.

Height of fill 30 ft.

Height of back 36 ft.
Height of back at fault 41 ft

300' Level

30' Contour.

364
25