

364
37




NO. 3 LEVEL

ZEEHAN MINES PTY. LTD.

OCEANA

SCALE 1" : 40'

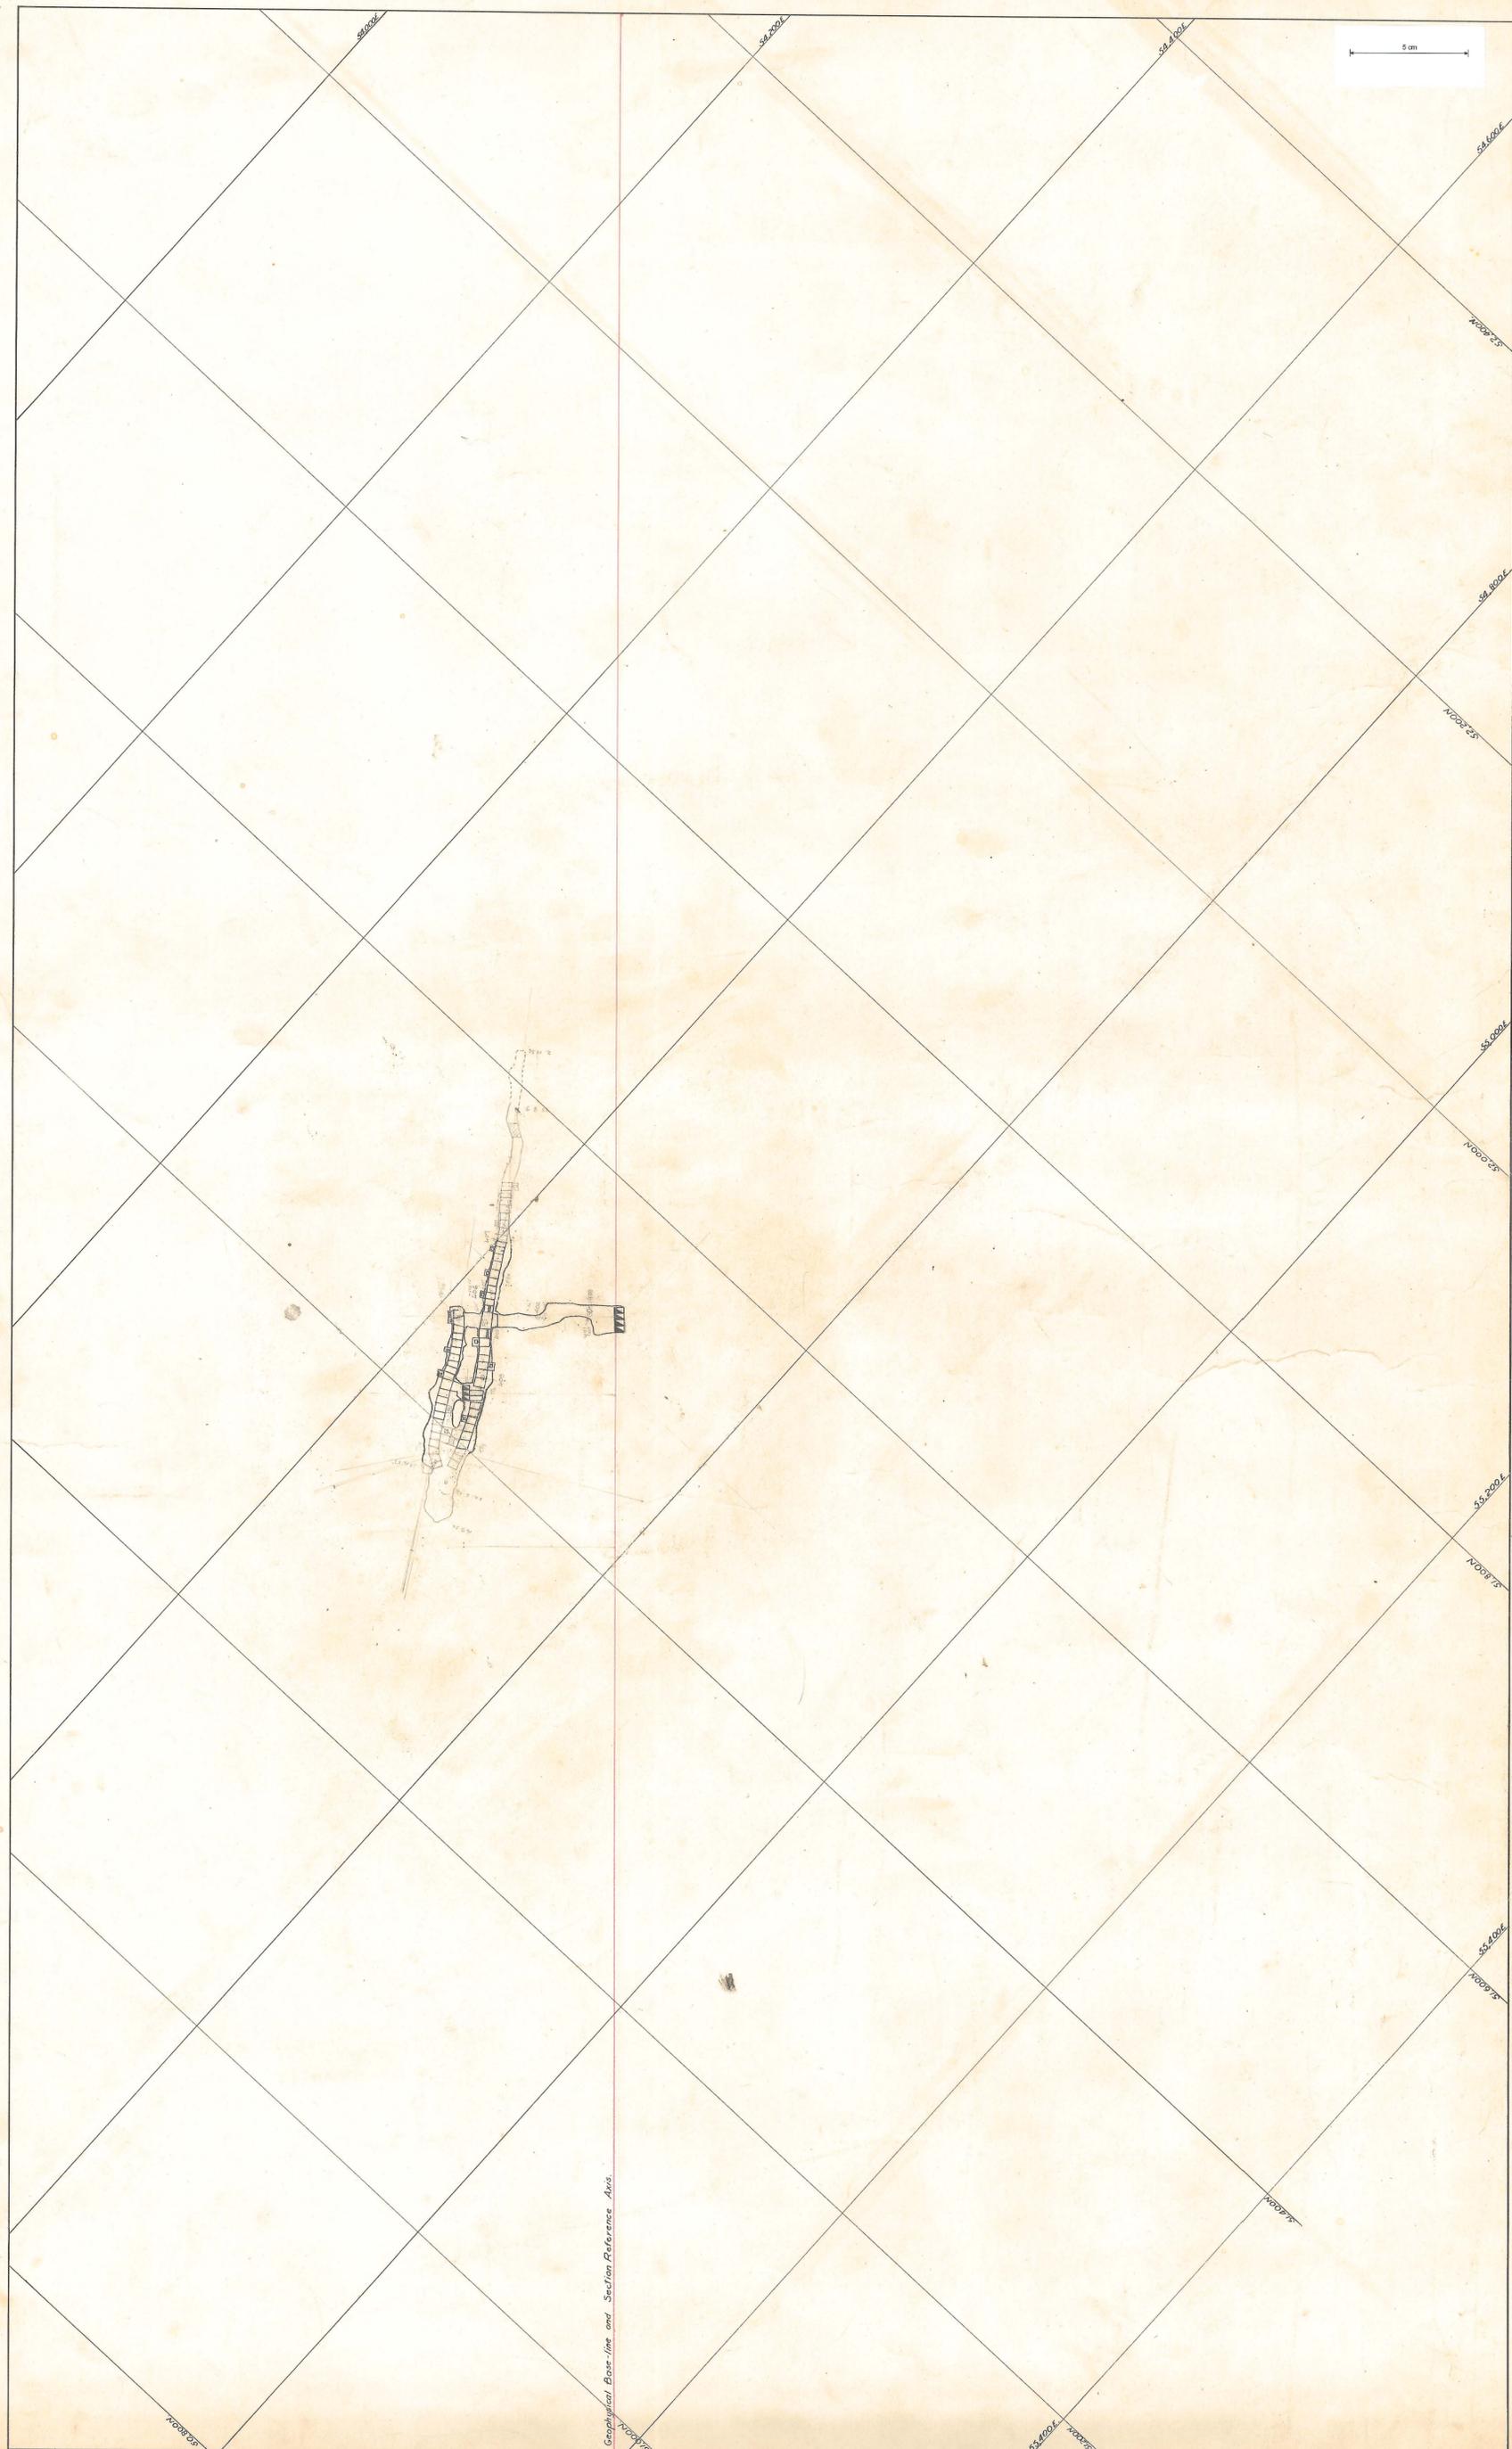

Geophysical Baseline and Section Reference Axis

364
37