
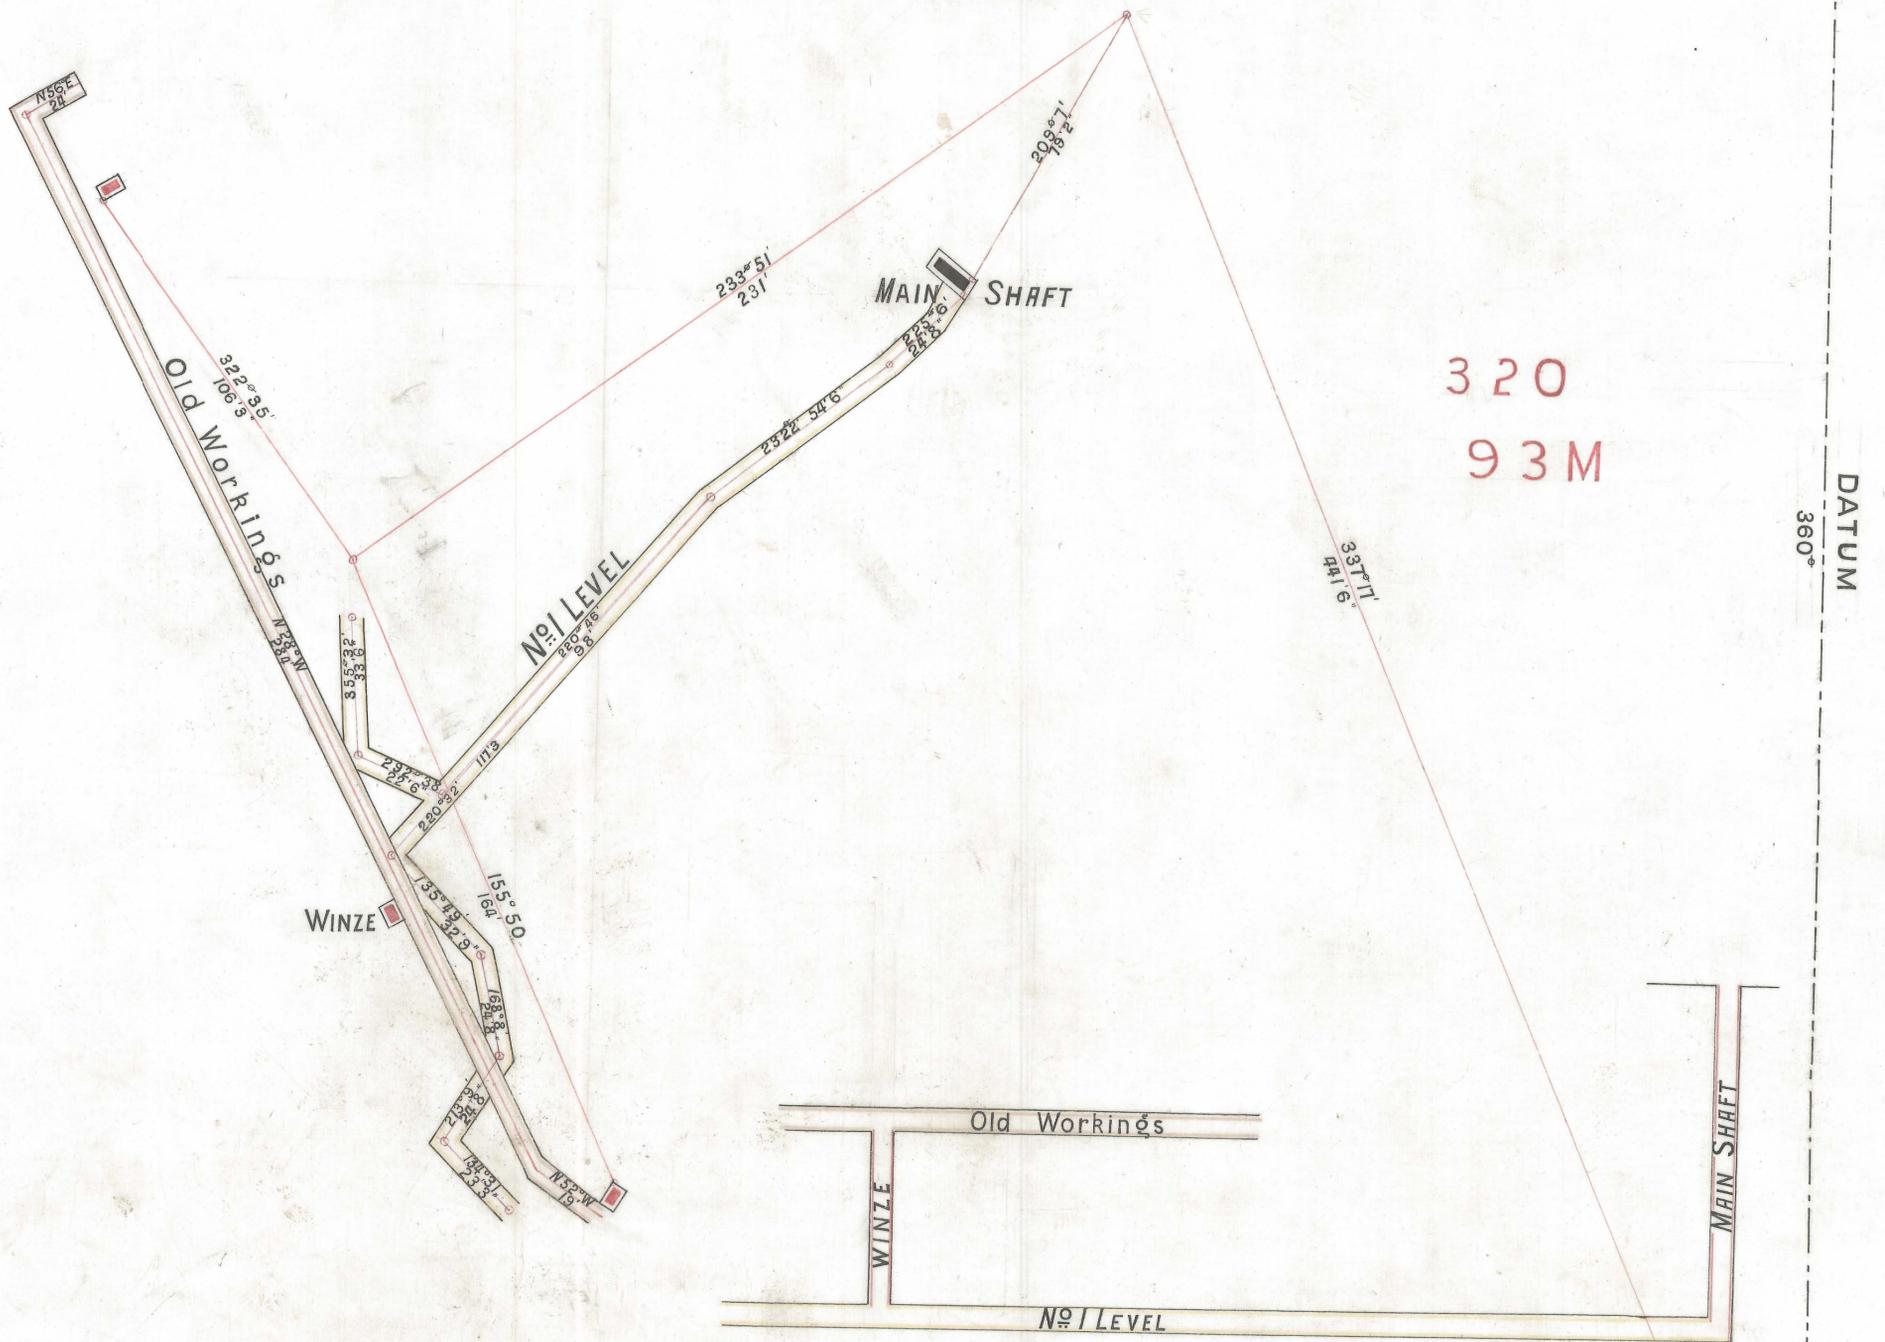


# PLAN OCEANA MINING CO<sub>Y</sub>

NO LIABILITY.

Scale 25 feet to an inch.

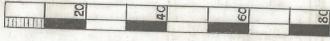

Malcolm Moore

Surveyor to the Company  
Feby. 1898.

Harry Daniel  
Mine Manager 26/2/98