


405-161
165-174


620
140

R.L. 595 + 115.1
44°

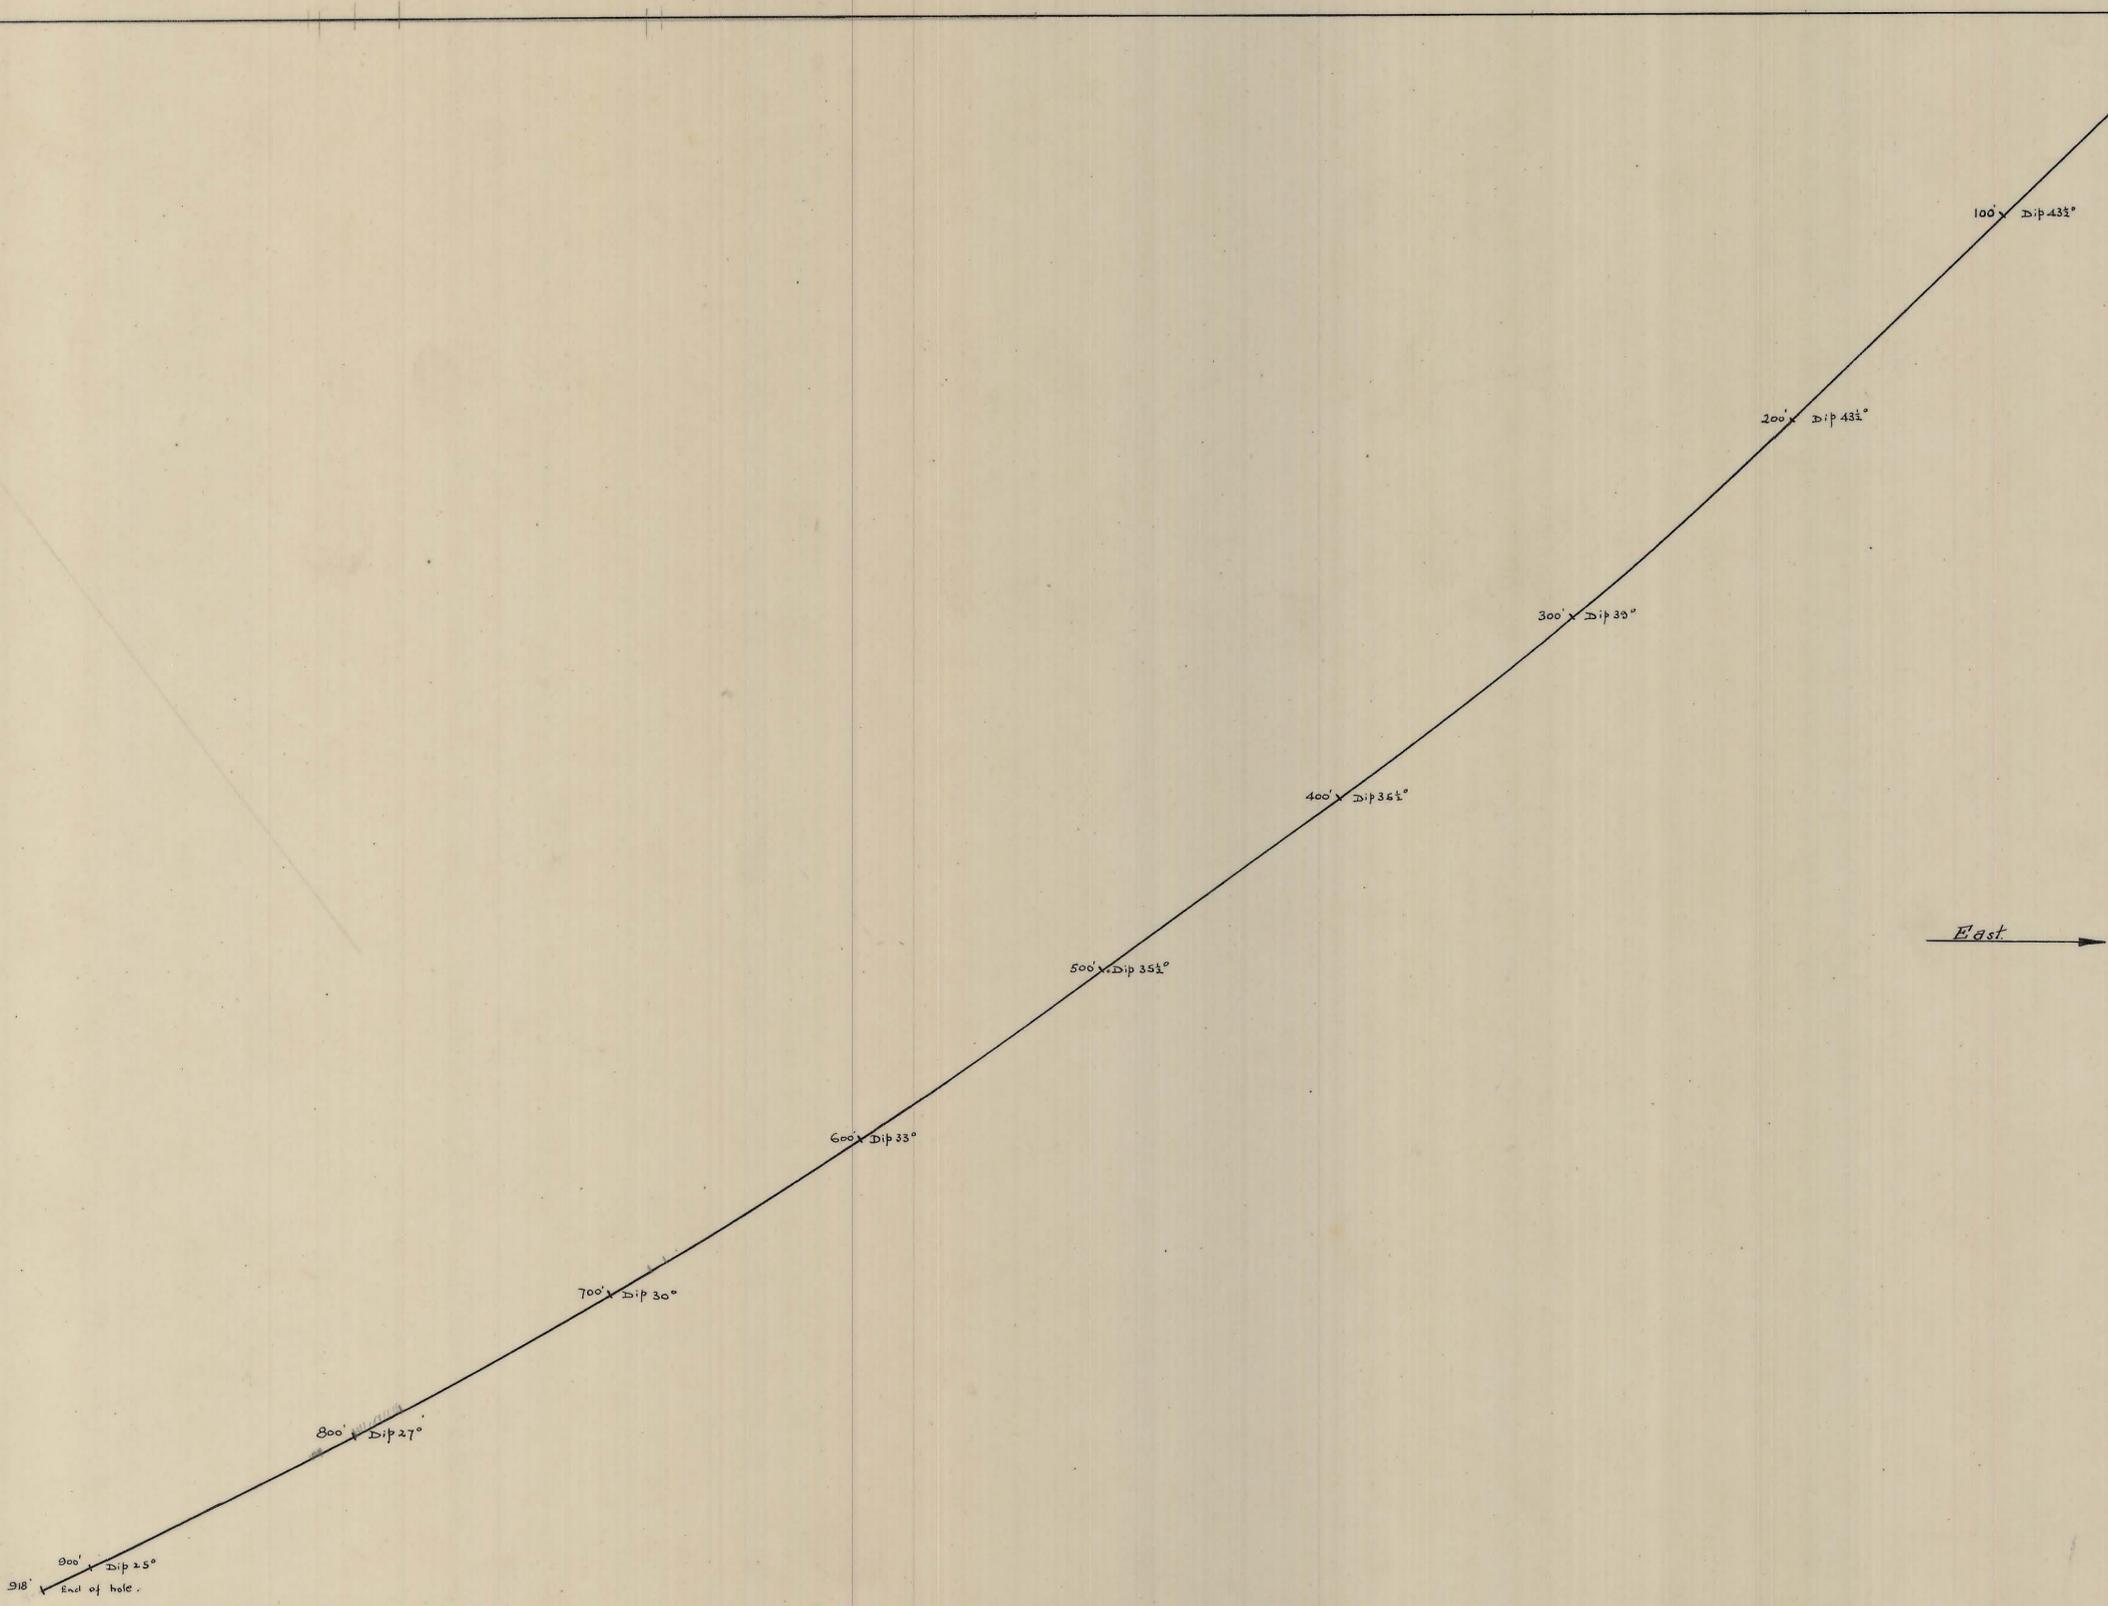

ZEEHAN EXPLORATIONS
OCEANA MINE
D.D. N° 64.

TRUE SECTION ON PLANE OF BORE-HOLE.
Scale: One Inch equals Forty Feet. 1" = 40'

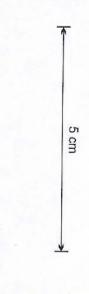

0364_073