


0364-076

HOLE No. 1

Oceana Mine - Depth 316 feet - Depressed 42 Degrees - Bearing 225° Mag.

From	To	Brief Description	From	To	Ft	%Pb.	OzAg	%Zn
0	14	No Core	148	161½	13½	2.3	0.9	0.9
14	157½	Shales and Mudstone	161½	171½	10	2.7	0.6	0.6
157½	178	Mineralised Gossan	171½	178	6½	5.3	1.0	0.7
178	182	Fragments Mineralised Gossan						
182	201	Mineralised Gossan	182	201	19	5.0	0.8	0.6
201	215	Gossan						
215	316	Shales and Mudstone	223	233	10	3.6	0.6	1.2
			233	244	11	4.8	1.2	1.0
			305½	316	10½	0.5	0.3	1.7

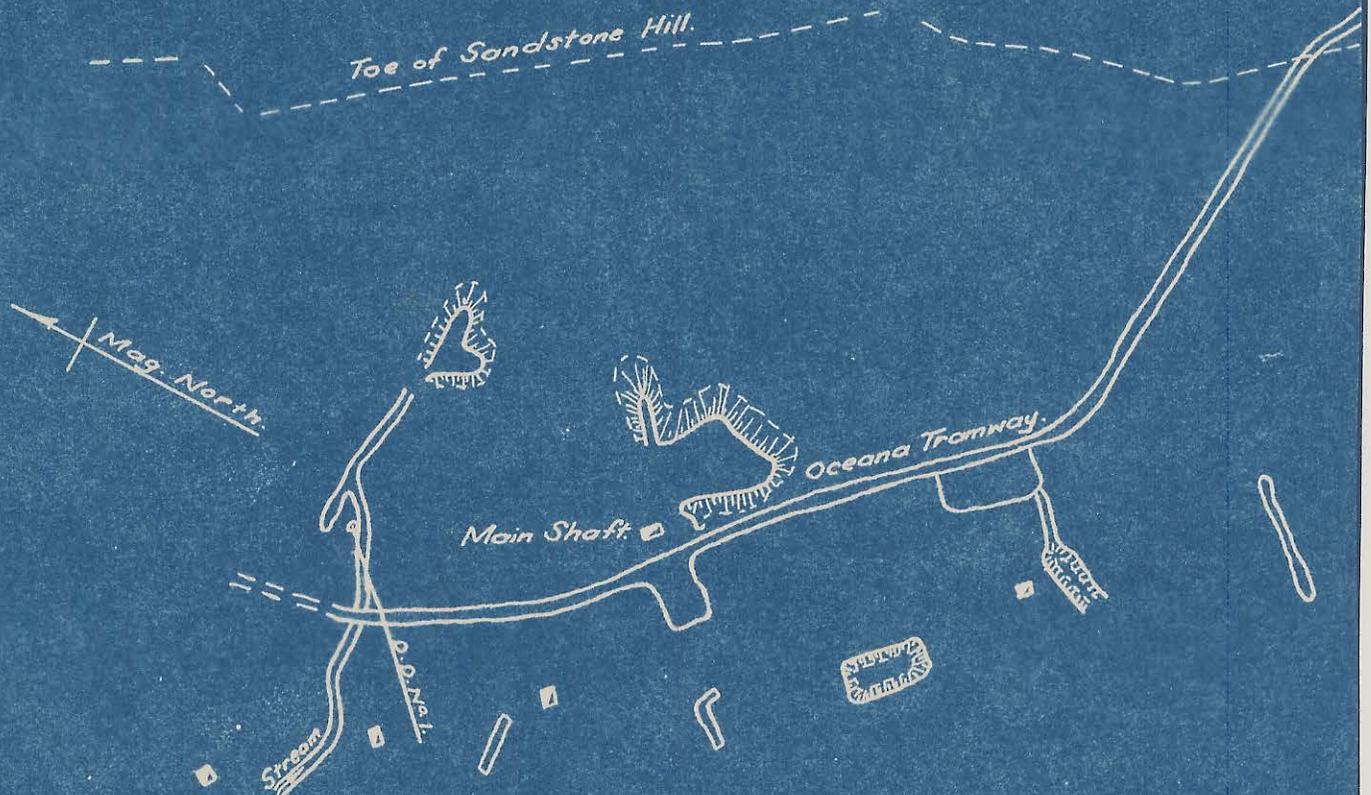

5 cm