



THE ZEEHAN-MONTANA LIMITED

LIMITED

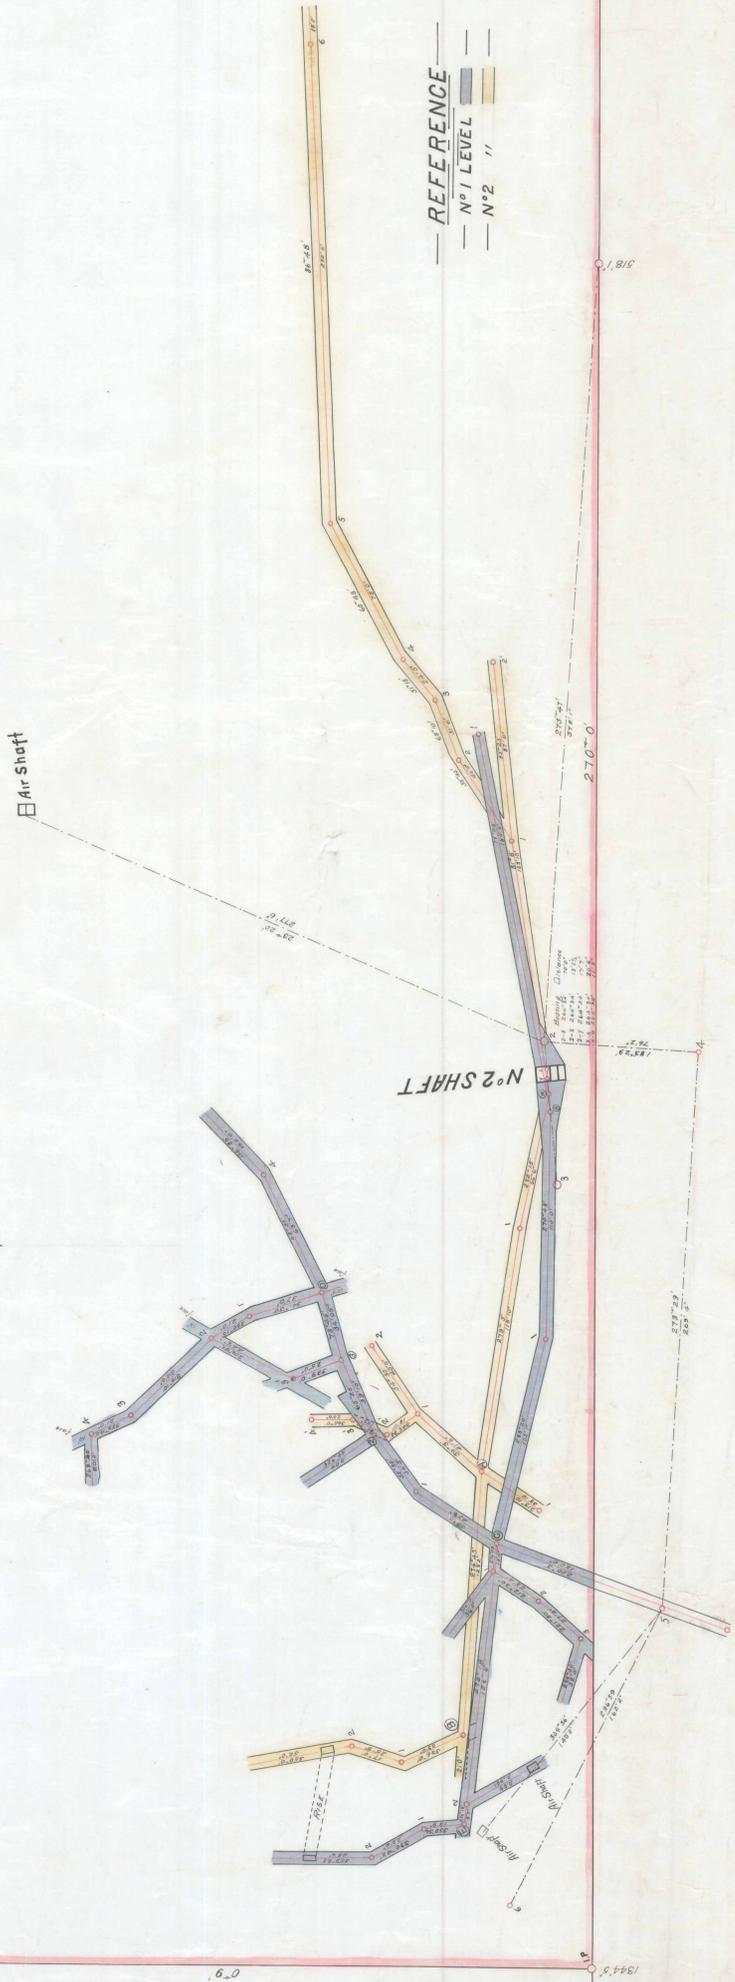

1636 M
Alroy
MANAGER

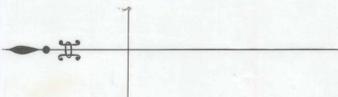

366
01

366
- 01