

THE

ZEEHAN — MONTANA LTD

Nº 2 SHAFT




SCALE



Scale 30 feet



1636 M

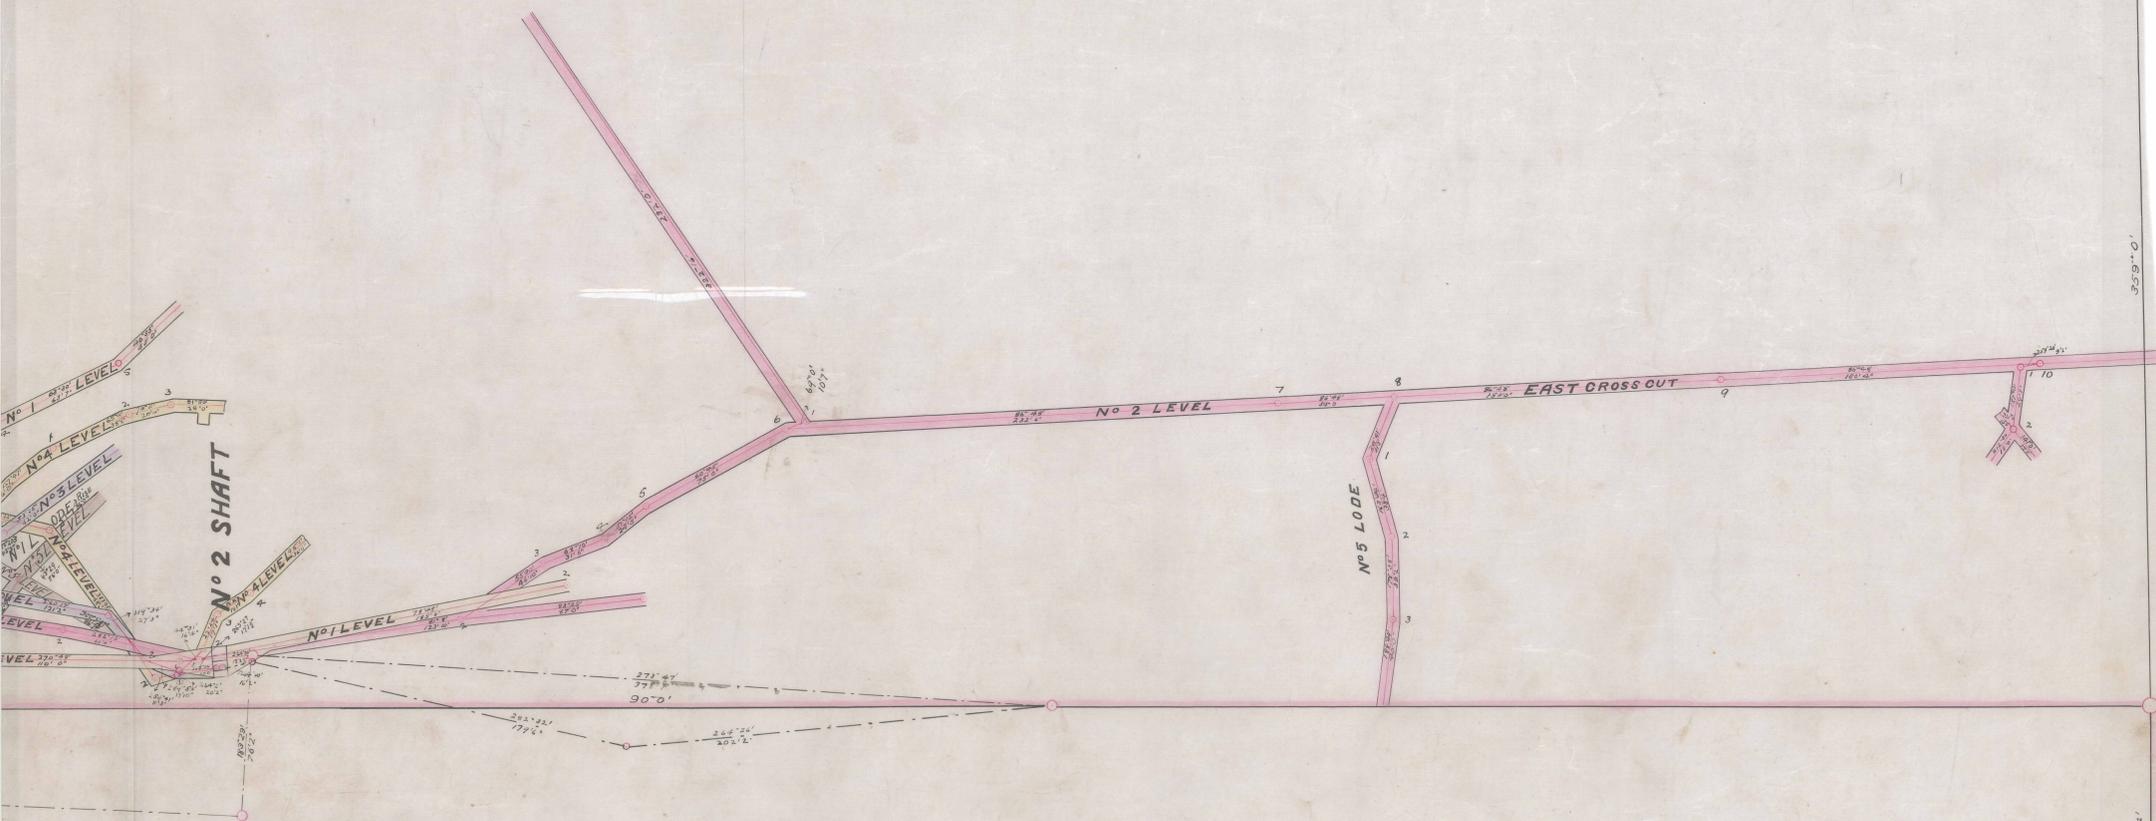

IMITED

REFERENCE

- Nº 1 LEVEL —
- Nº 2 LEVEL —
- Nº 3 LEVEL —
- Nº 4 LEVEL —
- Nº 5 LEVEL —
- TUNNEL —

J. Craig
MANAGER

J. Craig 31. Dec 1907
J. Craig 31. Dec 1908
J. Craig 31. Dec 1909
J. Craig 31. Dec 1910