


NA

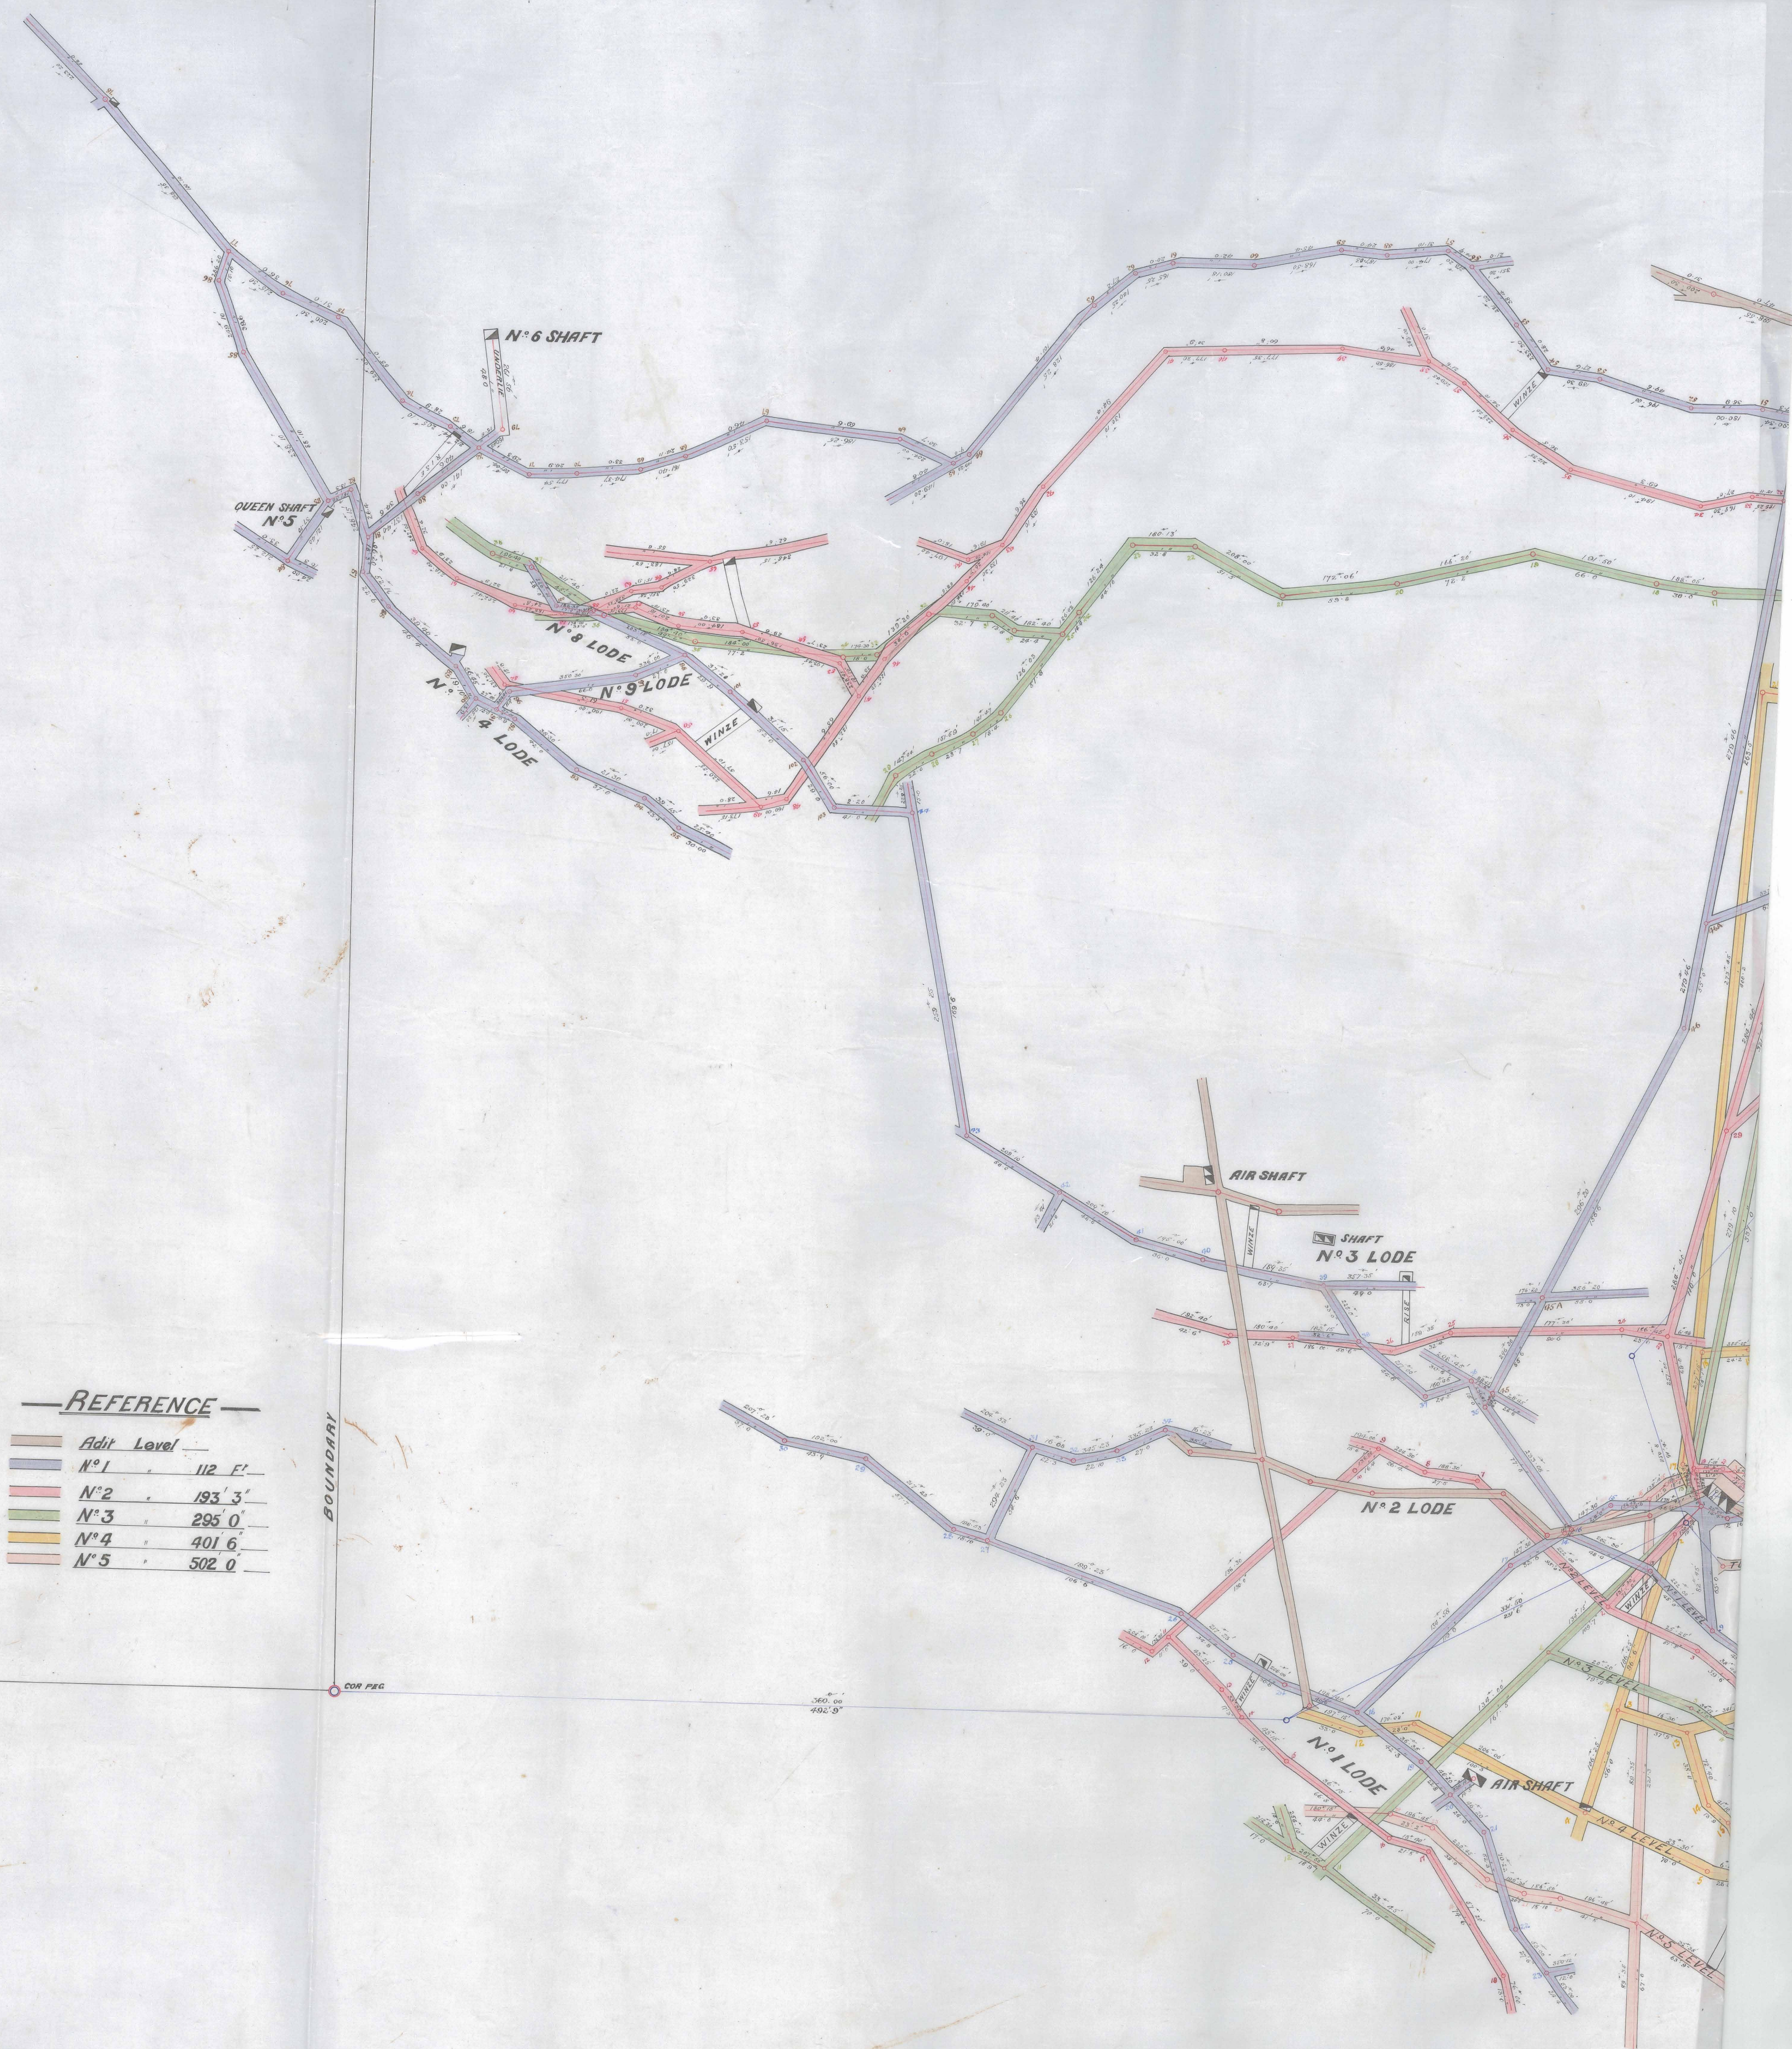

REFERENCE	
Adit Level	
N° 1	112 F'
N° 2	193' 3"
N° 3	295' 0"
N° 4	401' 6"
N° 5	502' 0"

BOUNDARY

COR REC

350.00

492.9'