




SECTION. of N°1. LODE

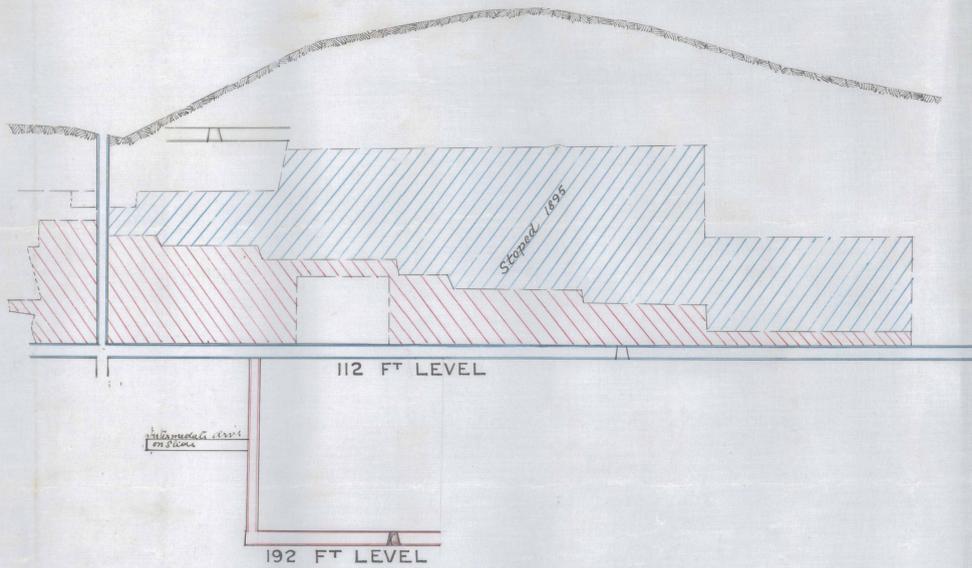

SECTION. N°4 LODE

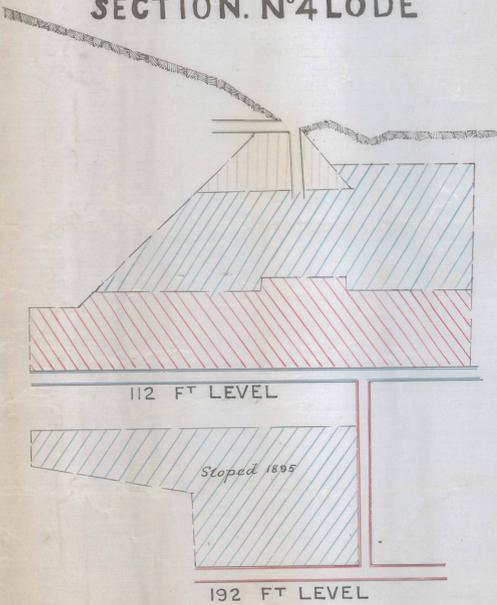

SECTION. of N°2. LODE

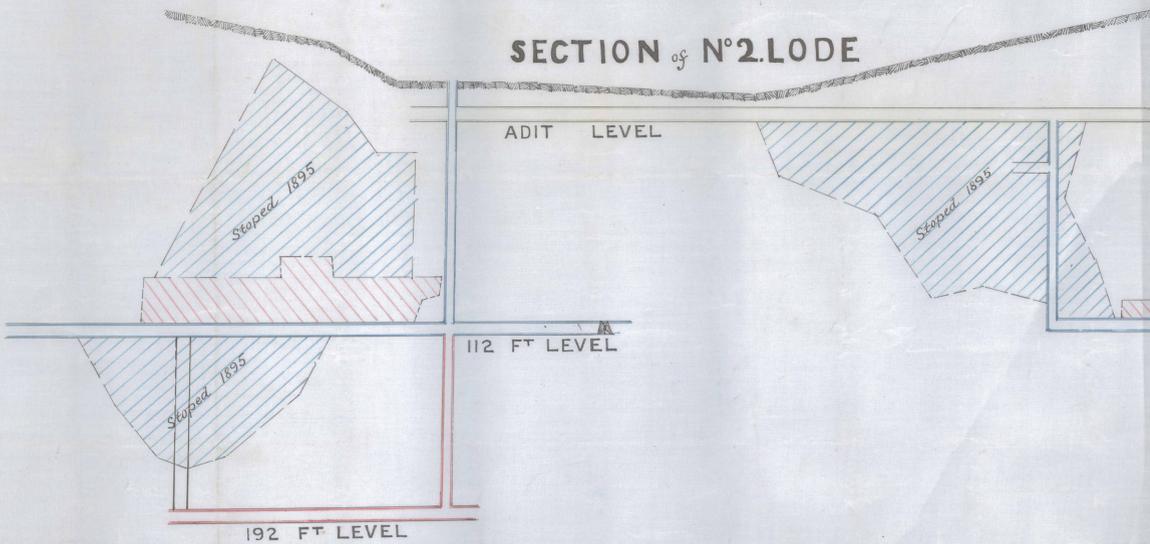

3081