

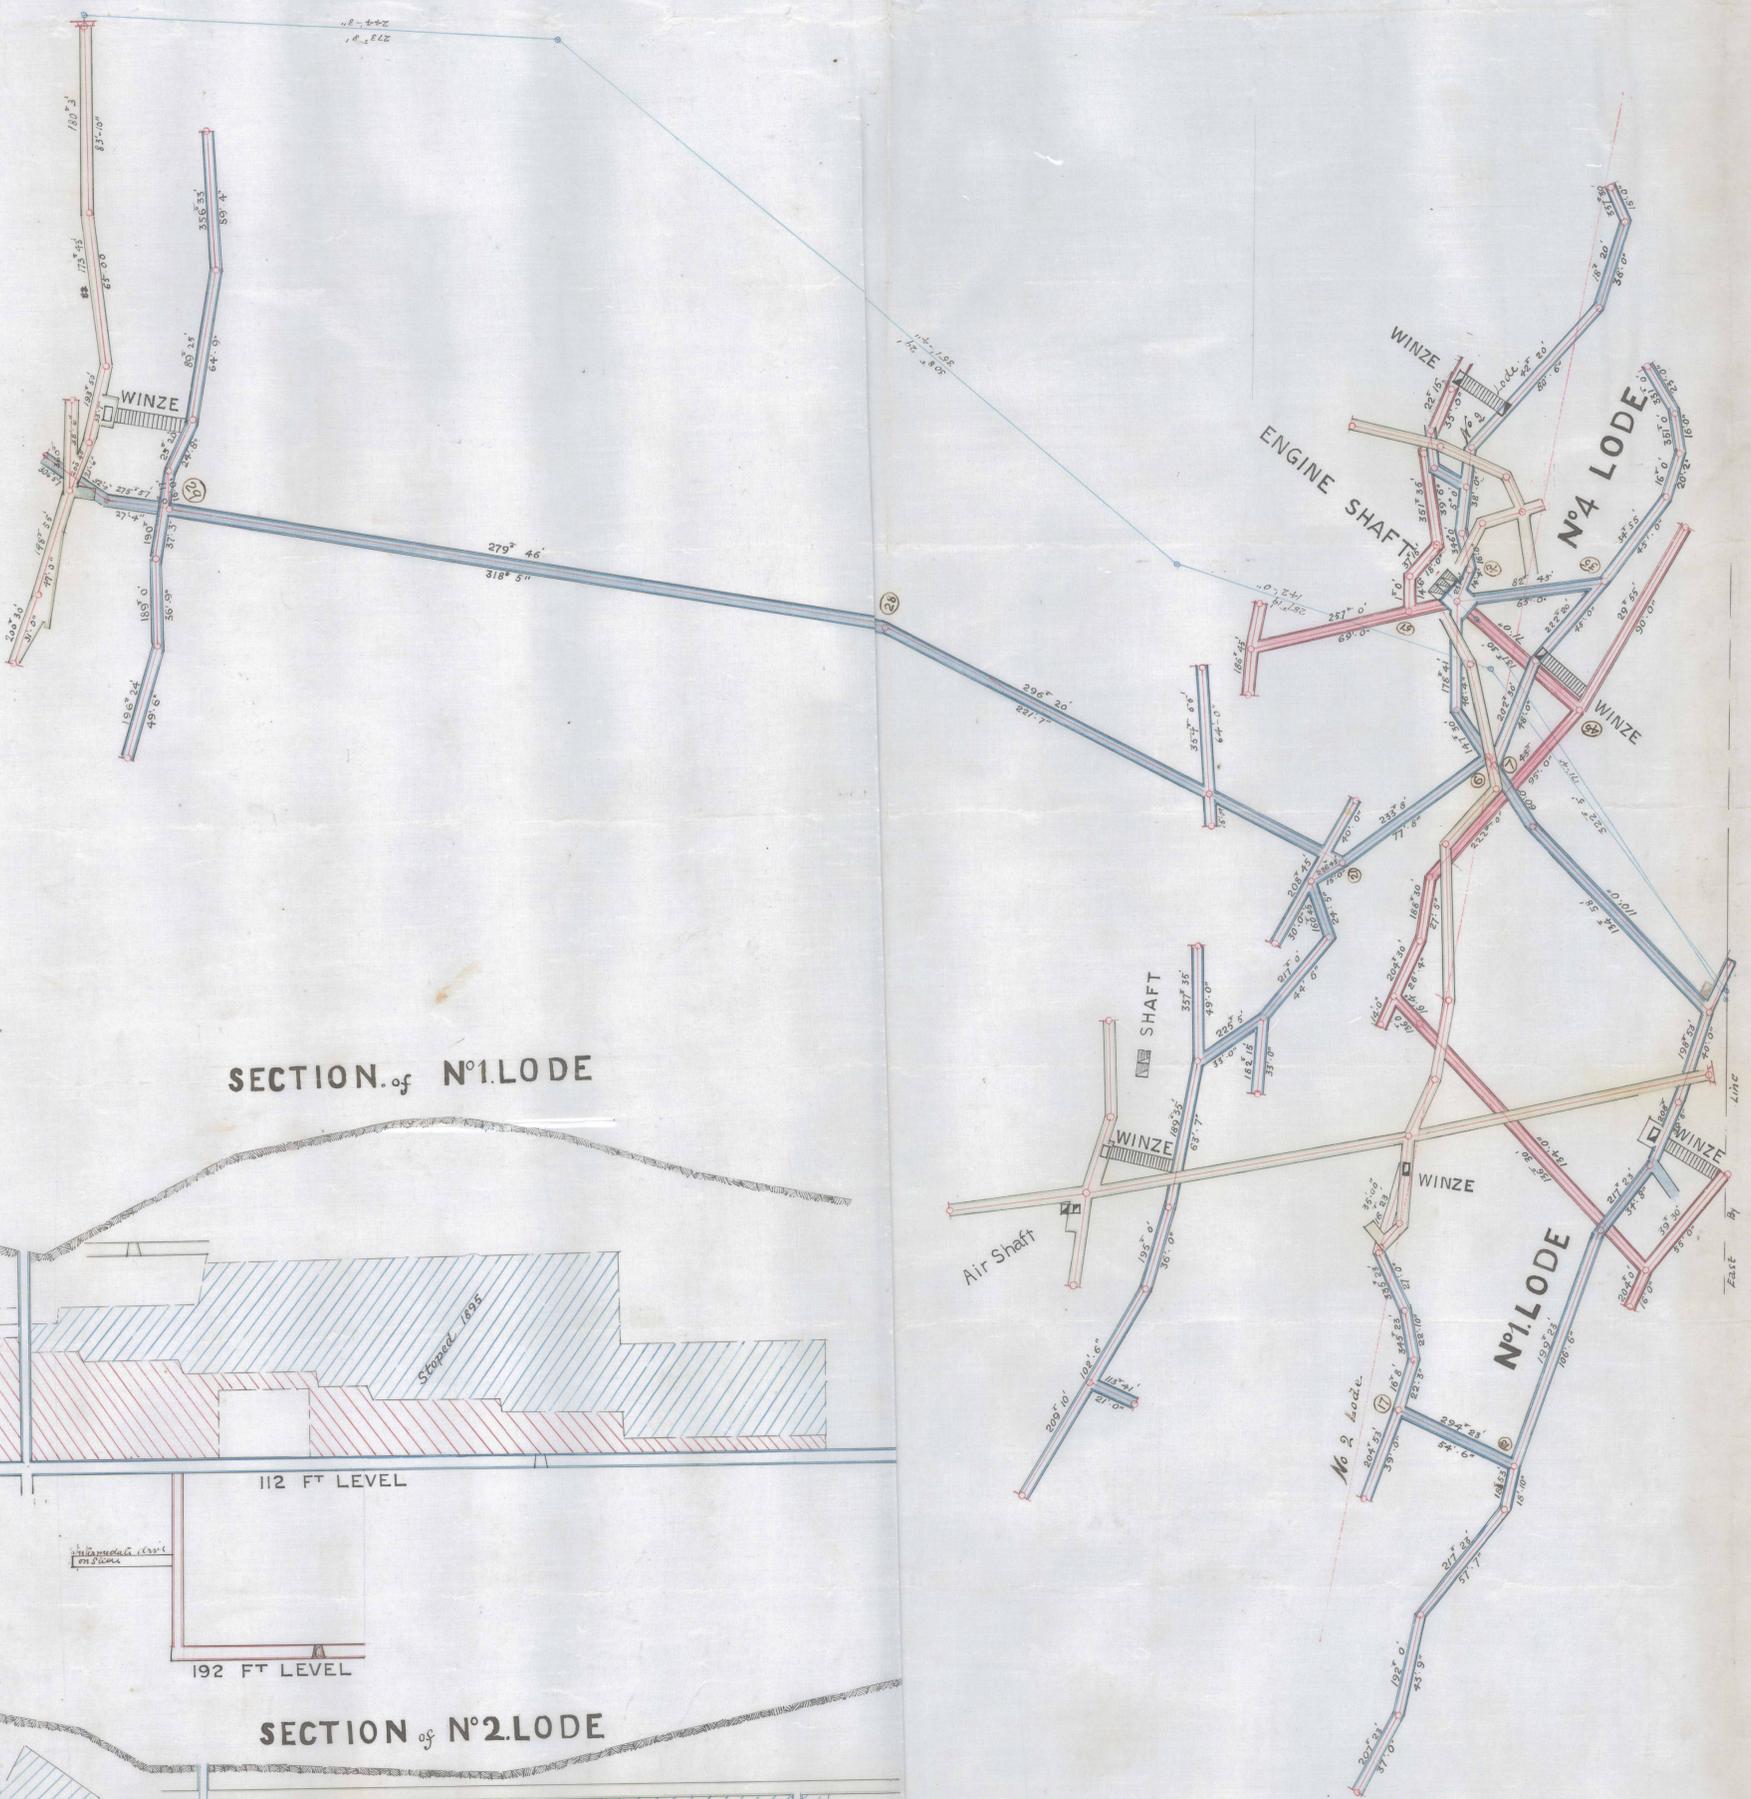



ZEEHAN-MONTANA

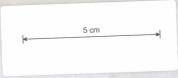

SECTION of Nº 1 LODE

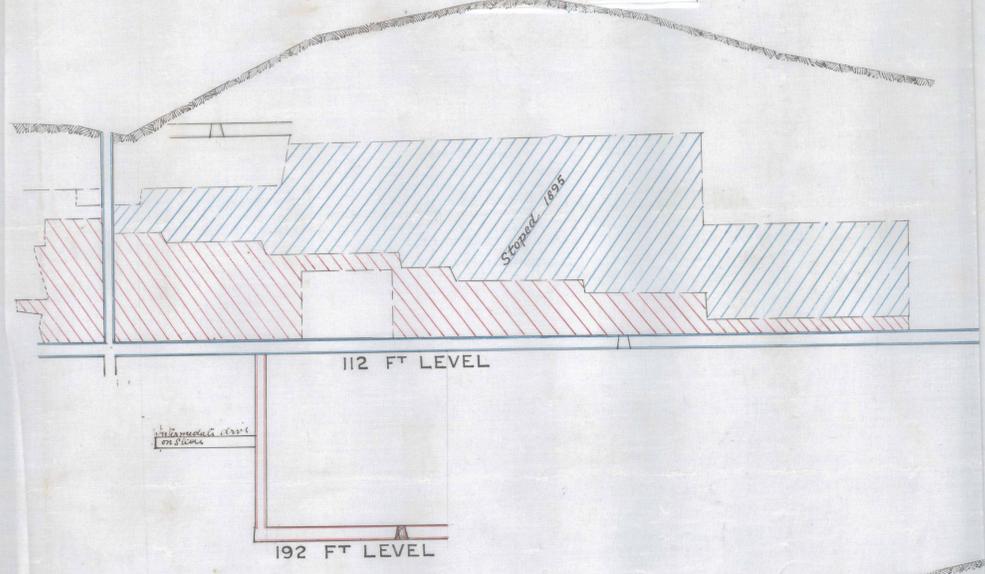

SECTION of Nº 2 LODE

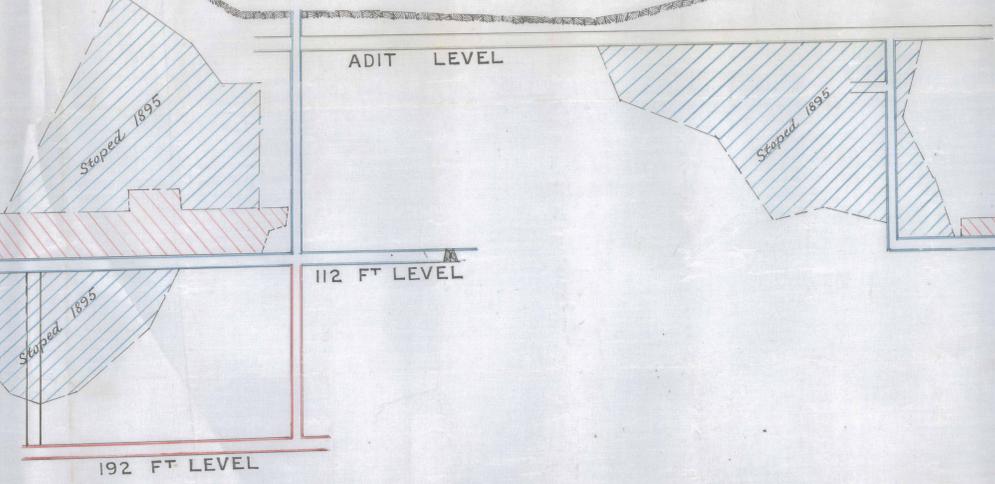

24th March 1896

C. Colver
Del. Zeehan
Jan '96

399 12 30