



# ZEEHAN-MONTANA S. M. MINING WORKS

Scale 30 feet to an inch


SECTION ON LODE N° 1

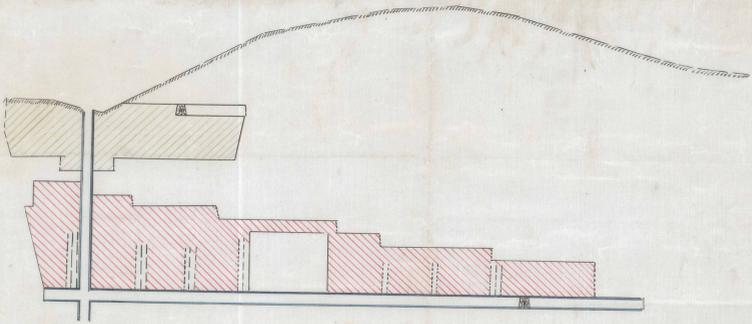


SECTION ON LODE N° 2

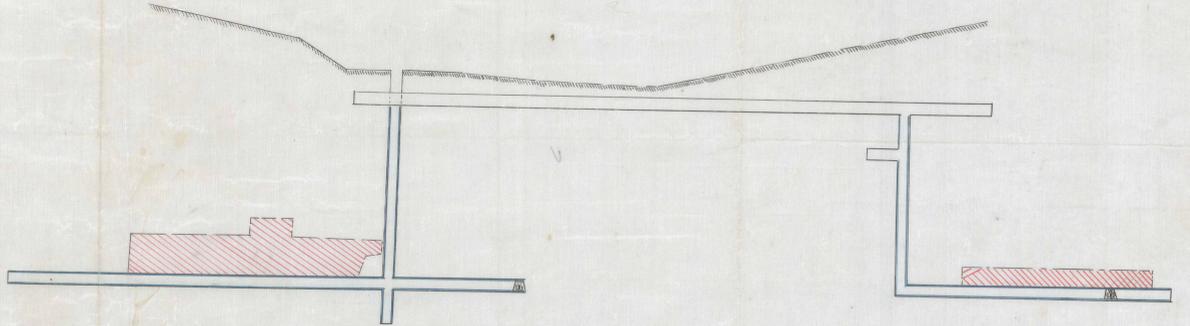


SECTION ON LINE A.B

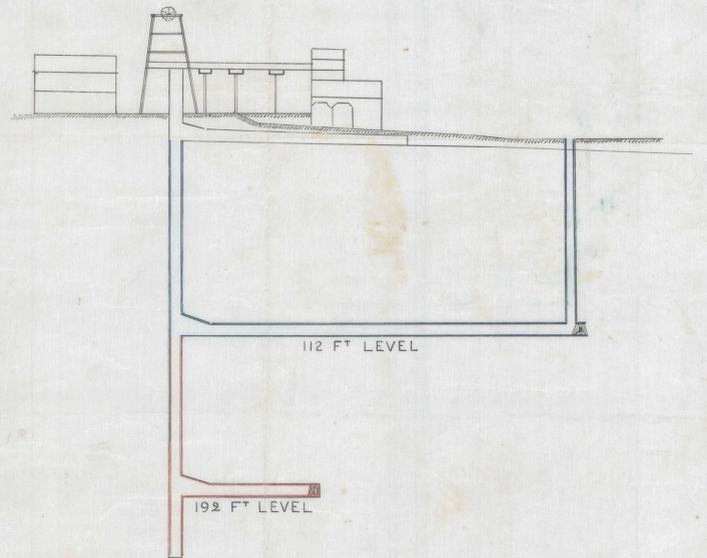

SECTION ON LODE N° 4

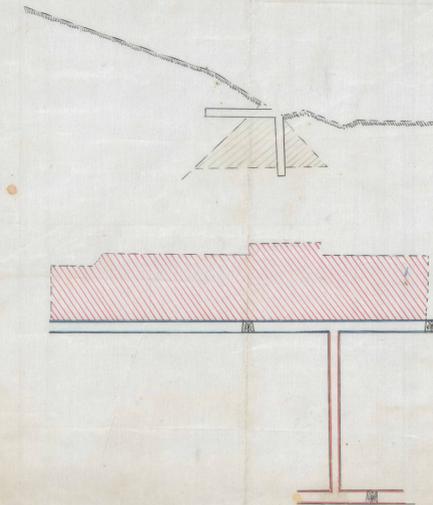

PLAN

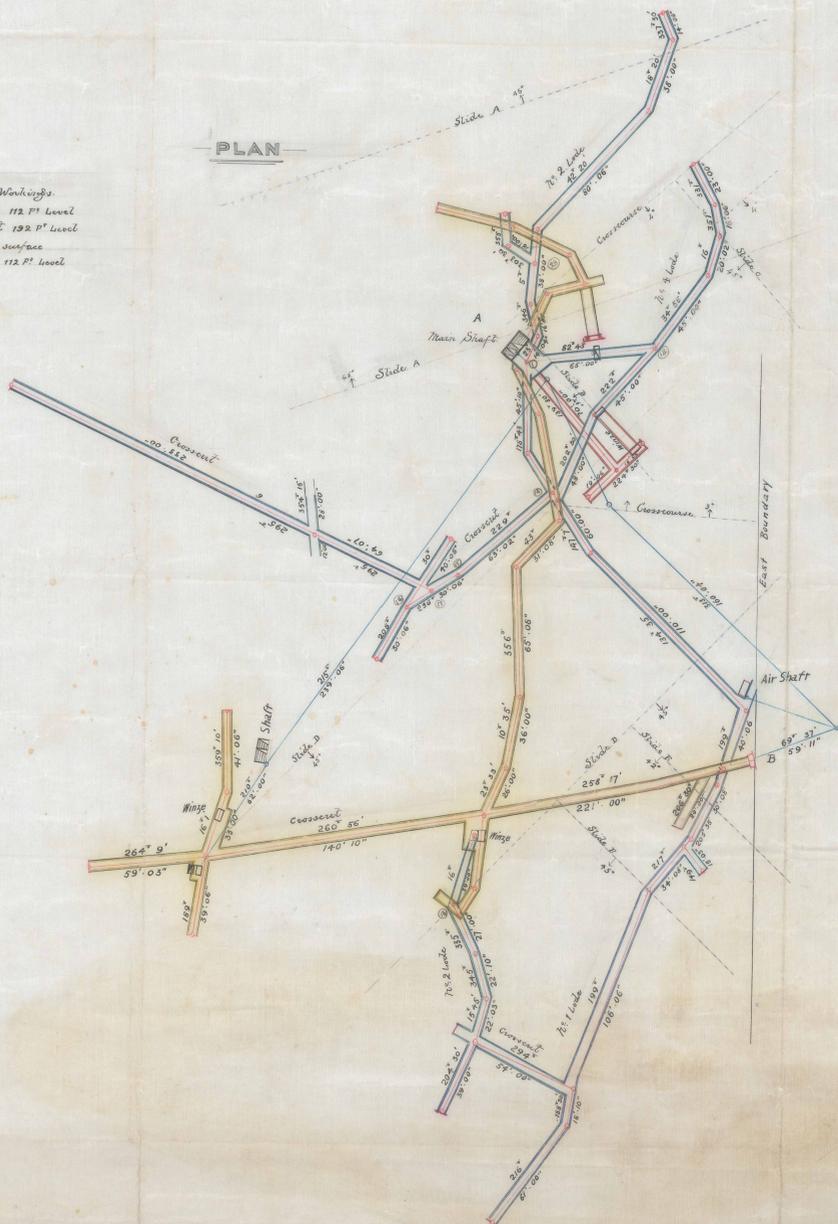

References

- Surface Workings
- Workings at 112 Ft Level
- Workings at 192 Ft Level
- Slides at surface
- Slides at 112 Ft level

*John Craig*  
Mine Manager