


EAST VOLUNTEER C. M. CO NO LIA

LEFROY

Scale 25 feet to an inch

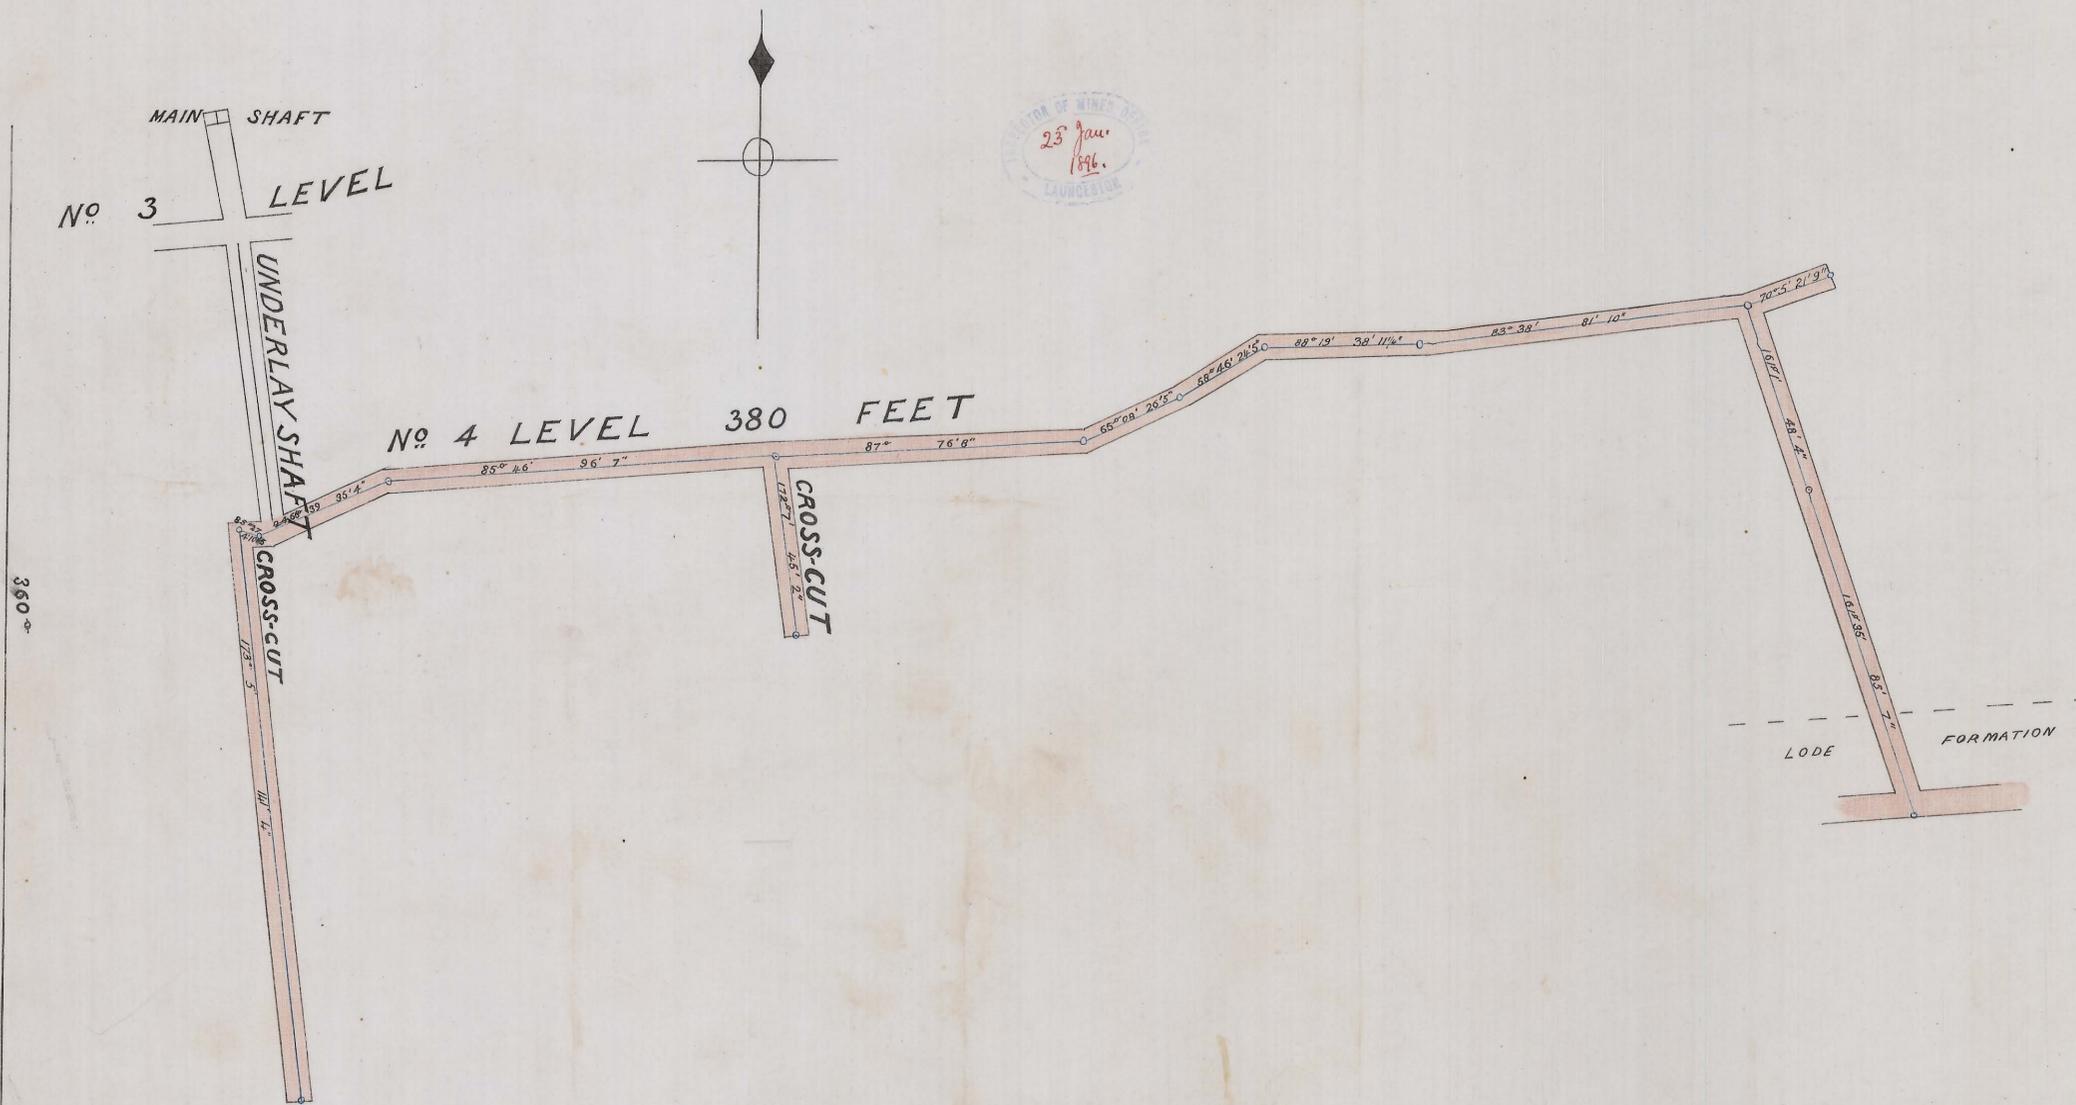

M. J. Miles
Authorised Surveyor
Lefroy
January 1896.