

OLD BOYS MINE


PLAN

CROSS SECTION



NORTH

SOUTH

ALONG LINE CD

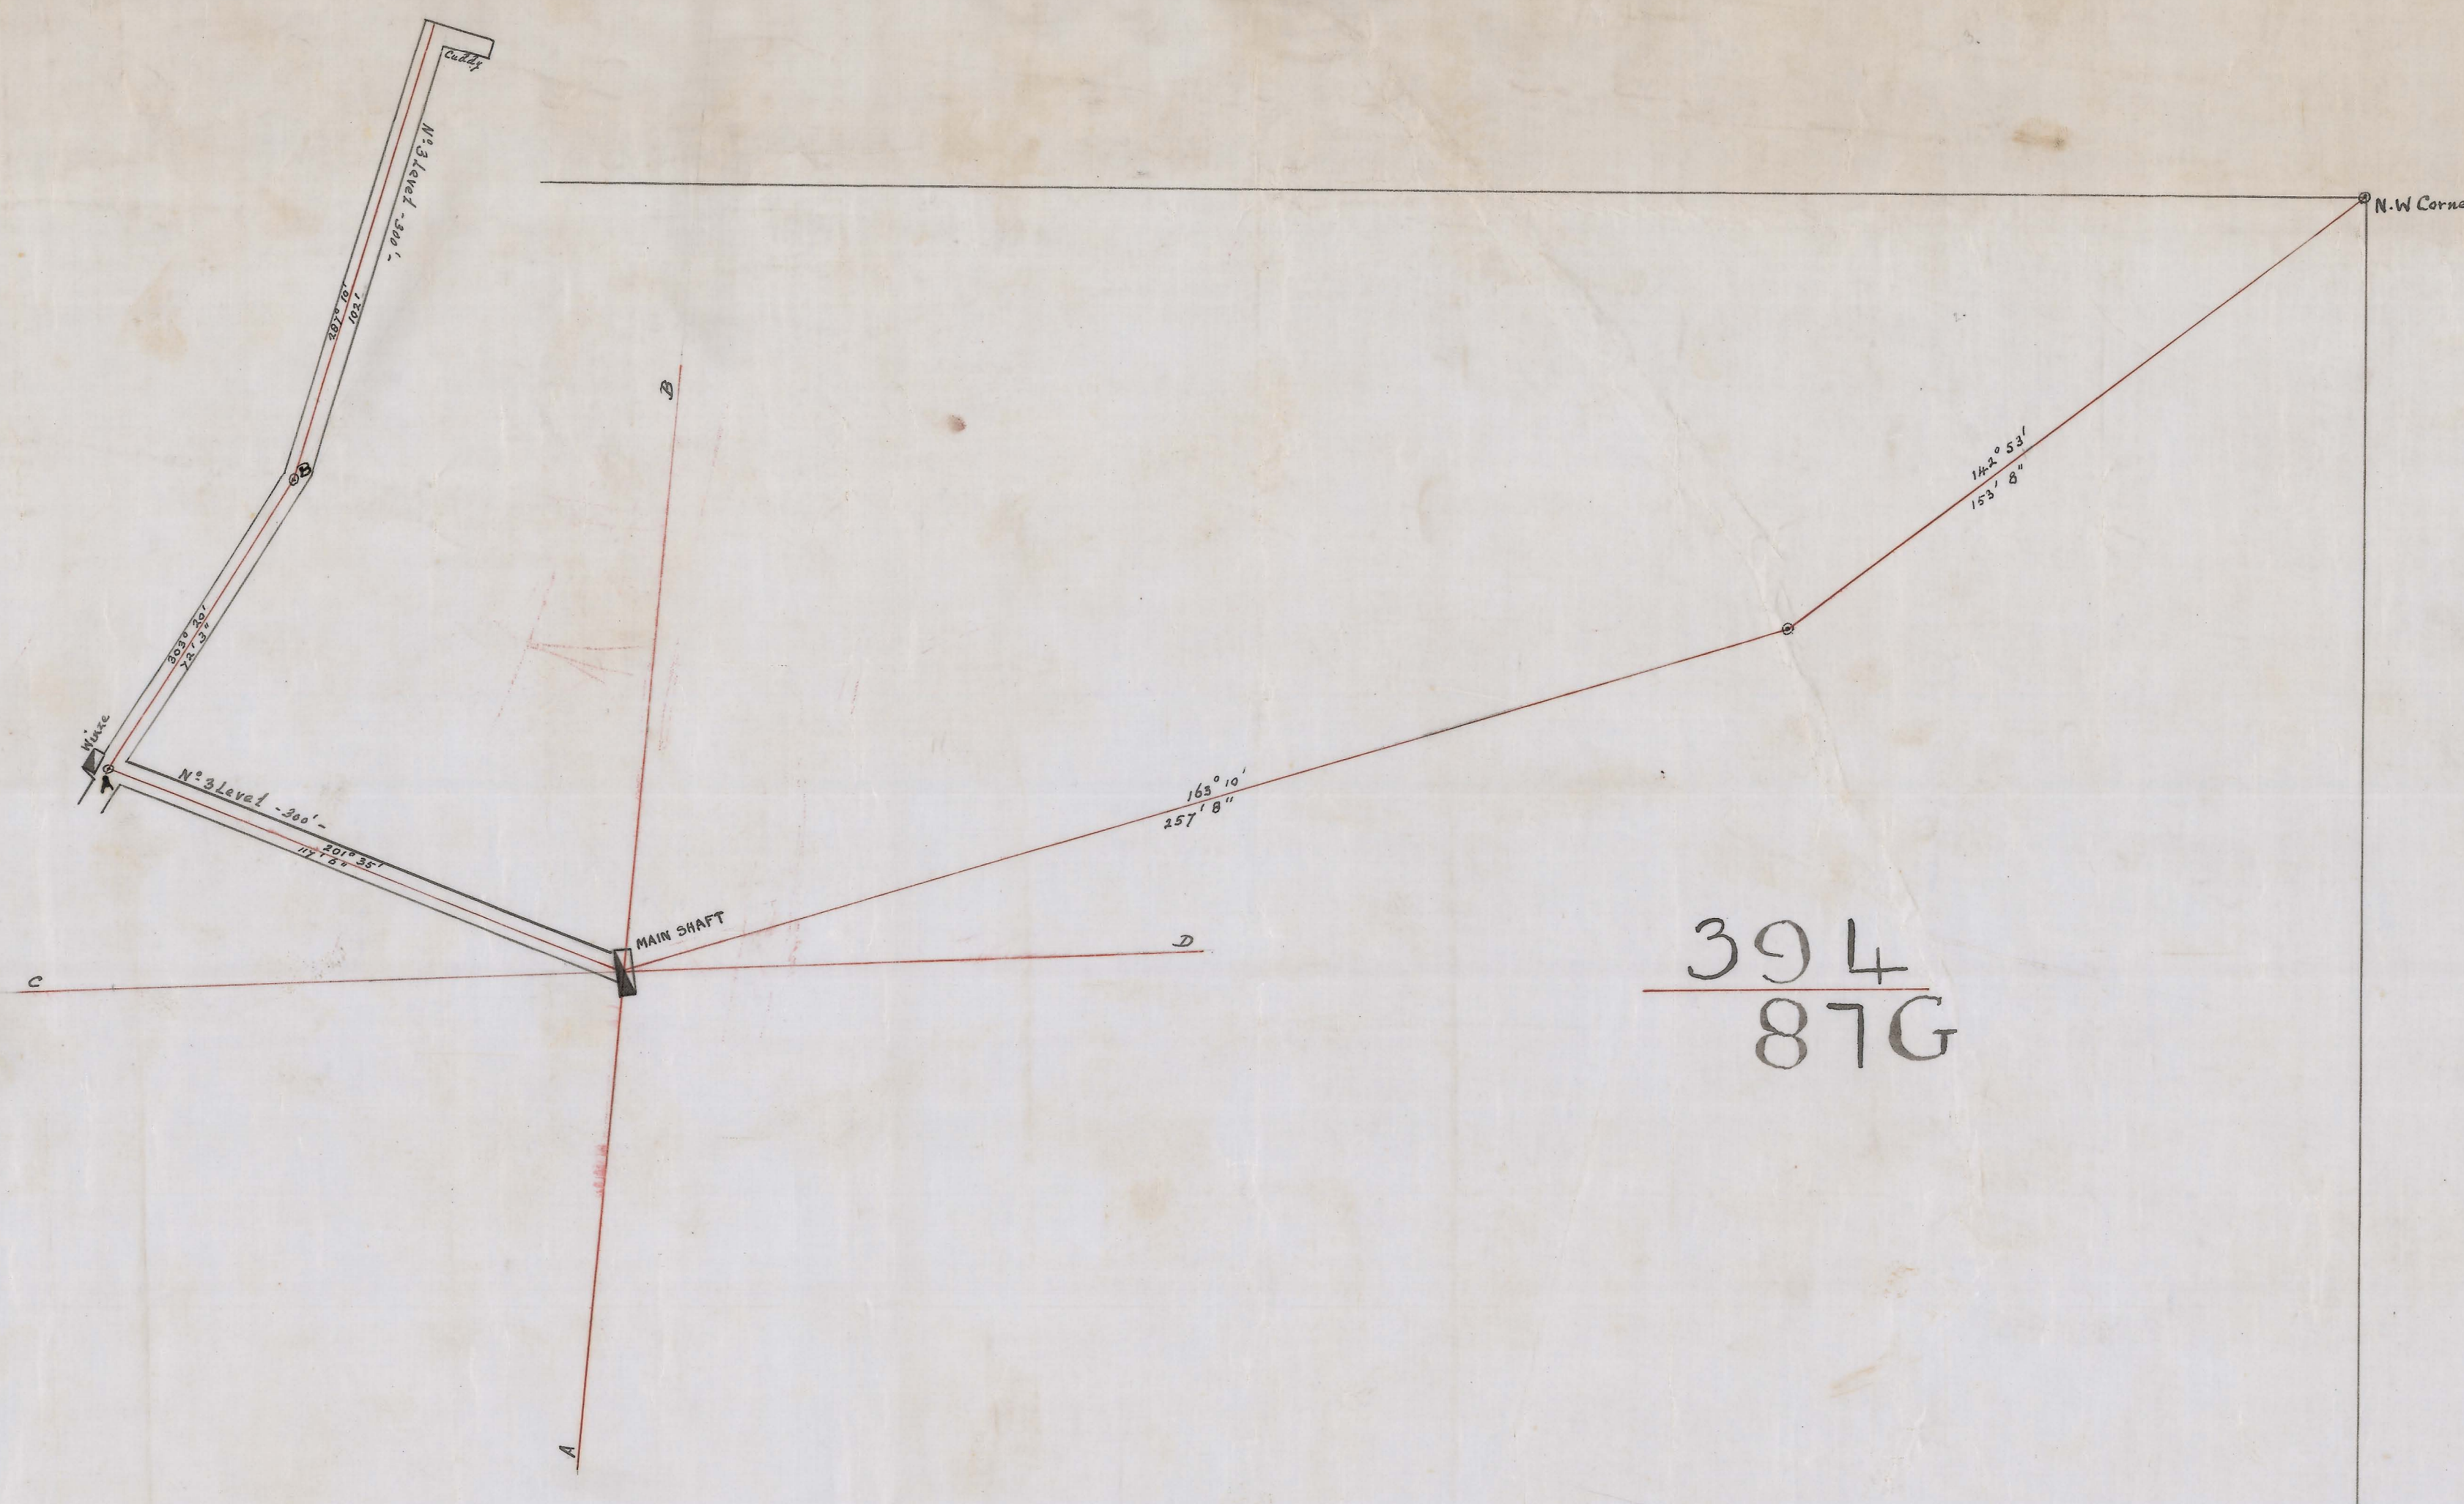

394
876

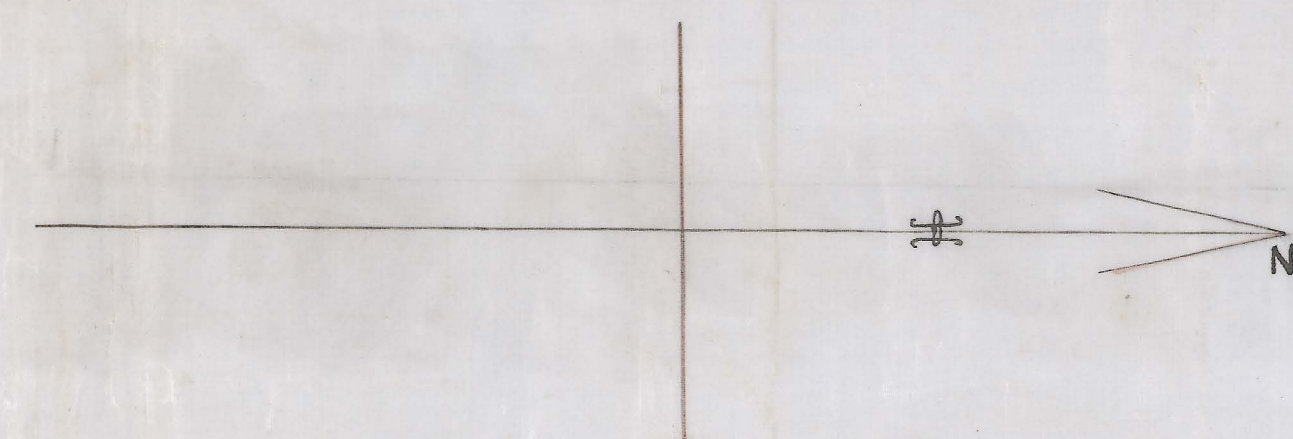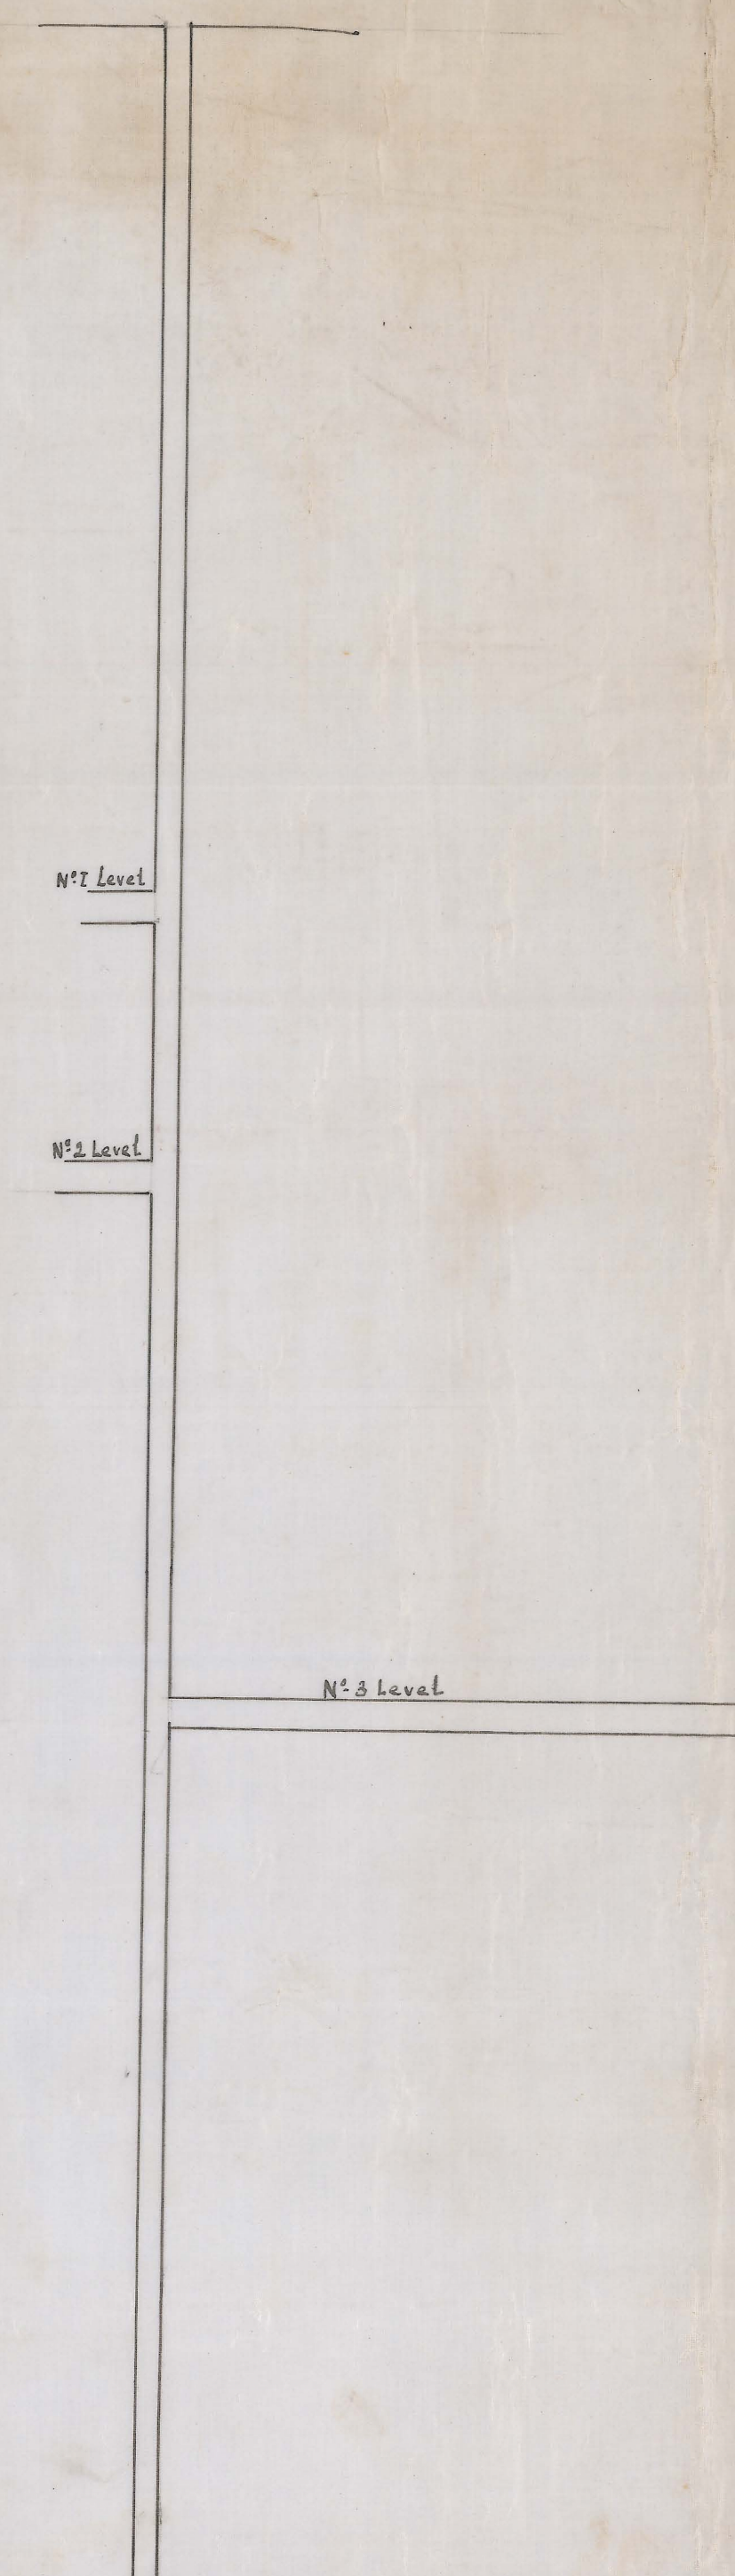

Surveyed and drawn by Arthur Dickinson A.R.S.M. and G. R. Jones
Instrument Used - Theodolite -



Scale 1 inch = 100 feet

5 cm