


50-112


FIELD NOTES

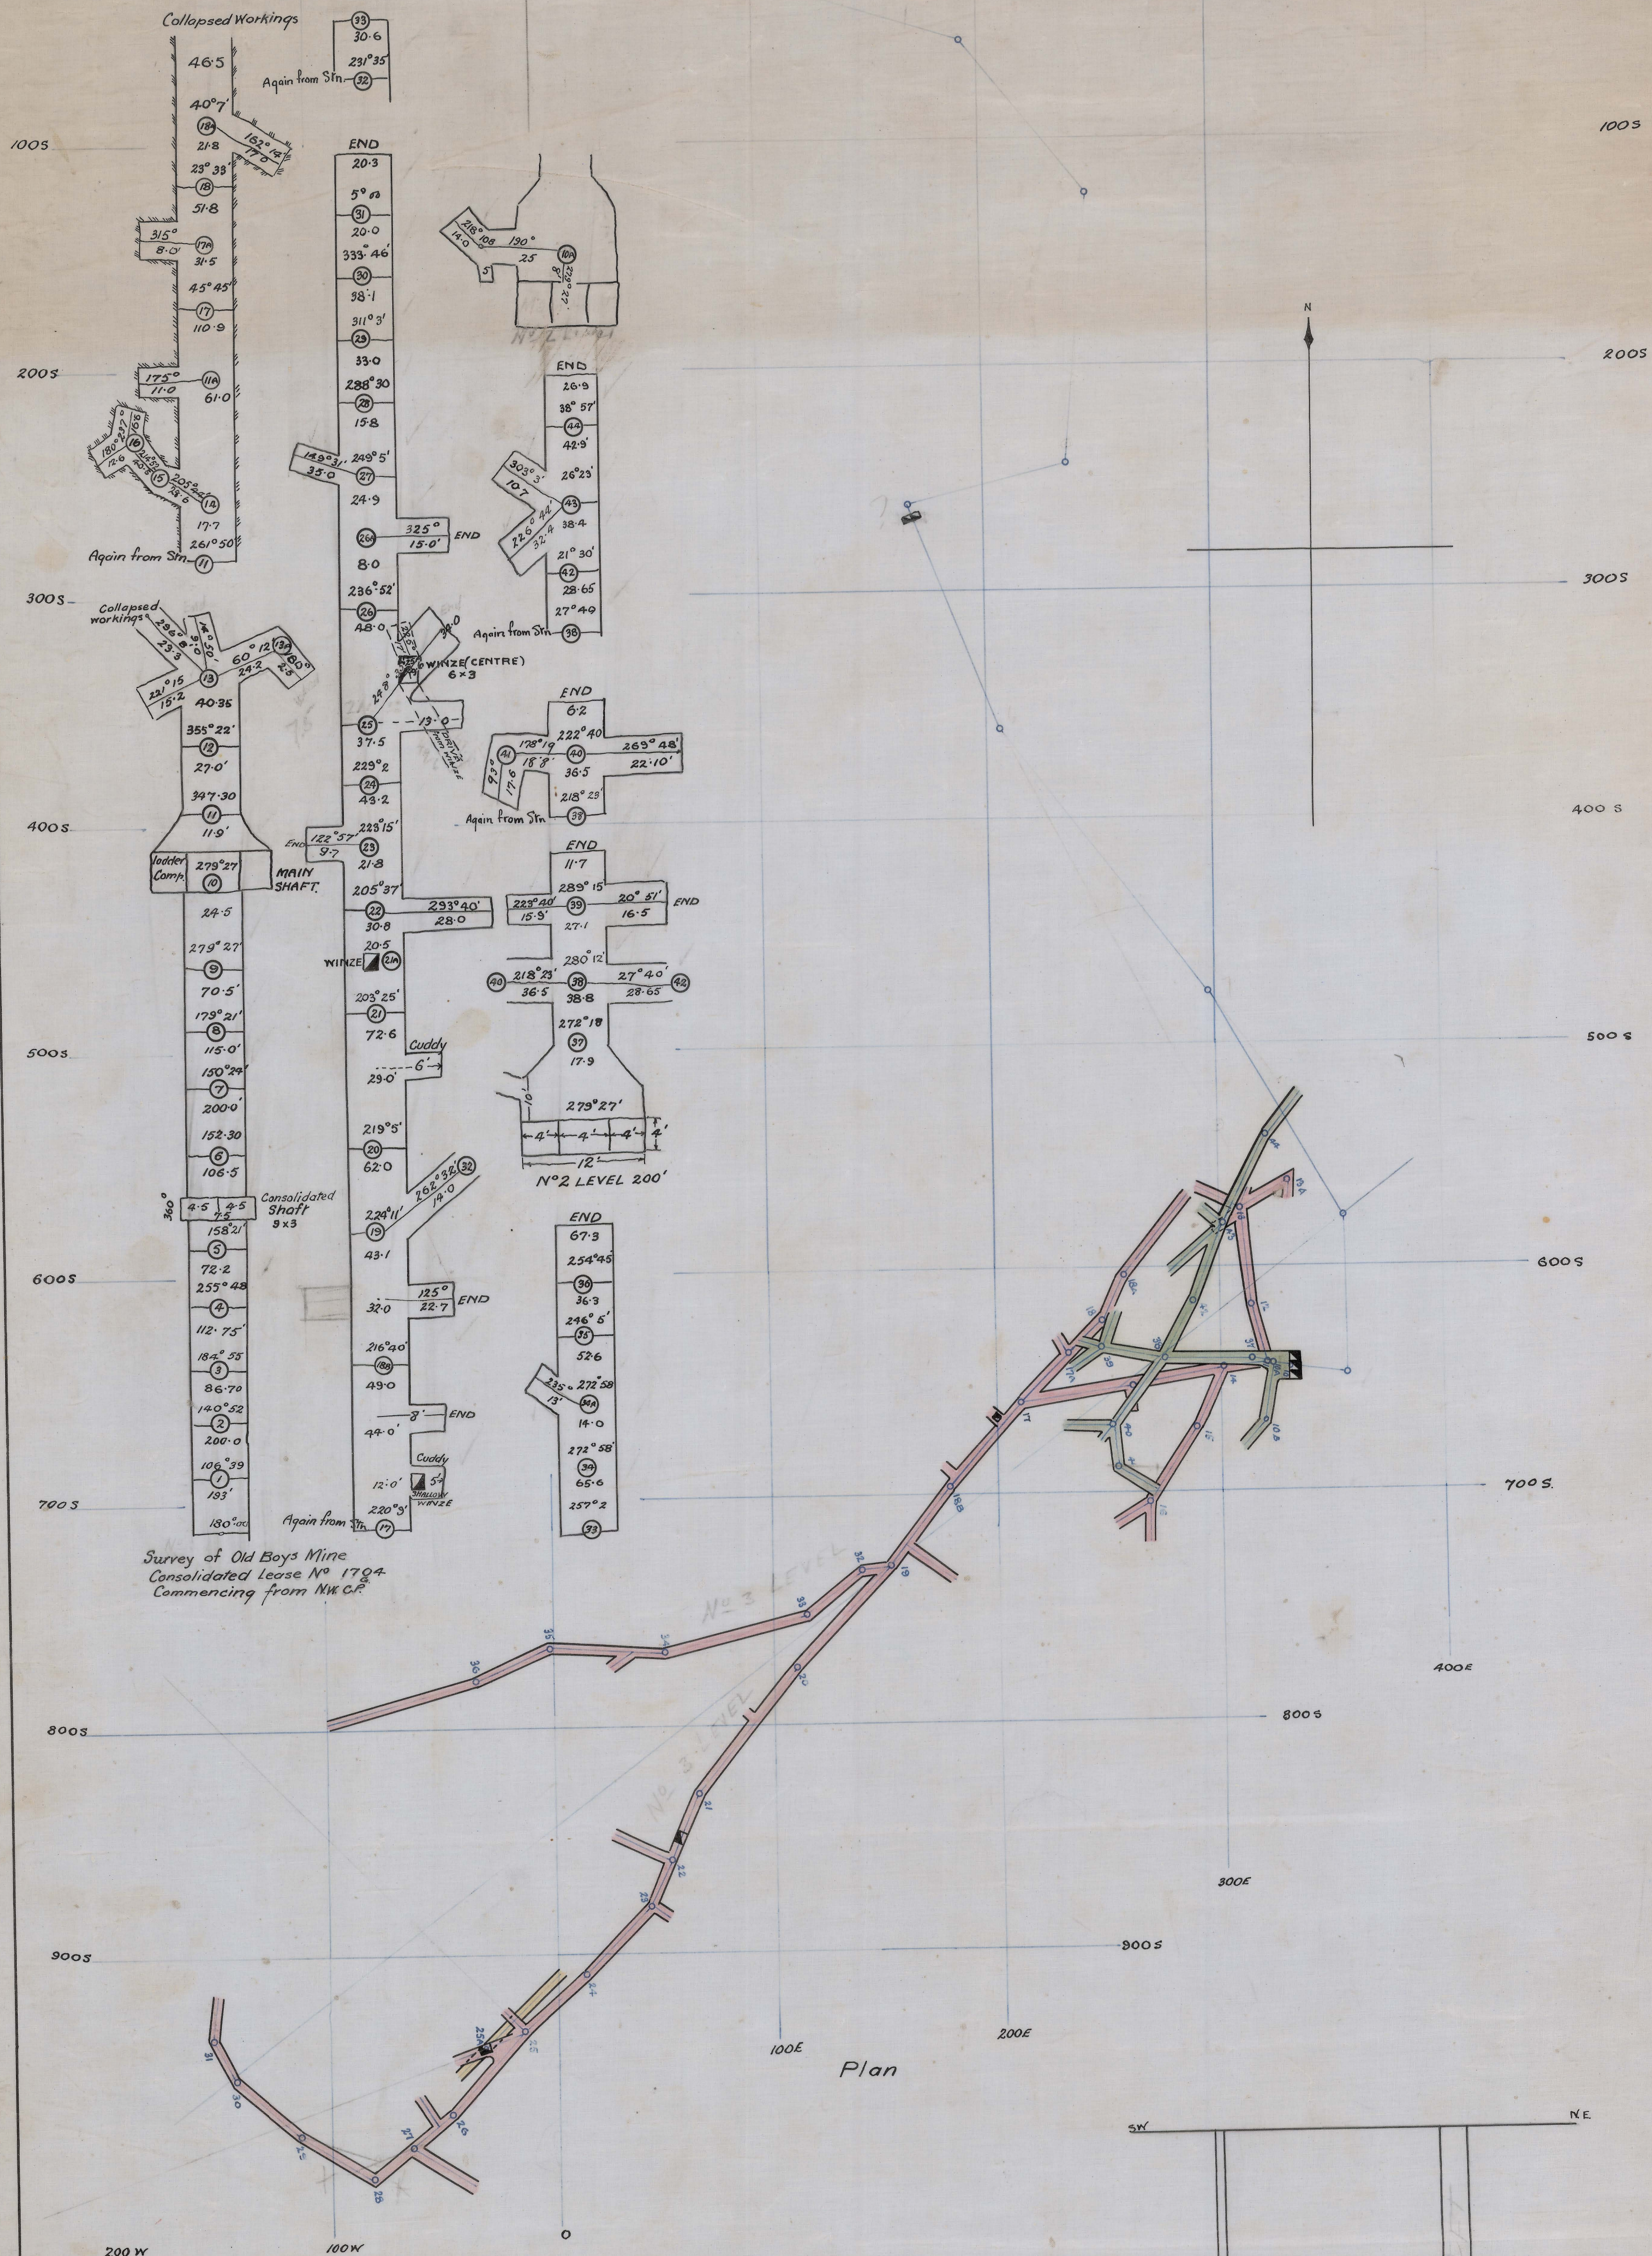

Survey of Old Boys Mine
Consolidated Lease No 1794
Commencing from NW C.R.

UNDERGROUND WORKINGS
OLD BOYS MINE

SCALE
1 inch = 40 feet.

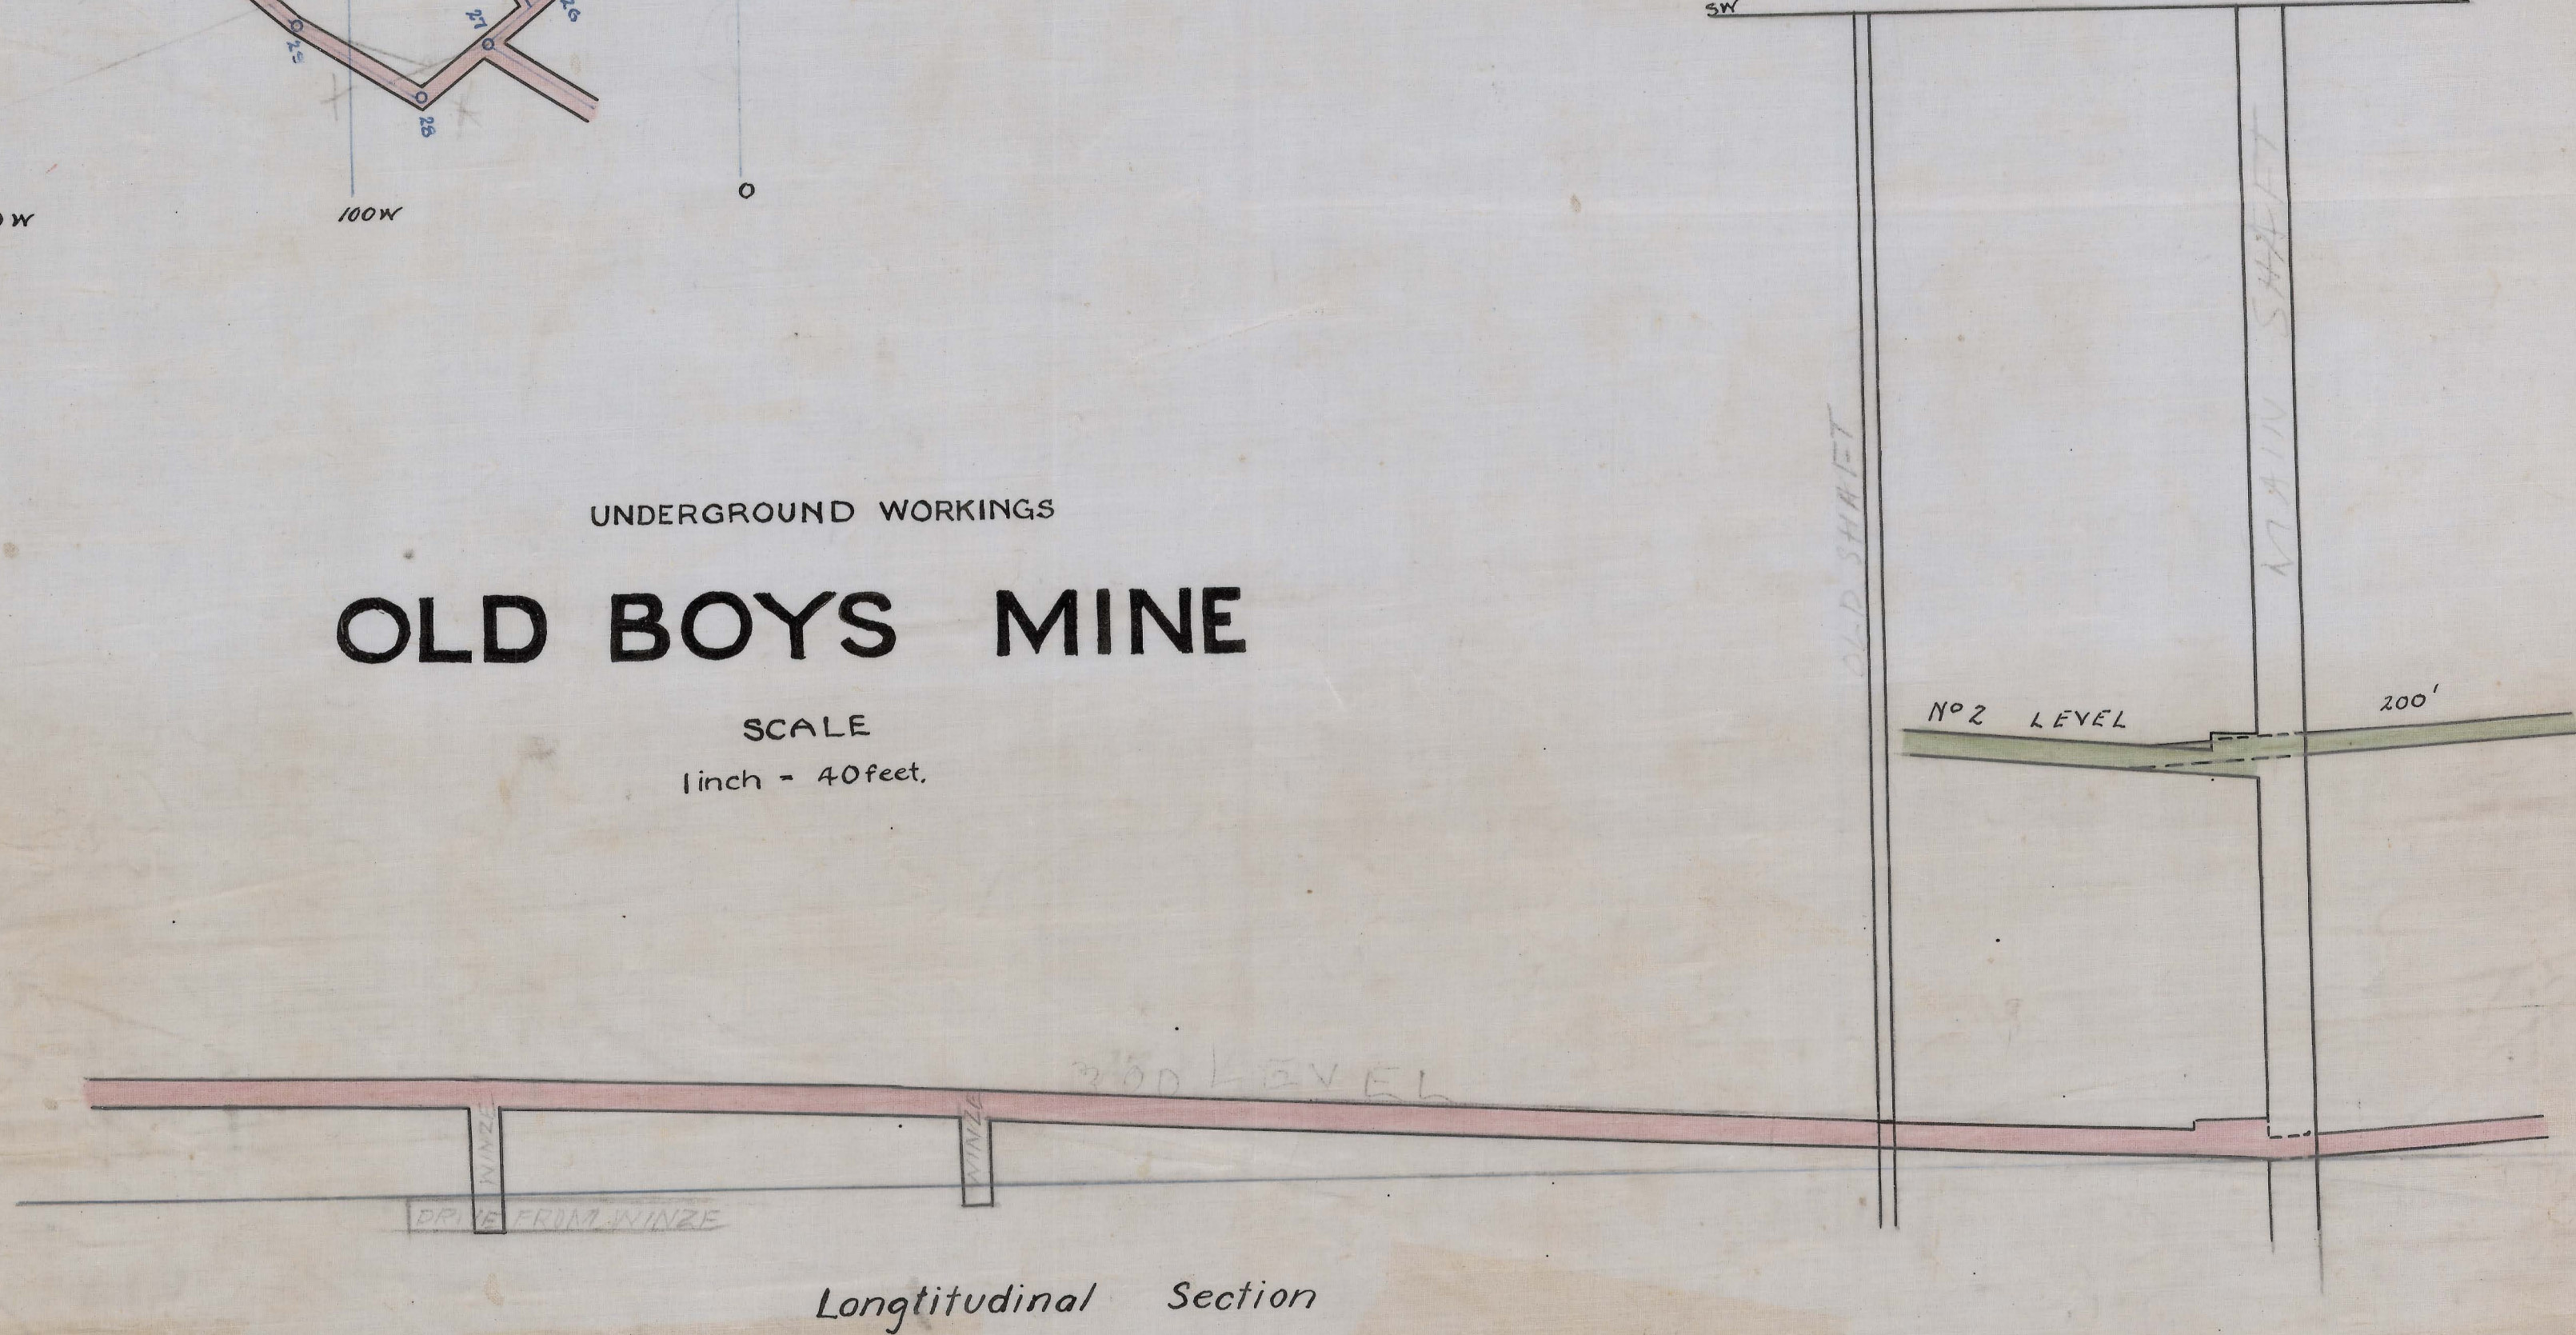

Longitudinal Section

50-112