


312
-02

312
-02

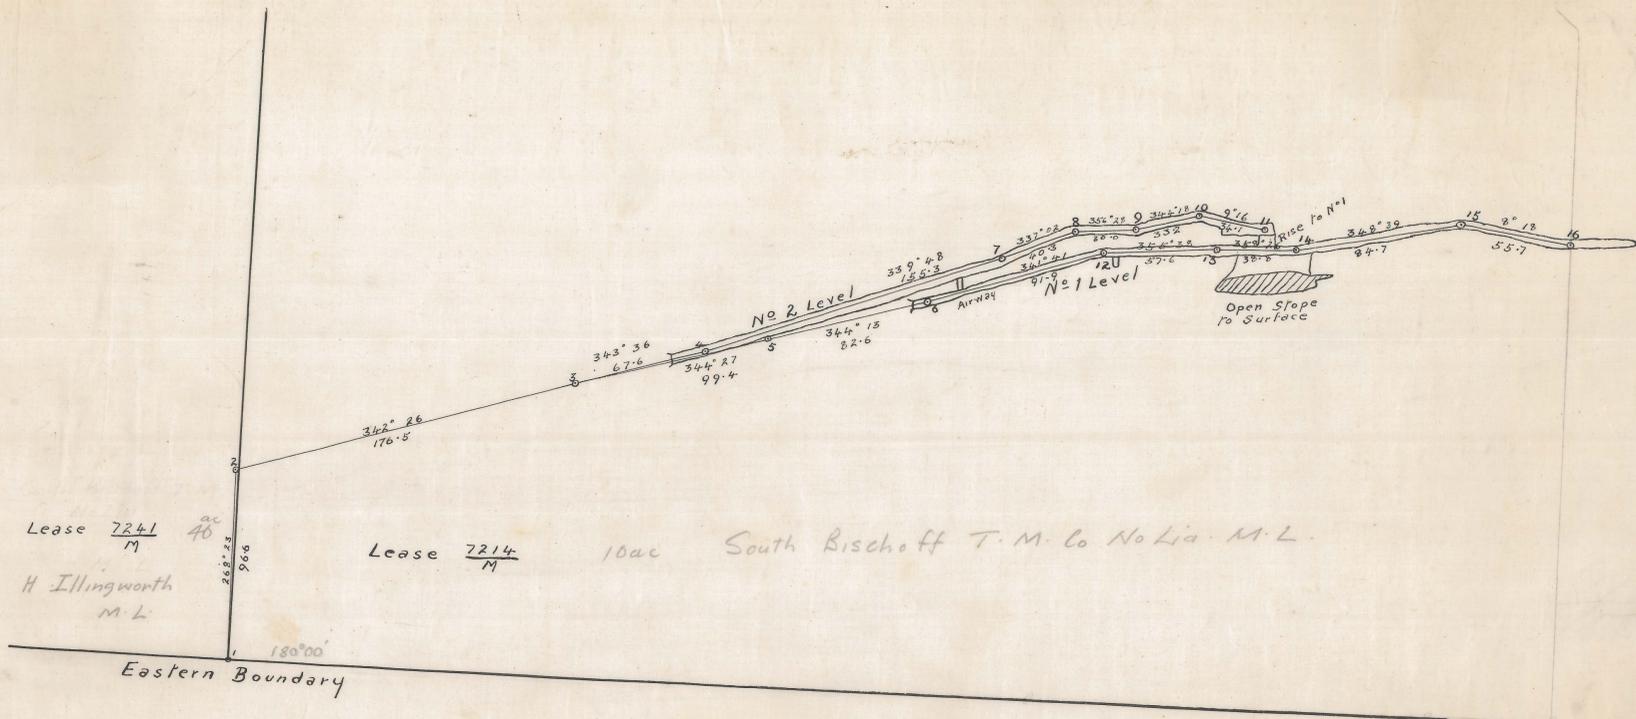

Lease $\frac{7241}{M}$ $\frac{40}{ac}$
 H Illingworth
 M.L.

Lease $\frac{7214}{M}$

10ac South Bischoff T.M. Co No Lia. M.L.

7245
M

40

South Bischoff T.M. Co
 No Lia. M.L.

5 cm

WARATAH TIN SLUICING CO.
Plan of Underground Workings.
Scale One Inch = Forty Feet.

A. D. Mackay,
 Licensed Mine Manager
 June 28th 1922.
 Instrument used 5 inch
 Troughton & Simms
 reading to minutes

Exd.
 2-11-22
 [Signature]