
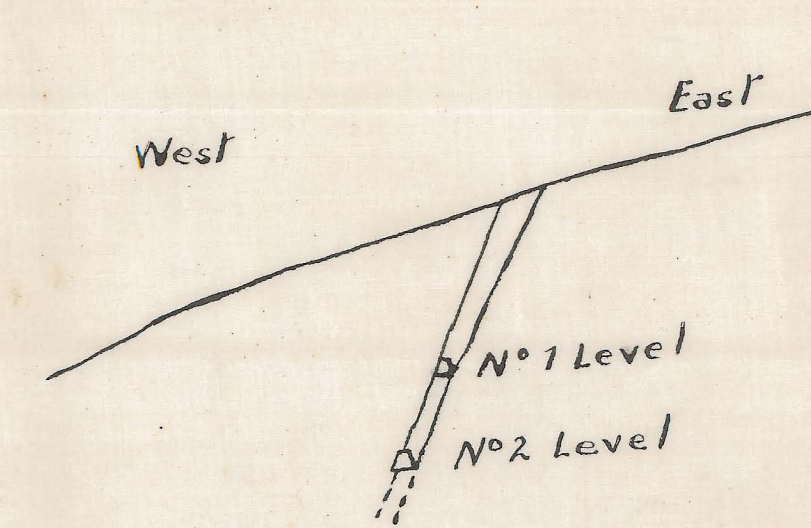


3-12
-63

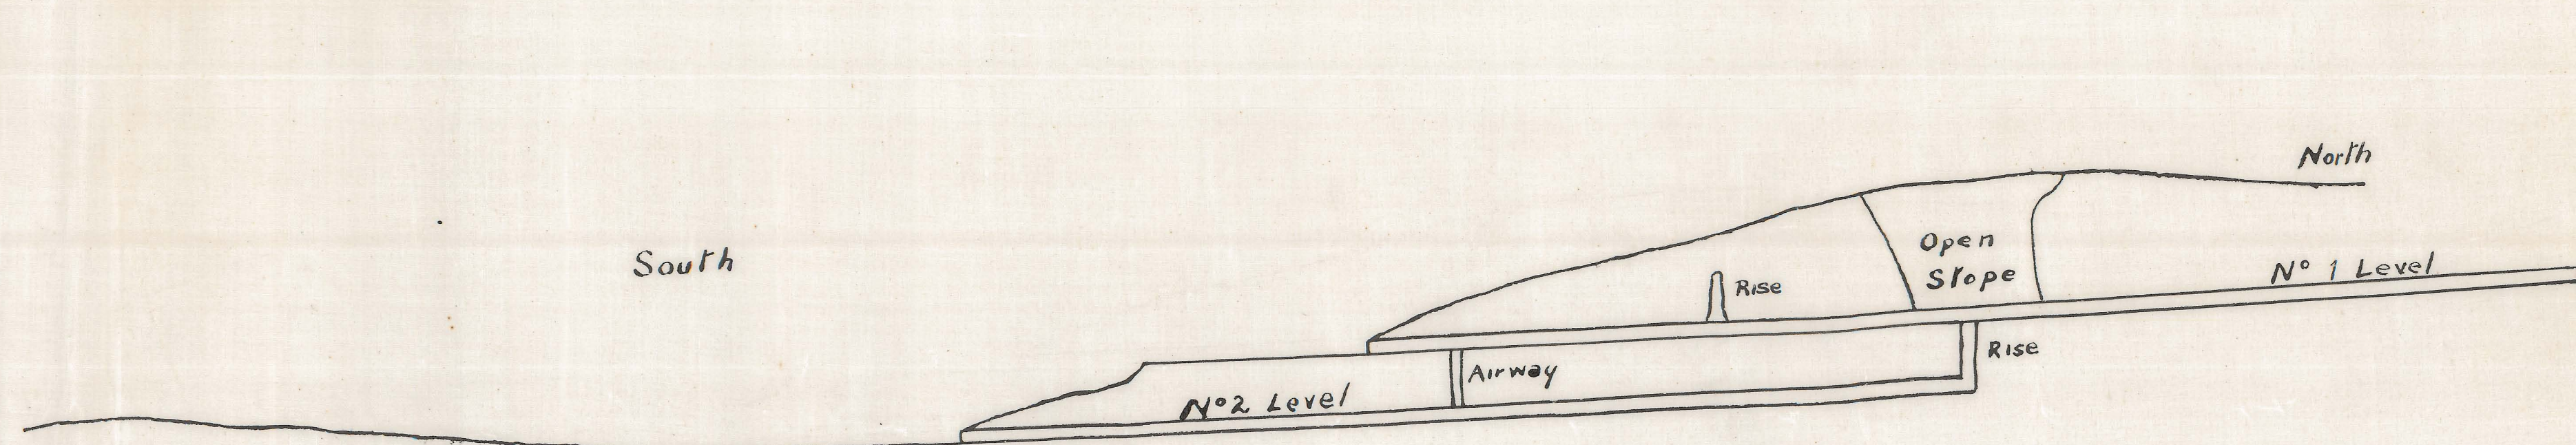

LONGITUDINAL SECTION

WARATAH TIN SLUICING CO
Sections of Underground Workings
Scale One Inch = Forty Feet

CROSS SECTION

A.D. Mackay
Licensed mine manager
17th July. 1922

5 cm