
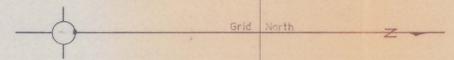


LOCALITY PLAN
Scale: 1 mile to 1 inch.

60 M
69

50

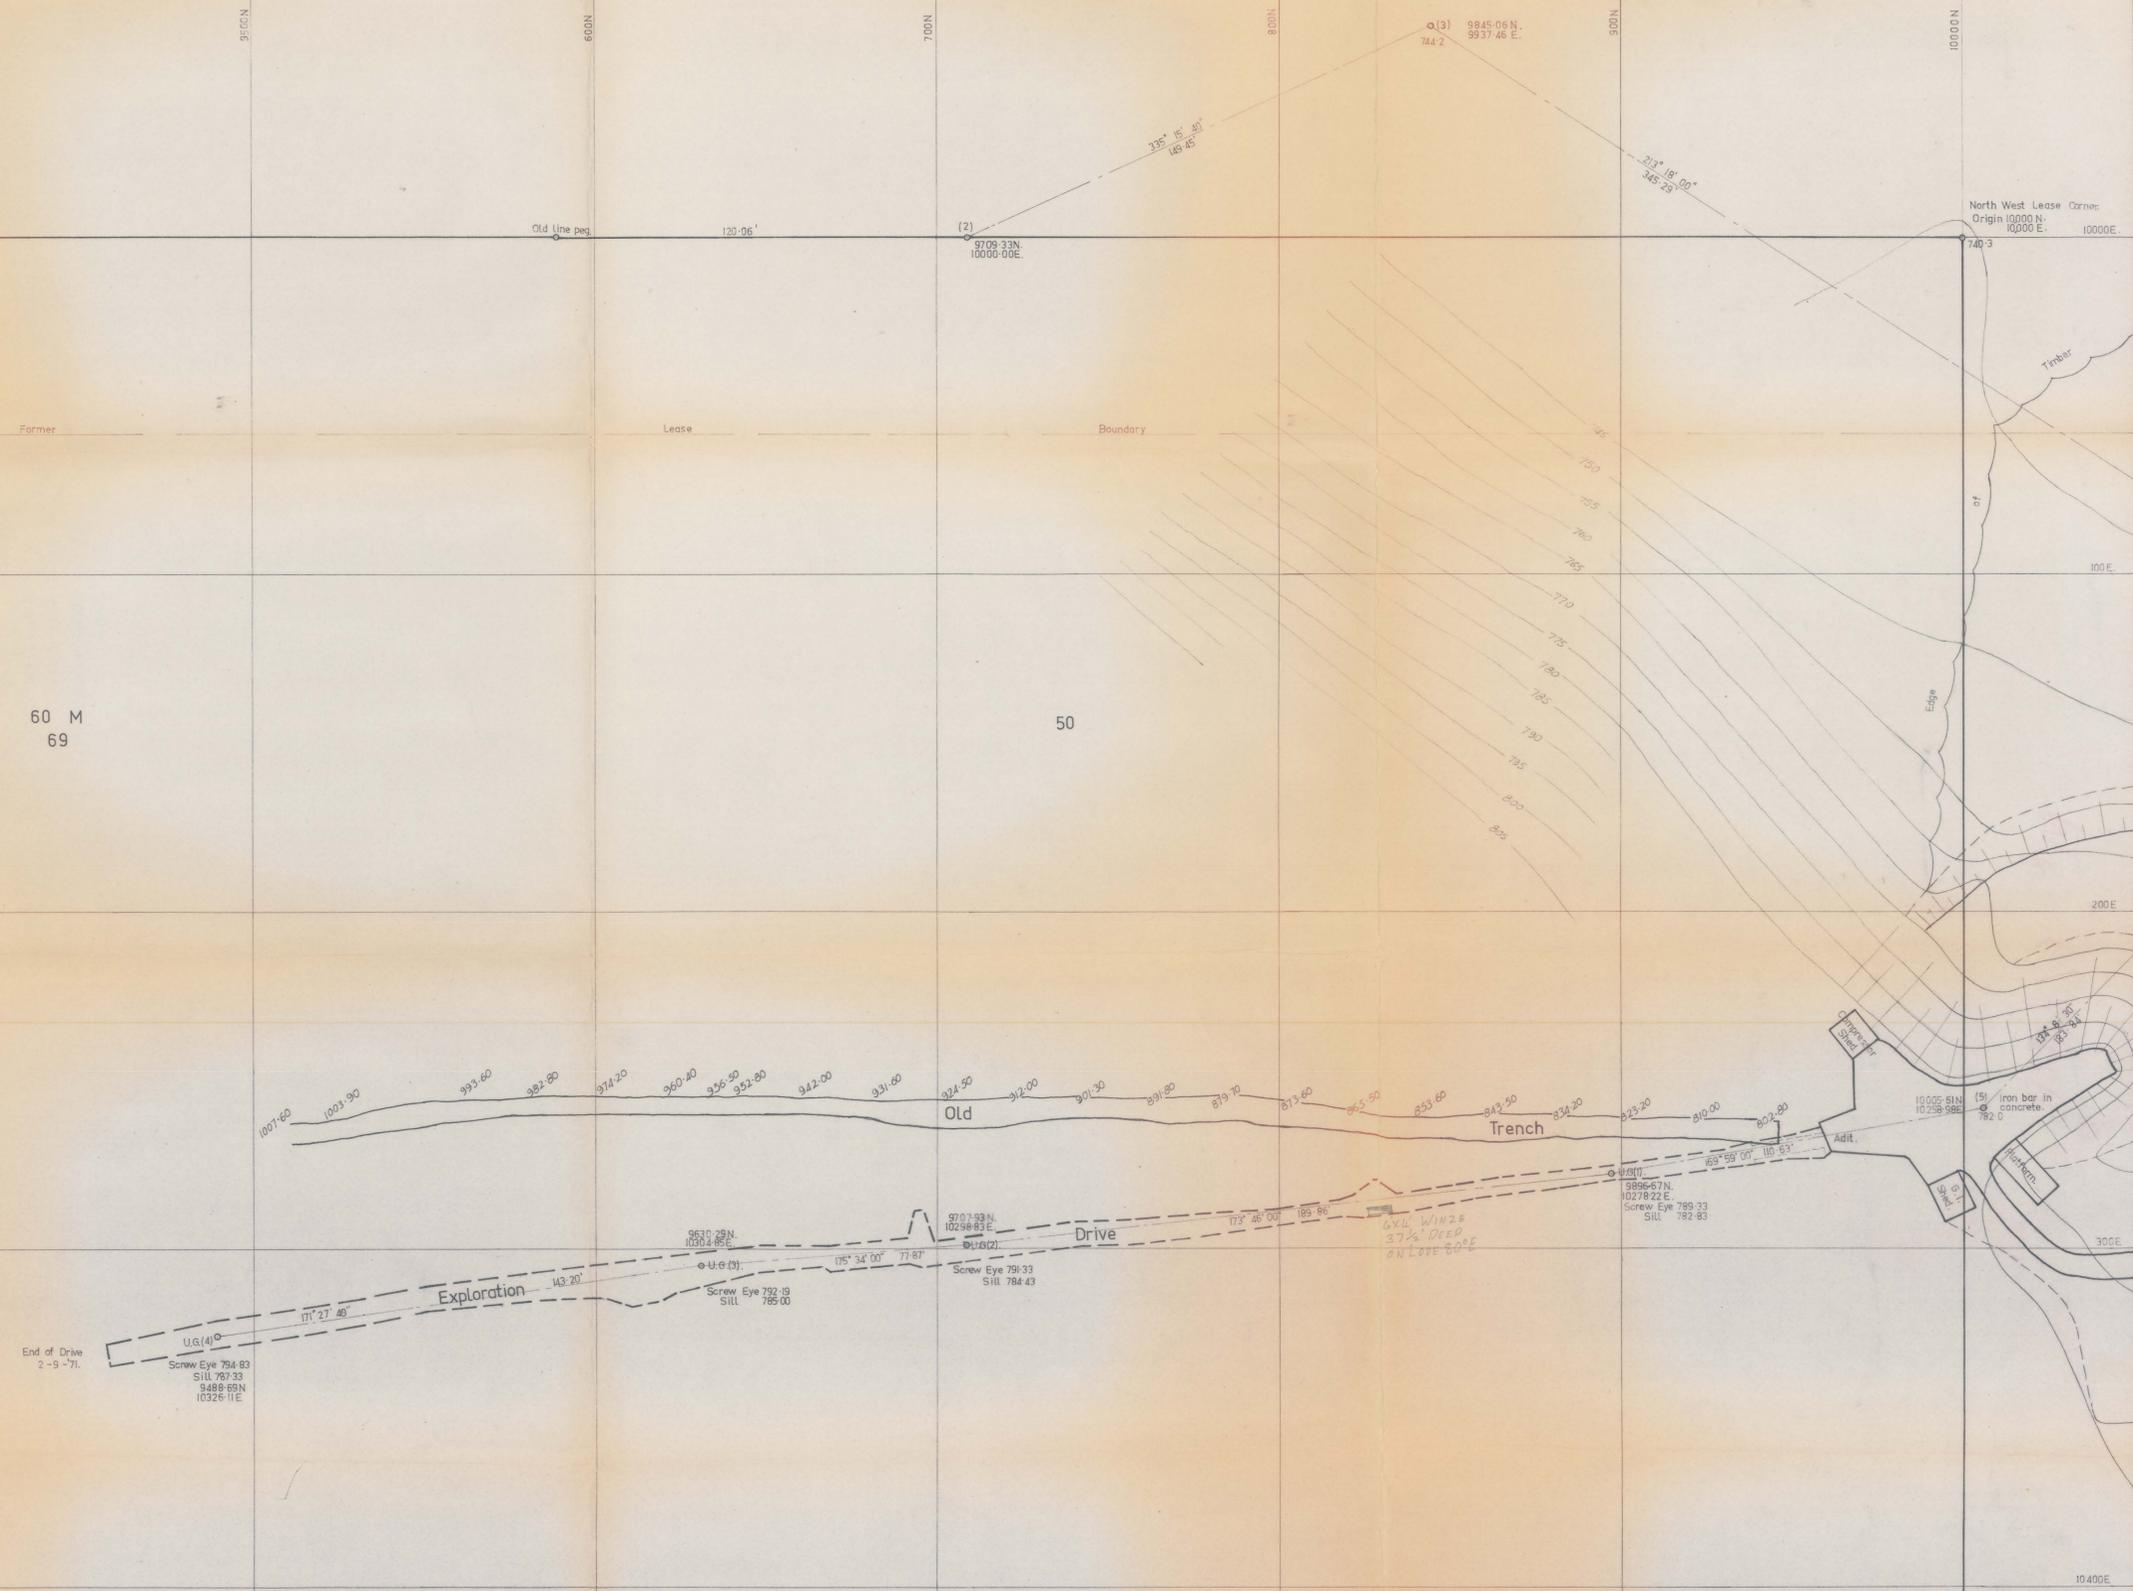

S.B. 16.
F.B. 51.

G.I. FISHER LAND & ENGINEERING SURVEYOR
LAUNCESTON PHONE 31 4207.

SCAMANDER MINING CORPORATION N.L.
MOUNT PELION MINE.

30-8-71

SCALE:	20' TO 1"	NO.
DRAWN:	R. J. P.	38/2
CHECKED:	G. I. F.	

REGISTERED SURVEYOR: