


NOTES: (1) Levels are to assumed datum as for pick up of trench.  
 (2) Grid north is former Magnetic North & is north of lease boundaries.  
 (3) Preliminary copy.

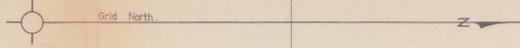

S.E. 15  
F.B.

G.I. FISHER LAND & ENGINEERING SURVEYOR.  
 LAUNCESTON PHONE 31 4207.

SCAMANDER MINING CORPORATION N.L.  
 MOUNT PELION MINE.

30-8-71

SCALE:	20' TO 1"	NO.
DRAWN:	R. J. P.	38/1
CHECKED:	G. I. F.	

REGISTERED SURVEYOR.