

FINGAL COAL MINE FINGAL




Neil Aberton A.O.S.M.
TECHNICAL & ADMINISTRATIVE ASST
JAN 1952

N.B. SURVEY BY THEODOLITE.

- LEGEND—
PACK WALL
STOPPING
BRATTICES
WATER

38 M
42 20 ac.
M. J. S. YEATES
M. L.

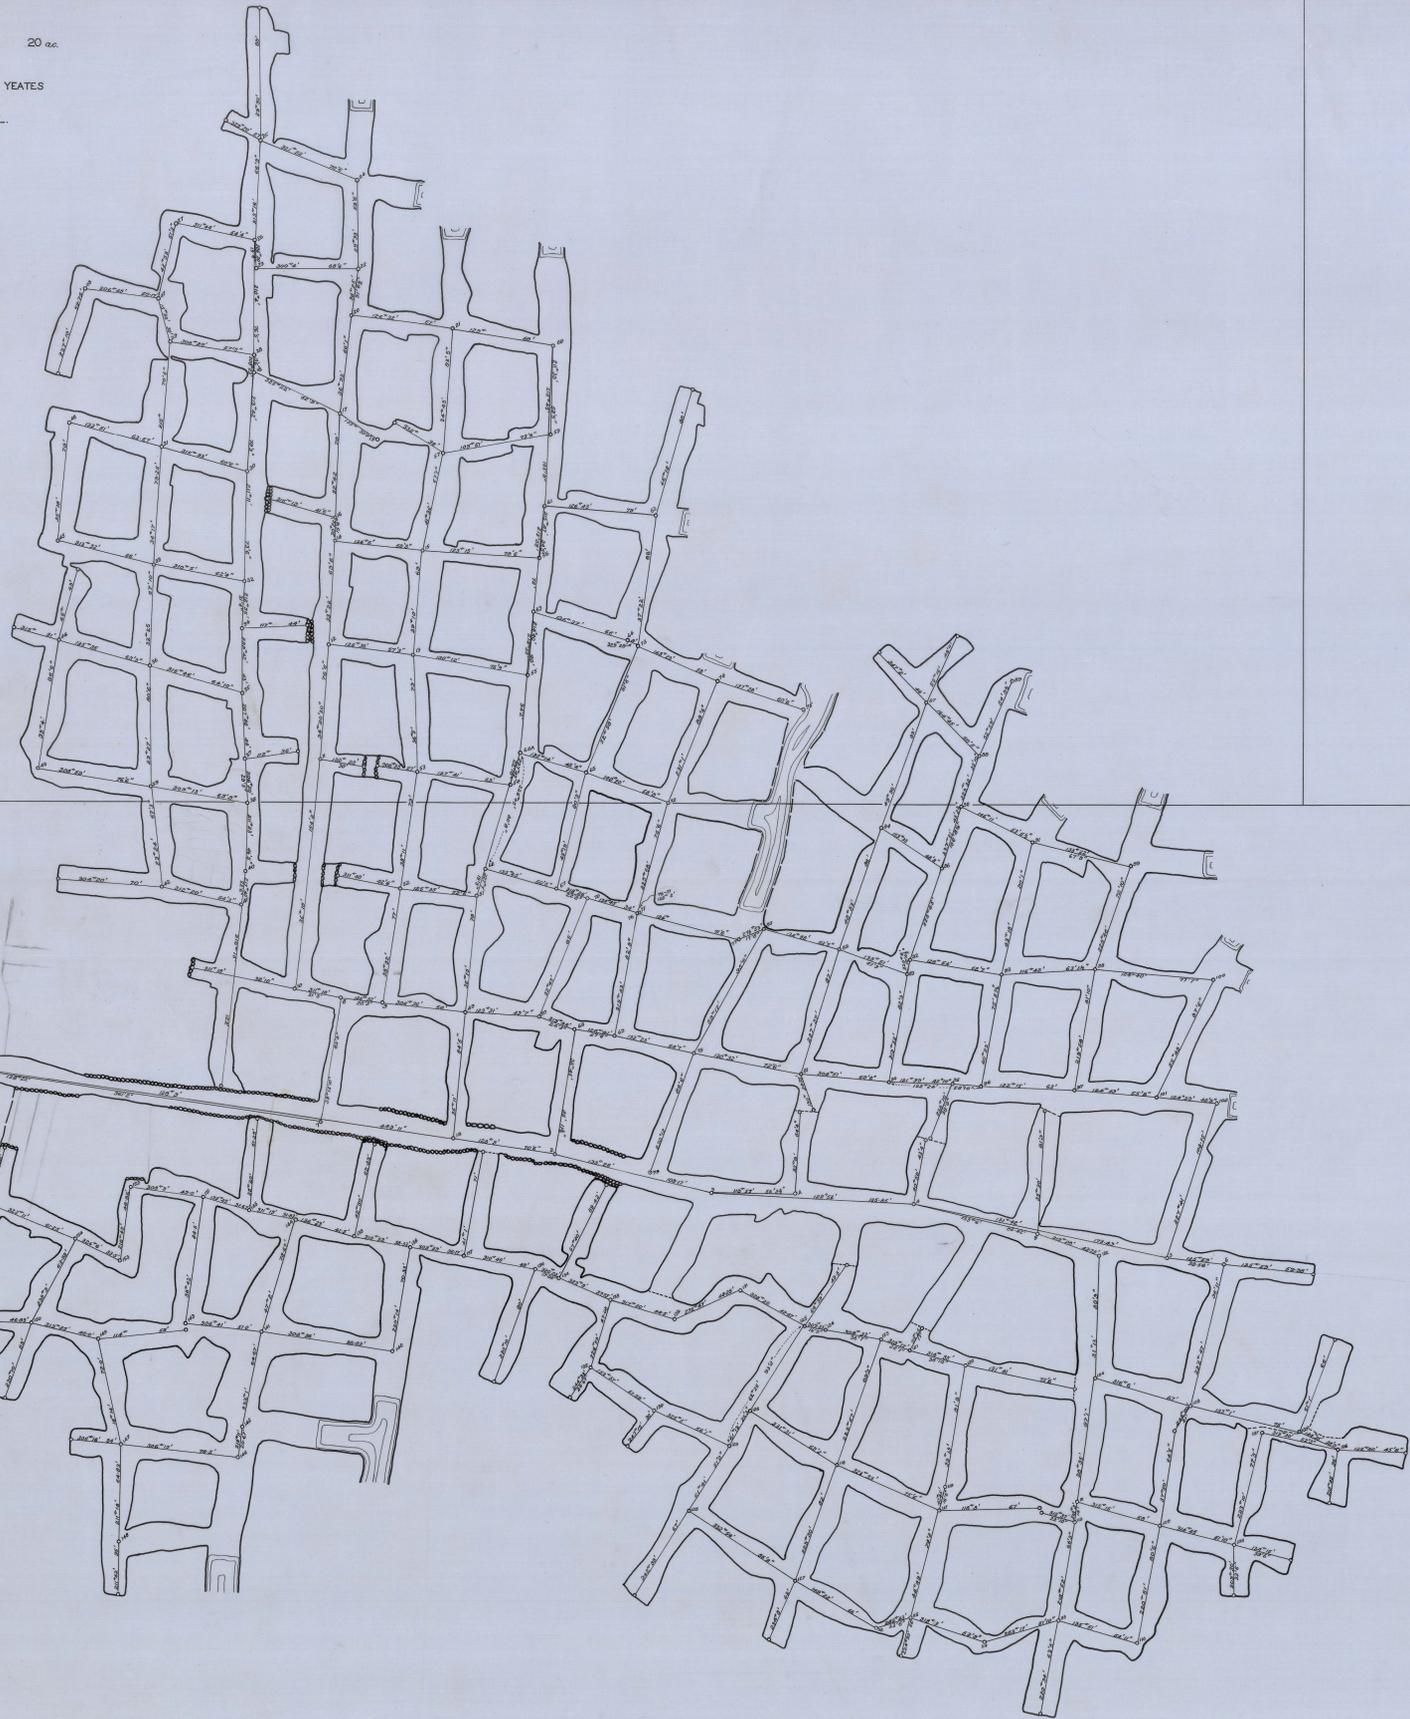

9643
M 60 ac.
M. J. S. YEATES
M. L.



373
01

373
01