


374 - 01

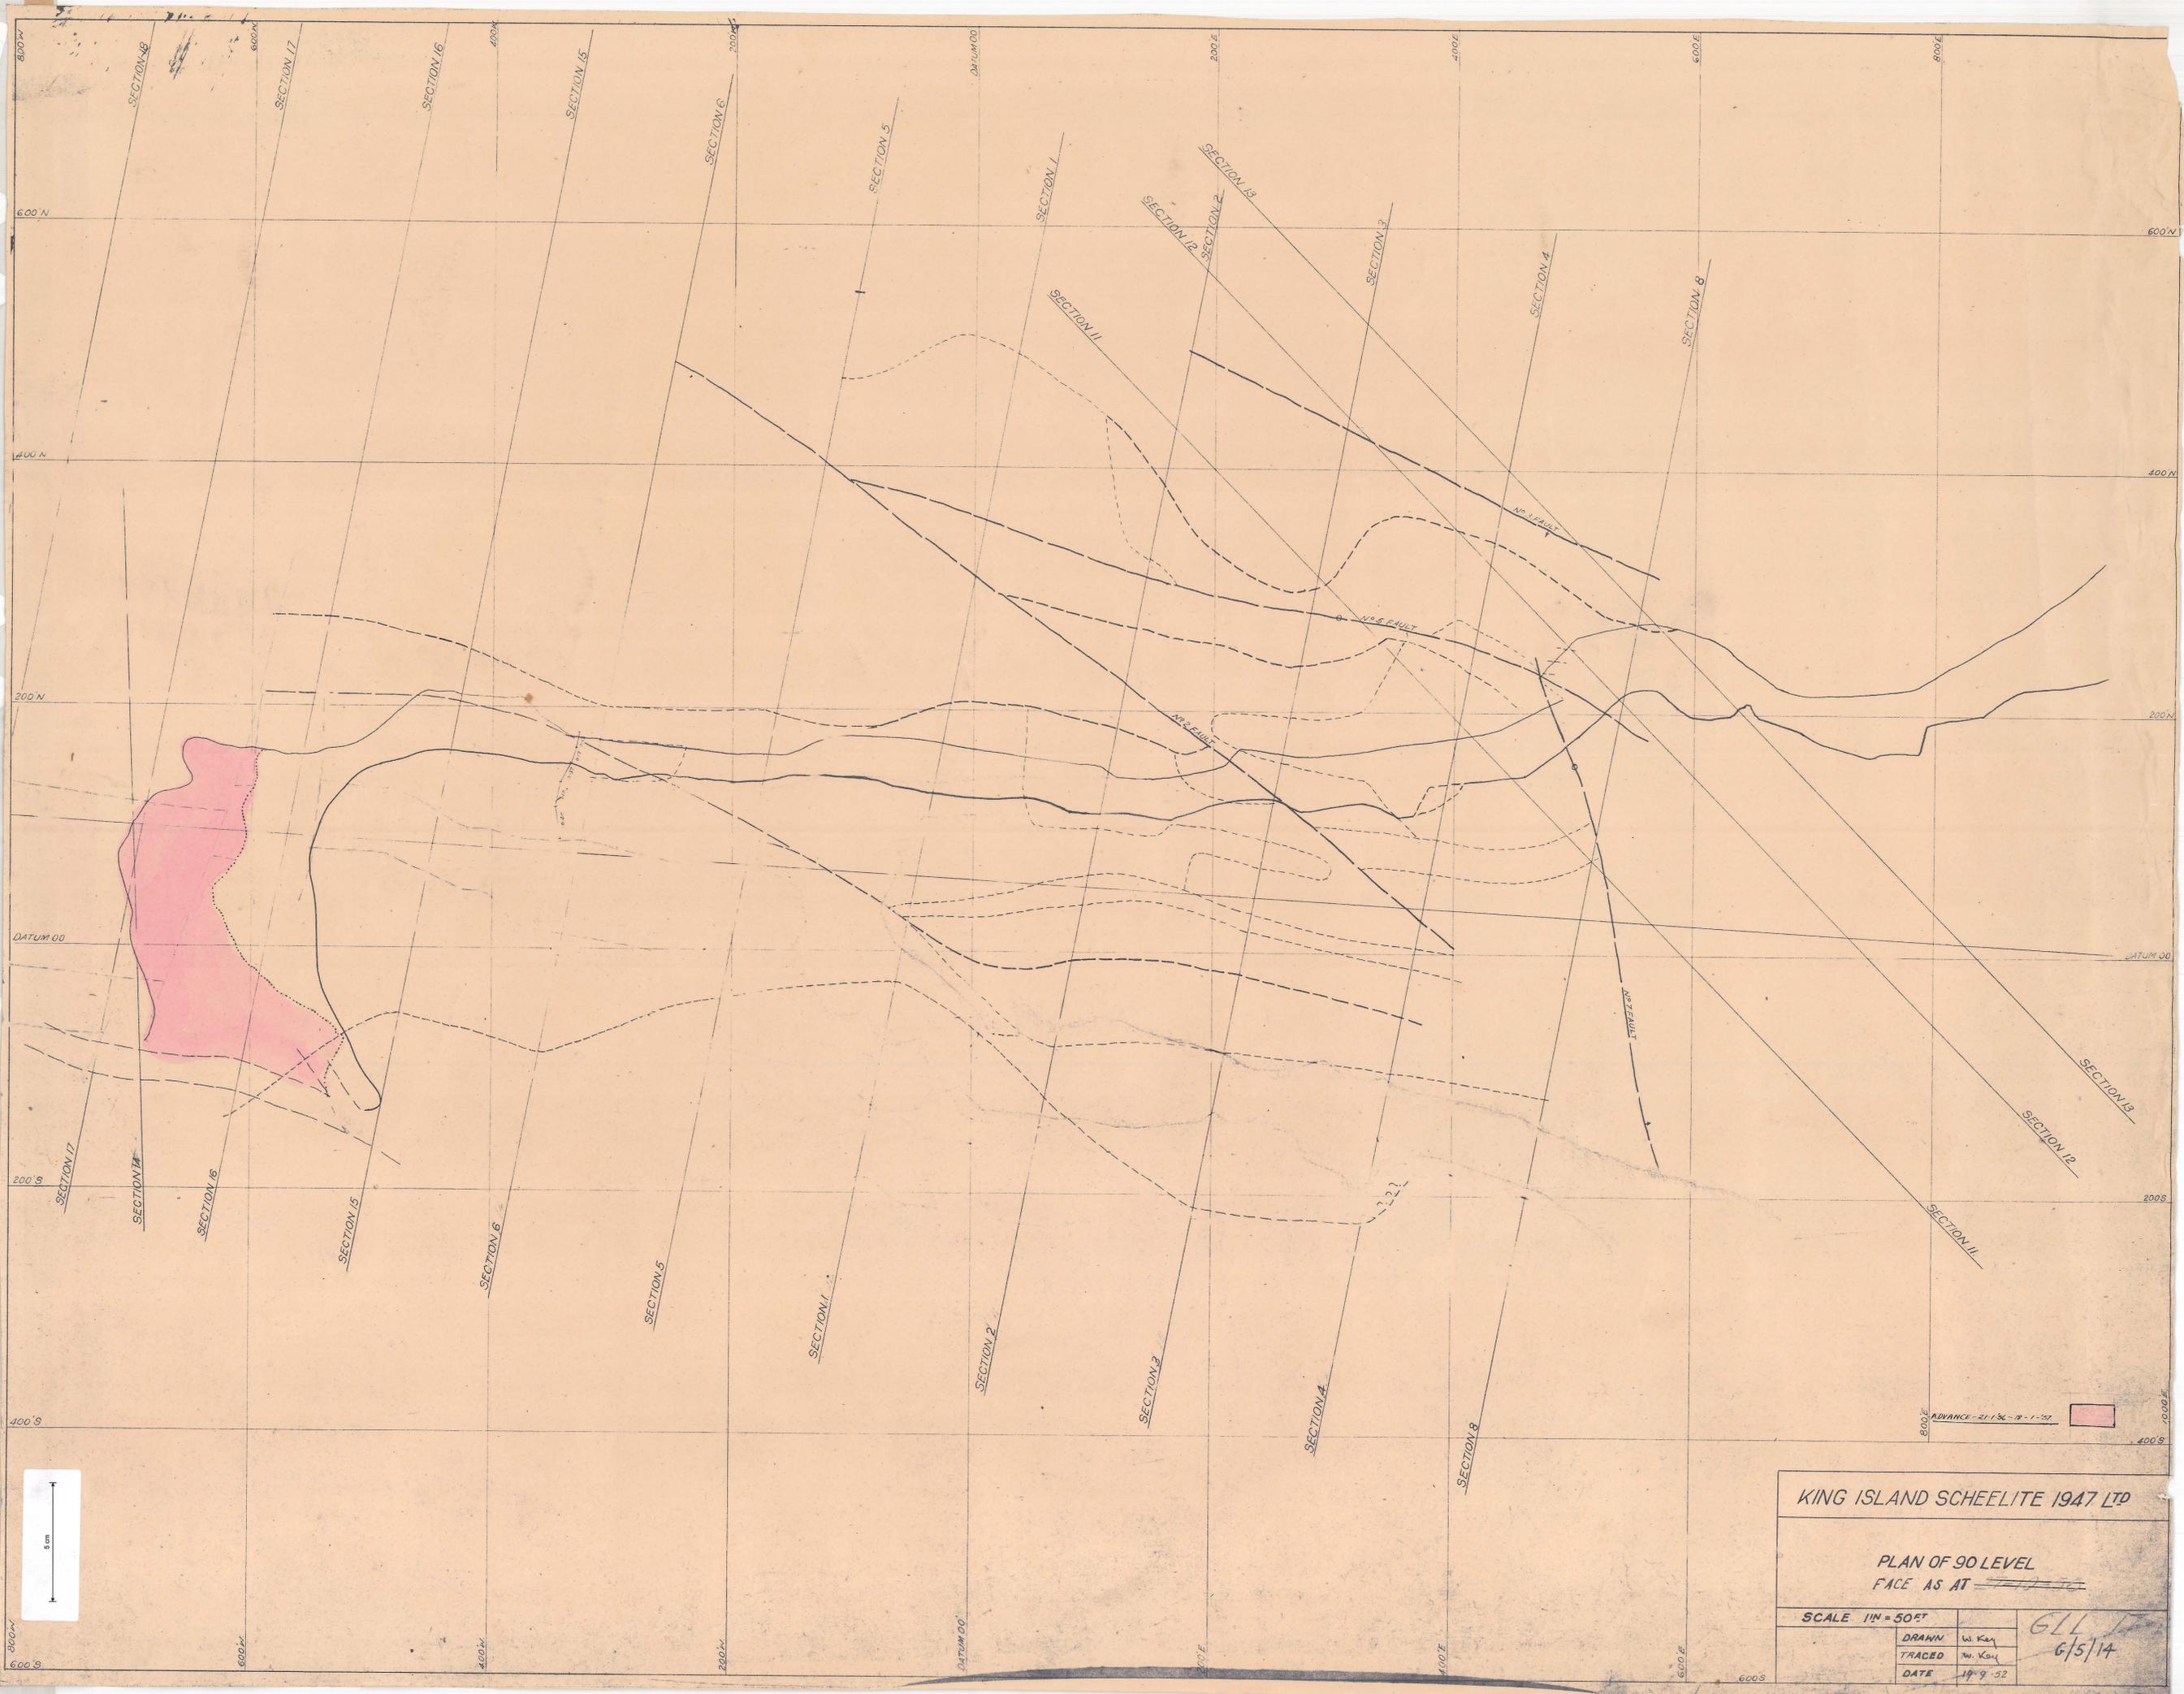

KING ISLAND SCHEELITE 1947 LTD

PLAN OF 90 LEVEL  
FACE AS AT ~~1/1/52~~

SCALE 1" = 50 FT	
DRAWN	W. Kay
TRACED	W. Kay
DATE	19-9-52

6/5/14

ADVANCE - 21/36 - 18 - 1 - 52