
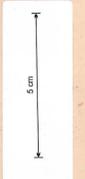


STY 06

274-06

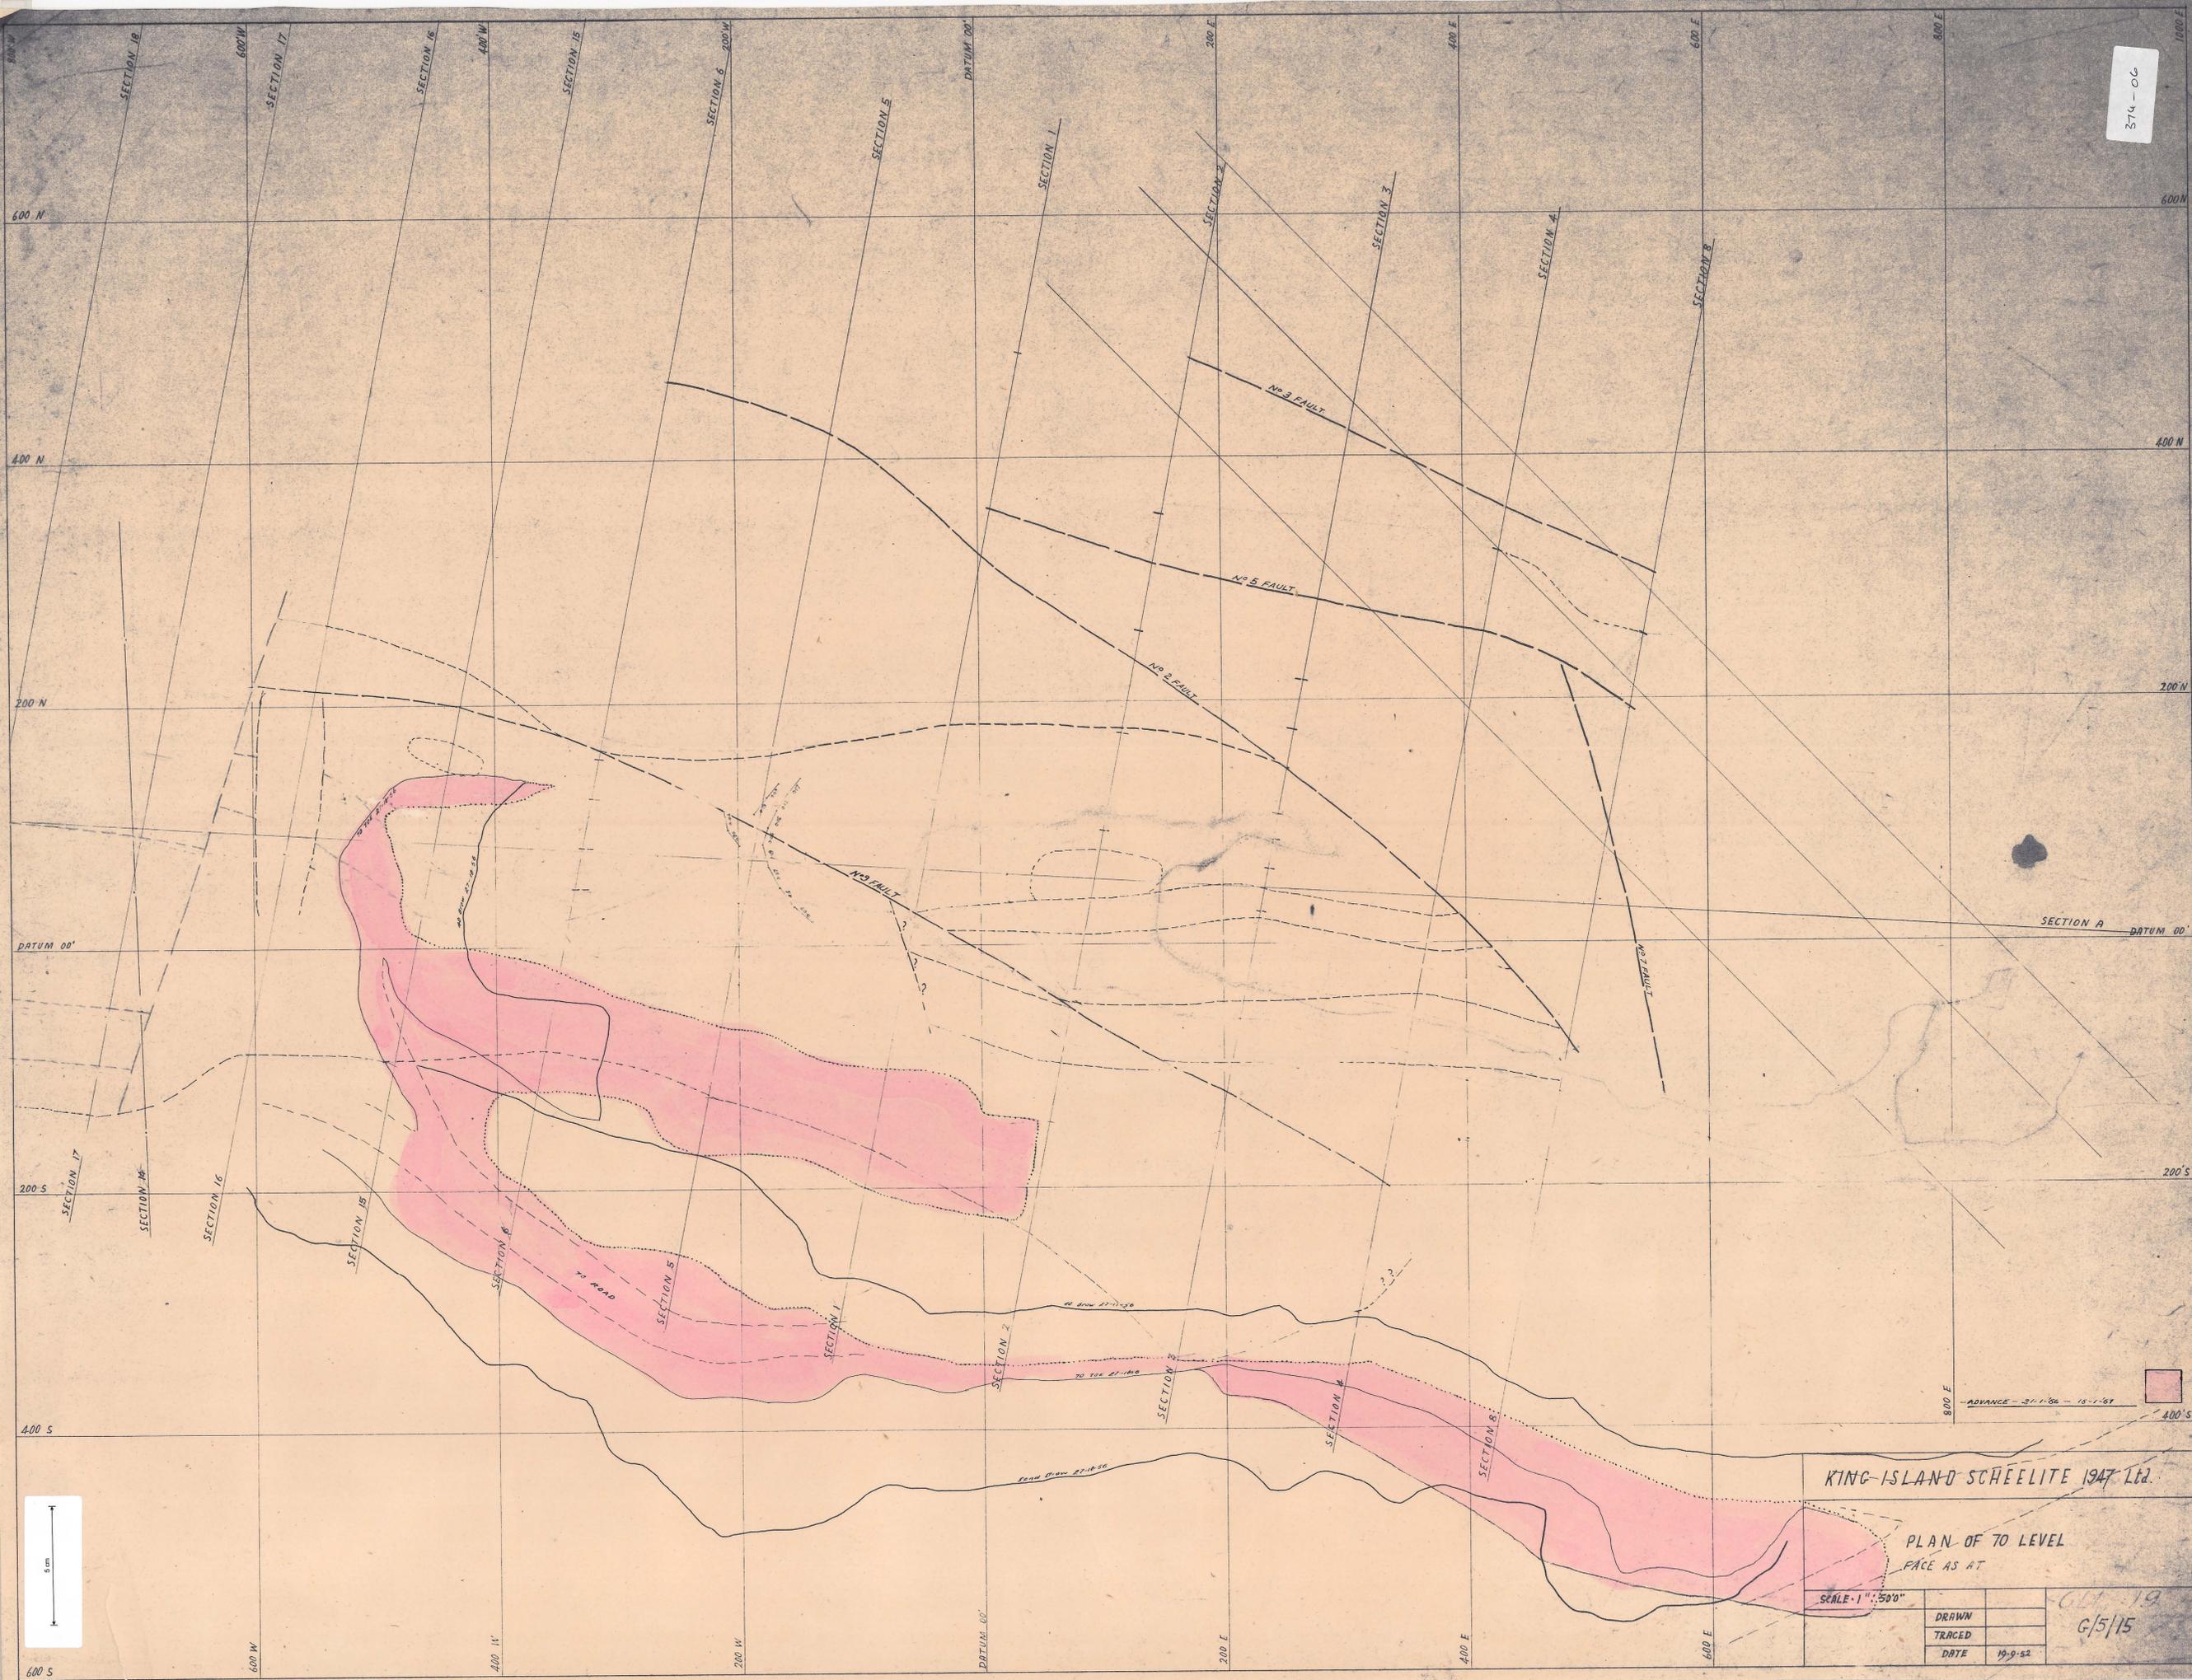

KING-ISLAND SCHEELITE 1947 Ltd.

PLAN OF TO LEVEL
FACE AS AT

SCALE 1" = 500'

DRAWN	
TRACED	
DATE	19-9-52

611 19
6/5/15