


3-14
-07

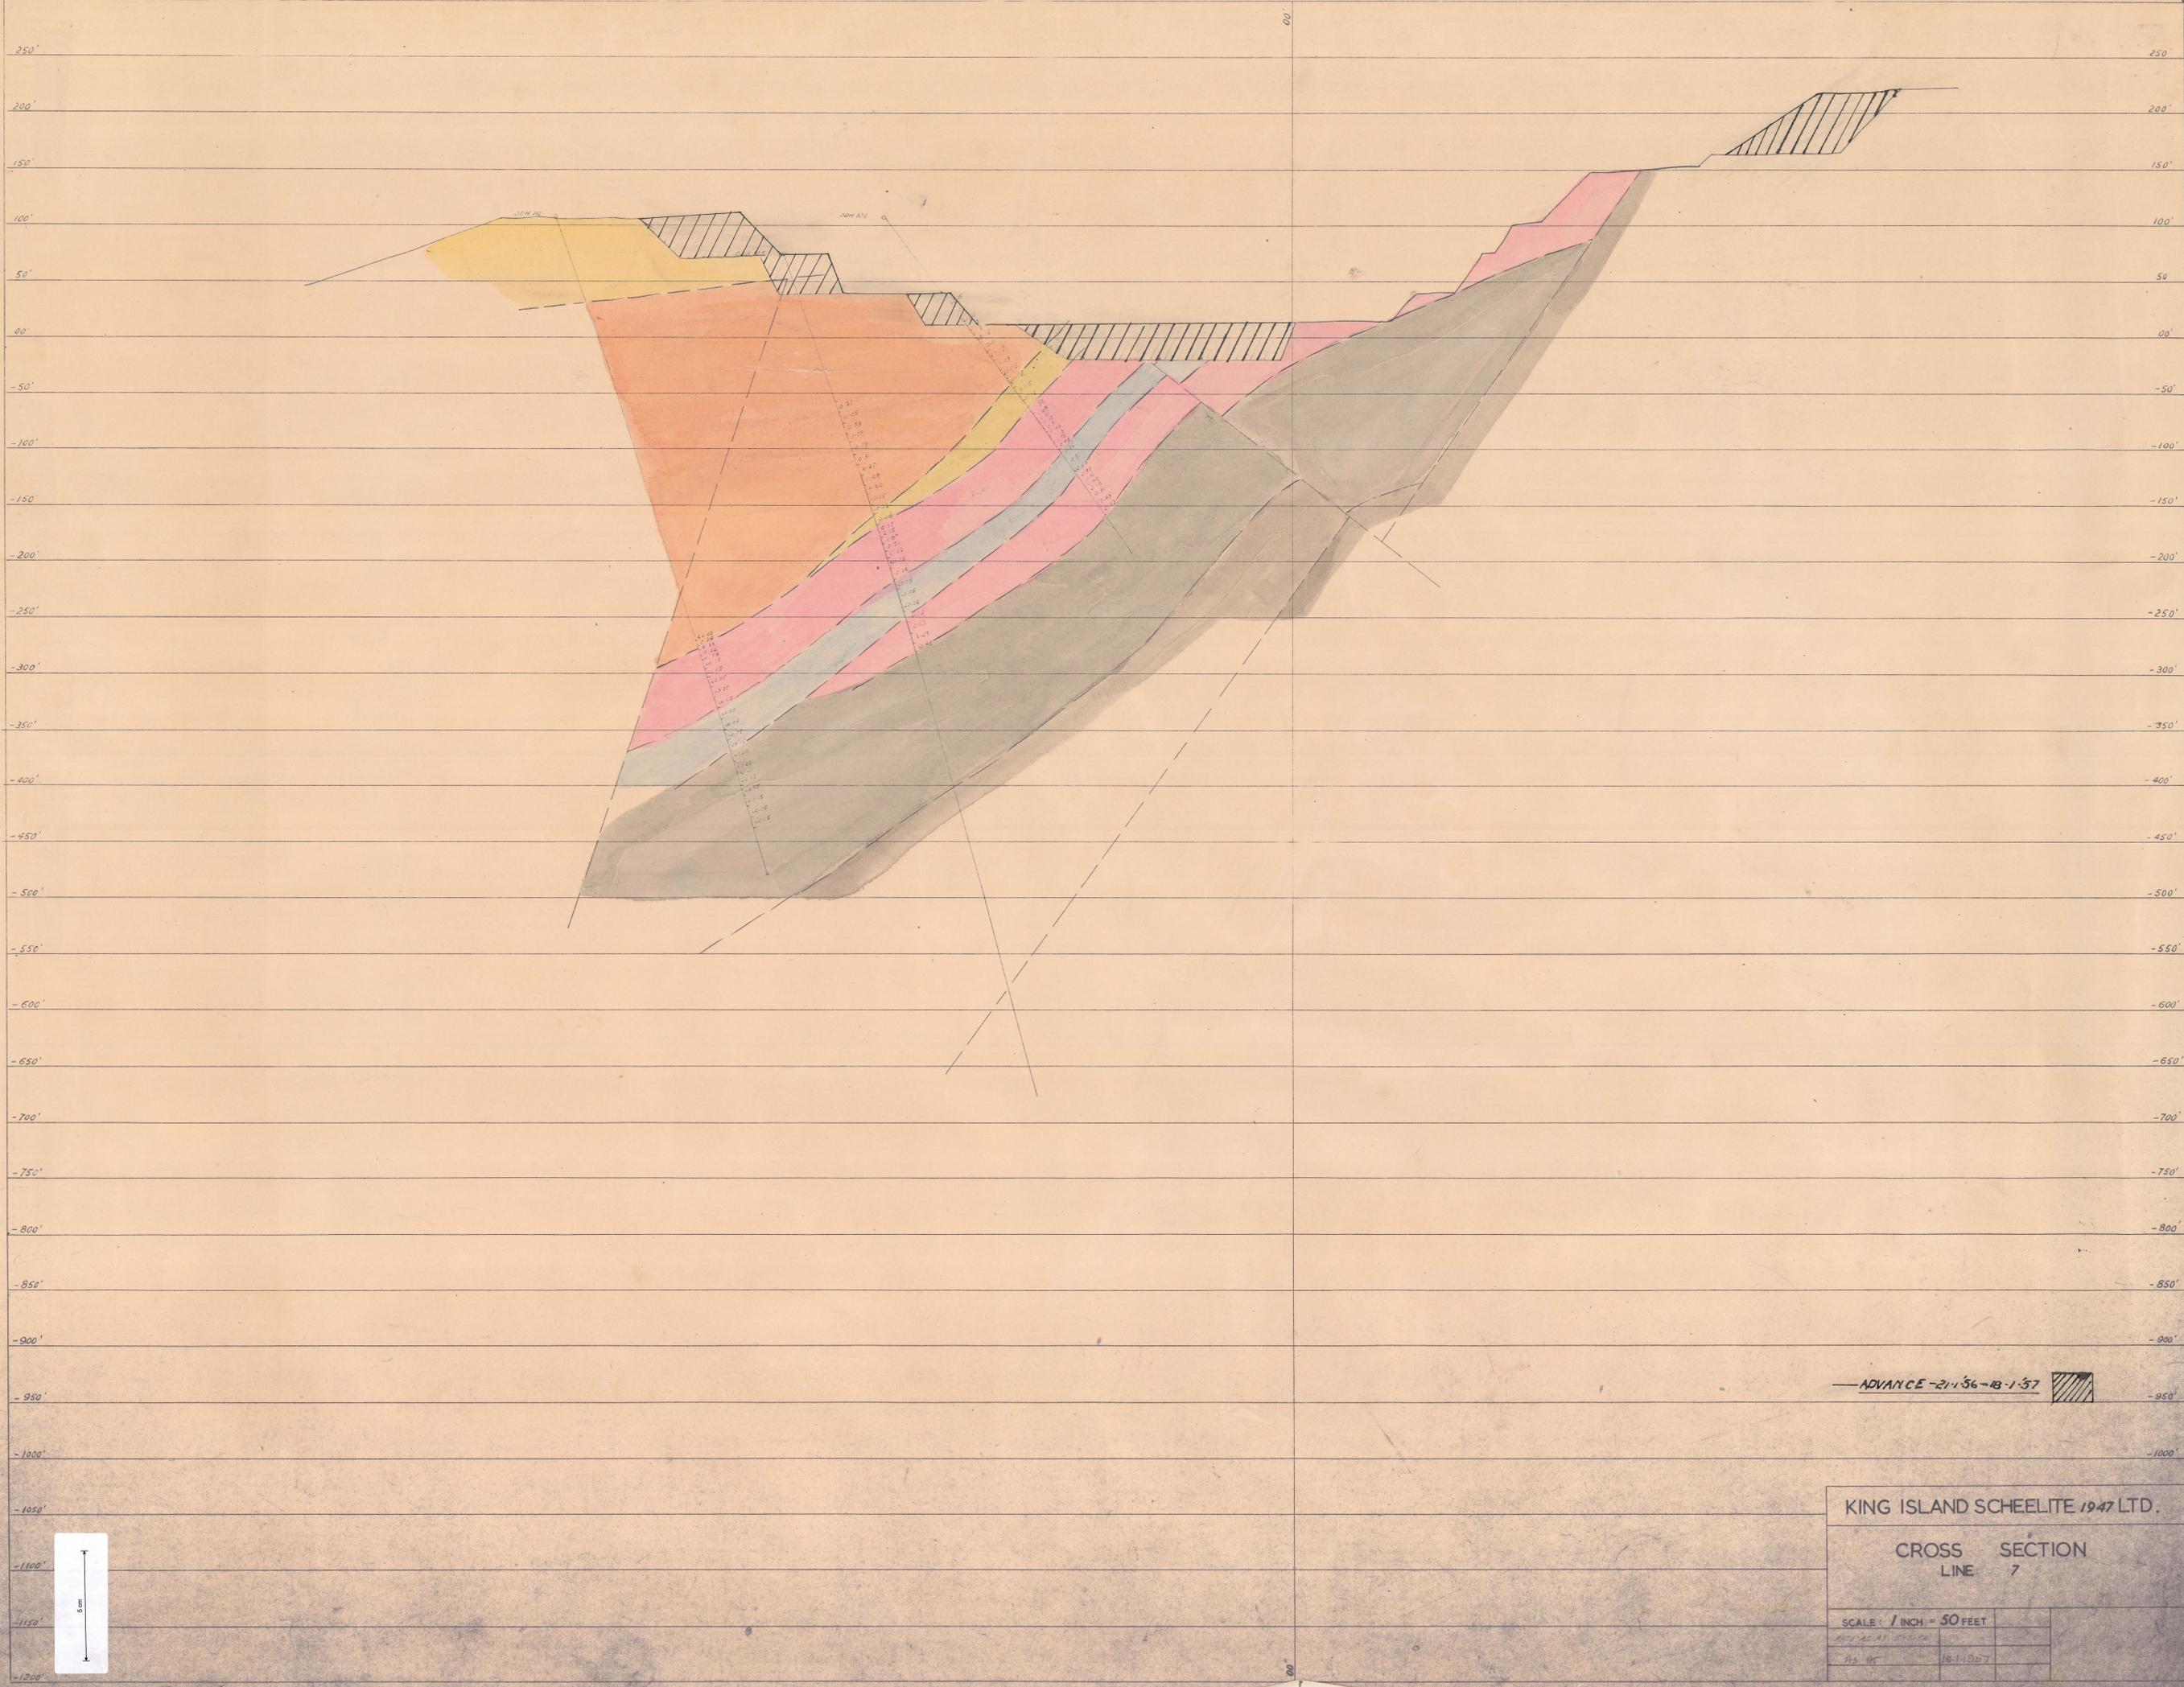

ADVANCE -21-56-13-1-57

KING ISLAND SCHEELITE 1947 LTD.

CROSS SECTION
LINE 7

SCALE: 1 INCH = 50 FEET

AS AT 18-1-57

