

SOUTH

NORTH

350

300

250

200

150

100

50

00

-50

-100

-150

-200


-250

-300

-350

-400

-450

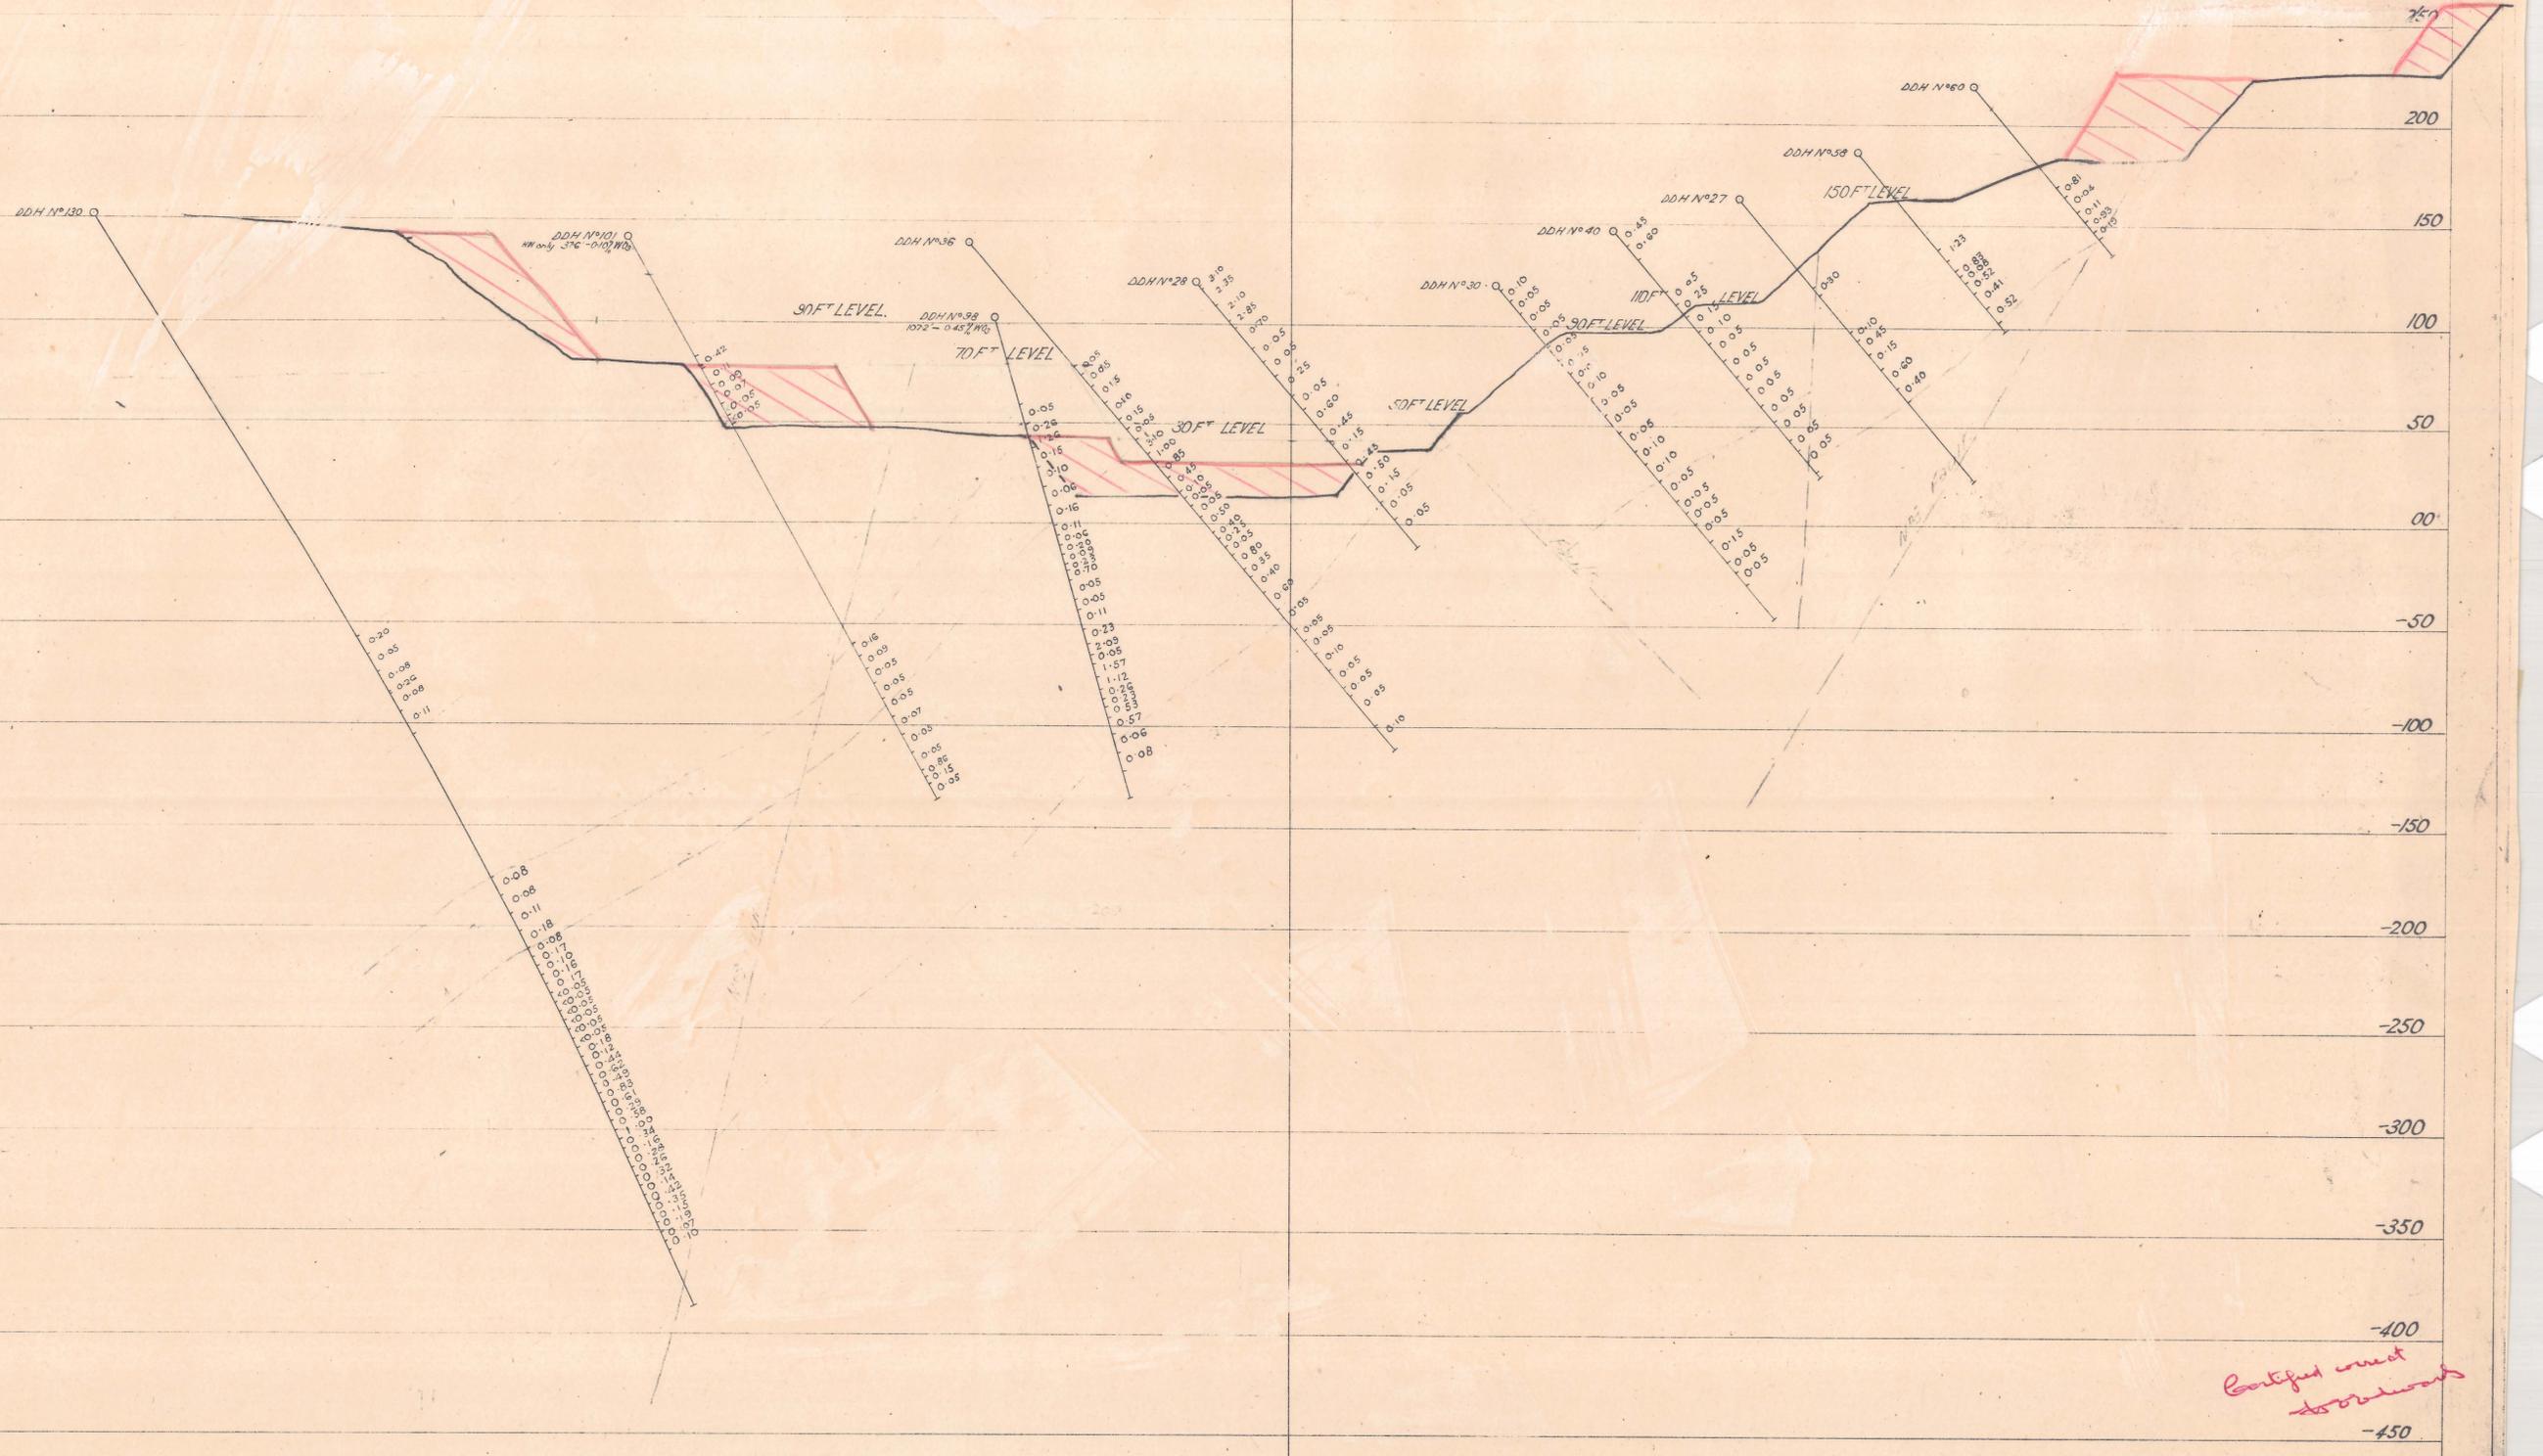

KING ISLAND SCHEELITE (1947) LIMITED


ASSAY CROSS SECTIONS

LINES 9, 10.

AS AT 12.9.55

SCALE: 1 inch = 50 feet

DRAWN	
TRACED	
DATE	

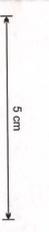

*Corrected west
downwards*

LINE 9.

314
-26

314
-26