


350
300
250
200
150
100
50
00
-50
-100
-150
-200
-250
-300
-350
-400
-450

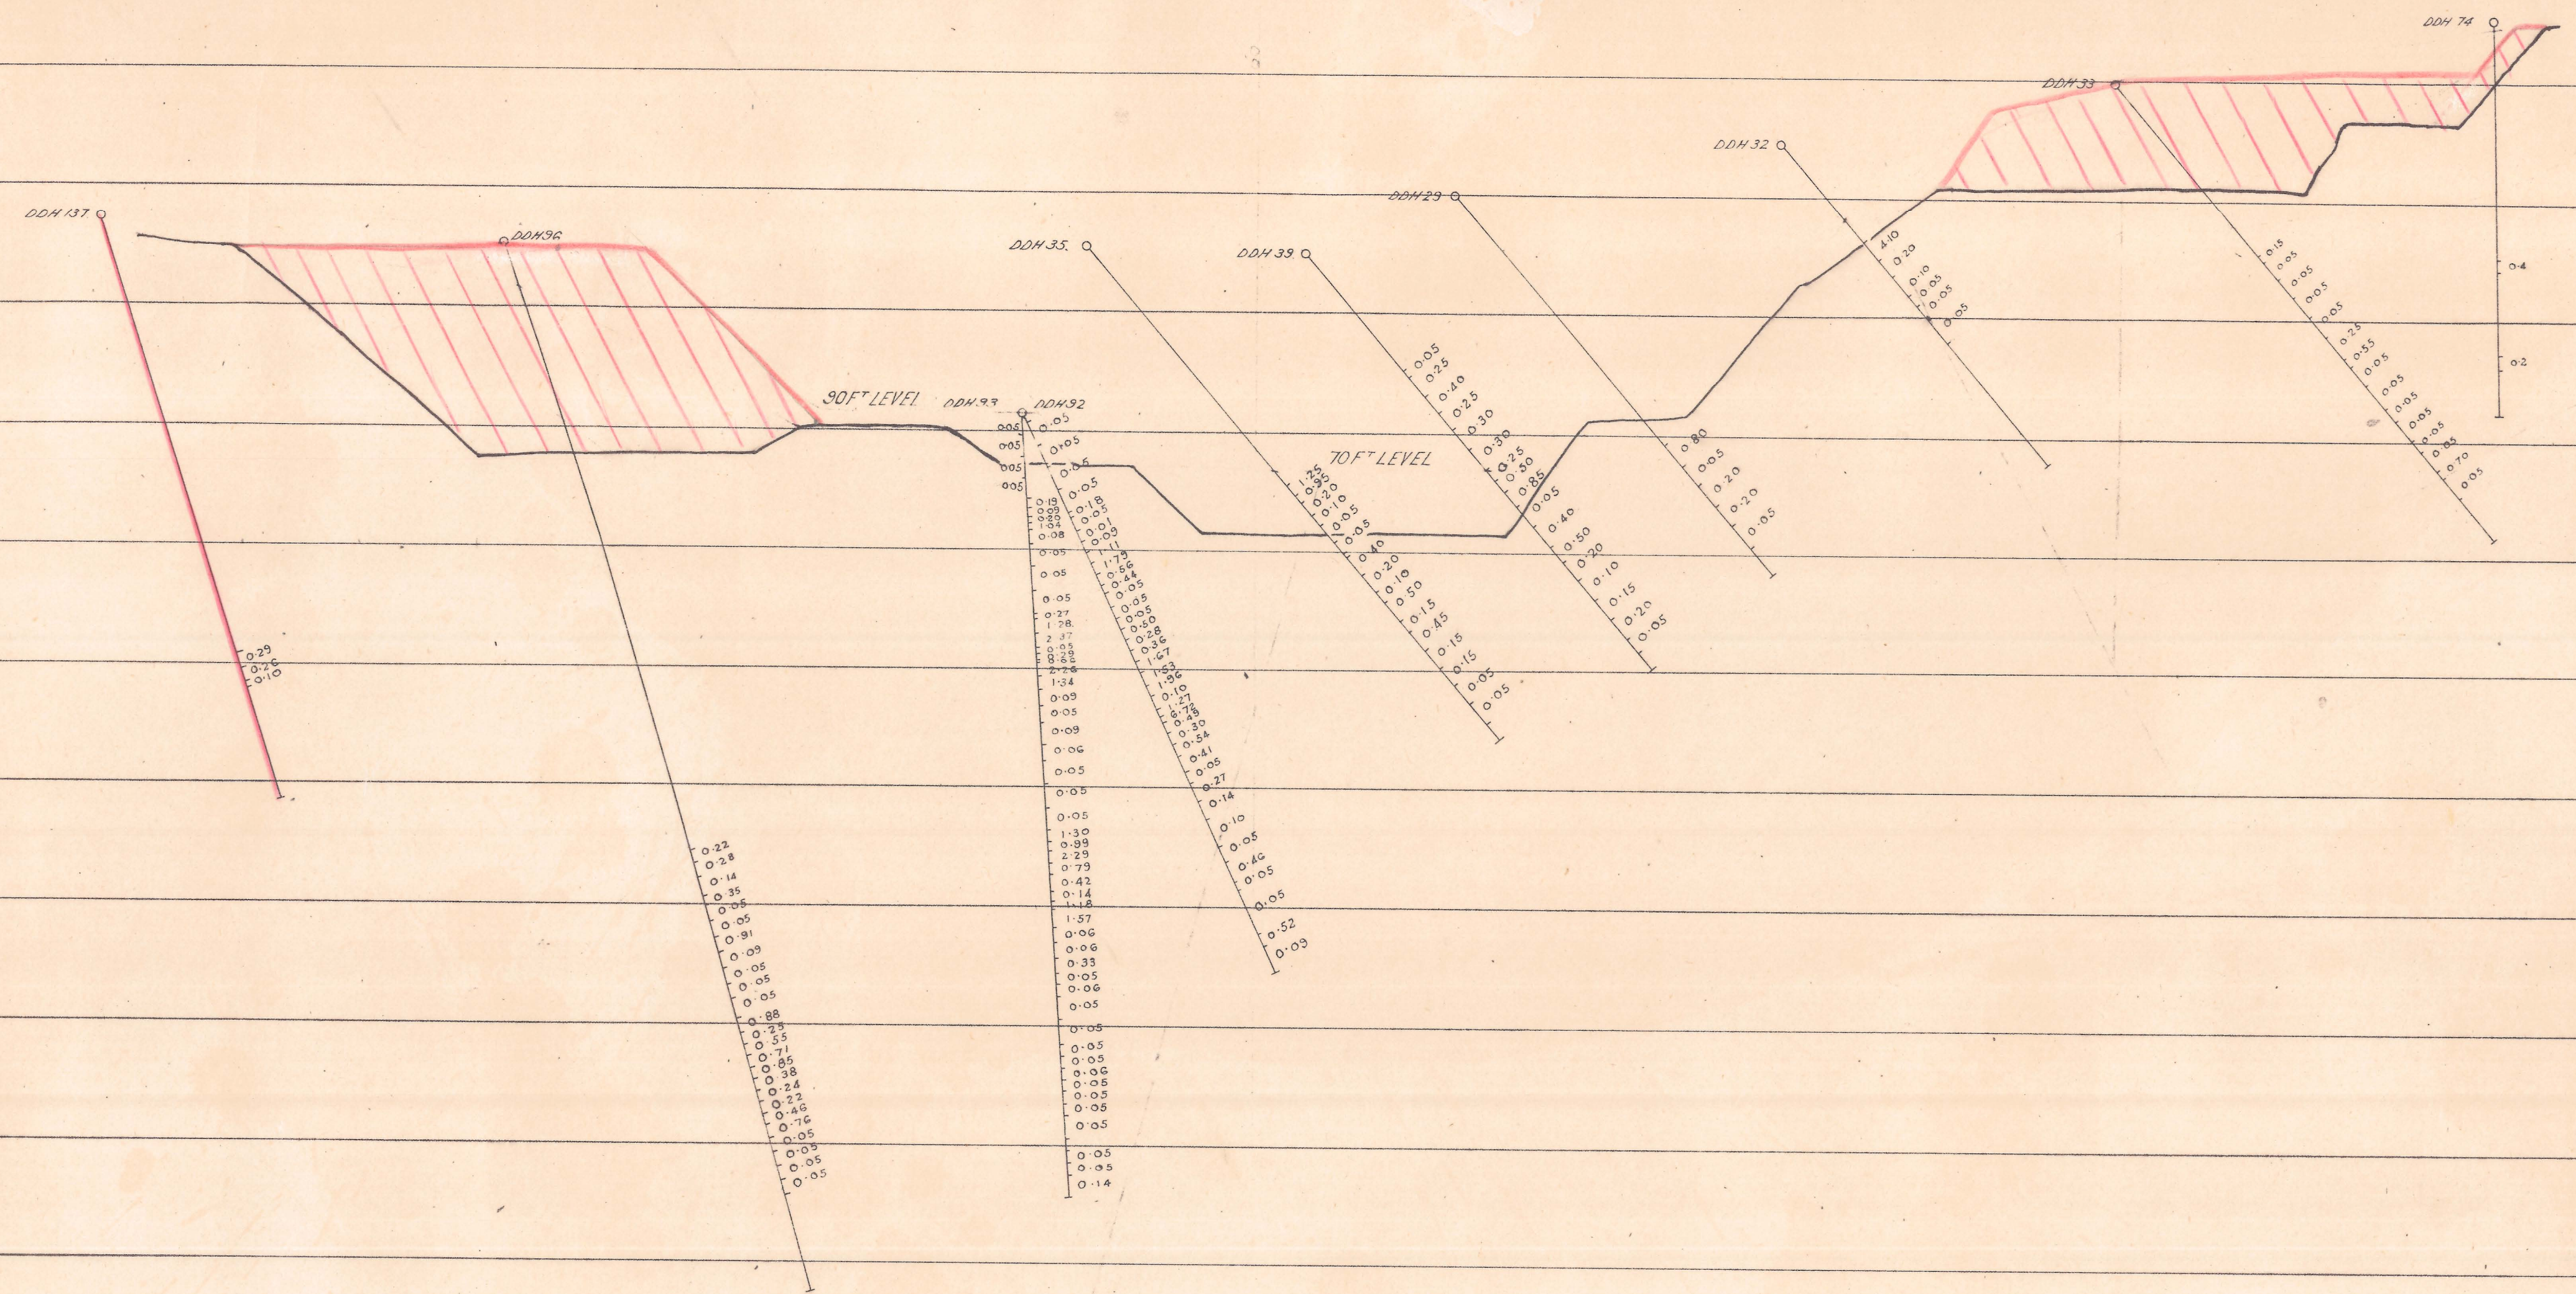

KING ISLAND SCHEELITE (1947) LIMITED.

ASSAY CROSS SECTIONS
LINES 11, 12.

AS AT 12.9.55

SCALE: 1 inch = 50 feet

DRAWN	
TRACED	
DATE	

5 cm

Corrected contour
downwards

LINE 12.

314
-27

314
-27