


0374-042

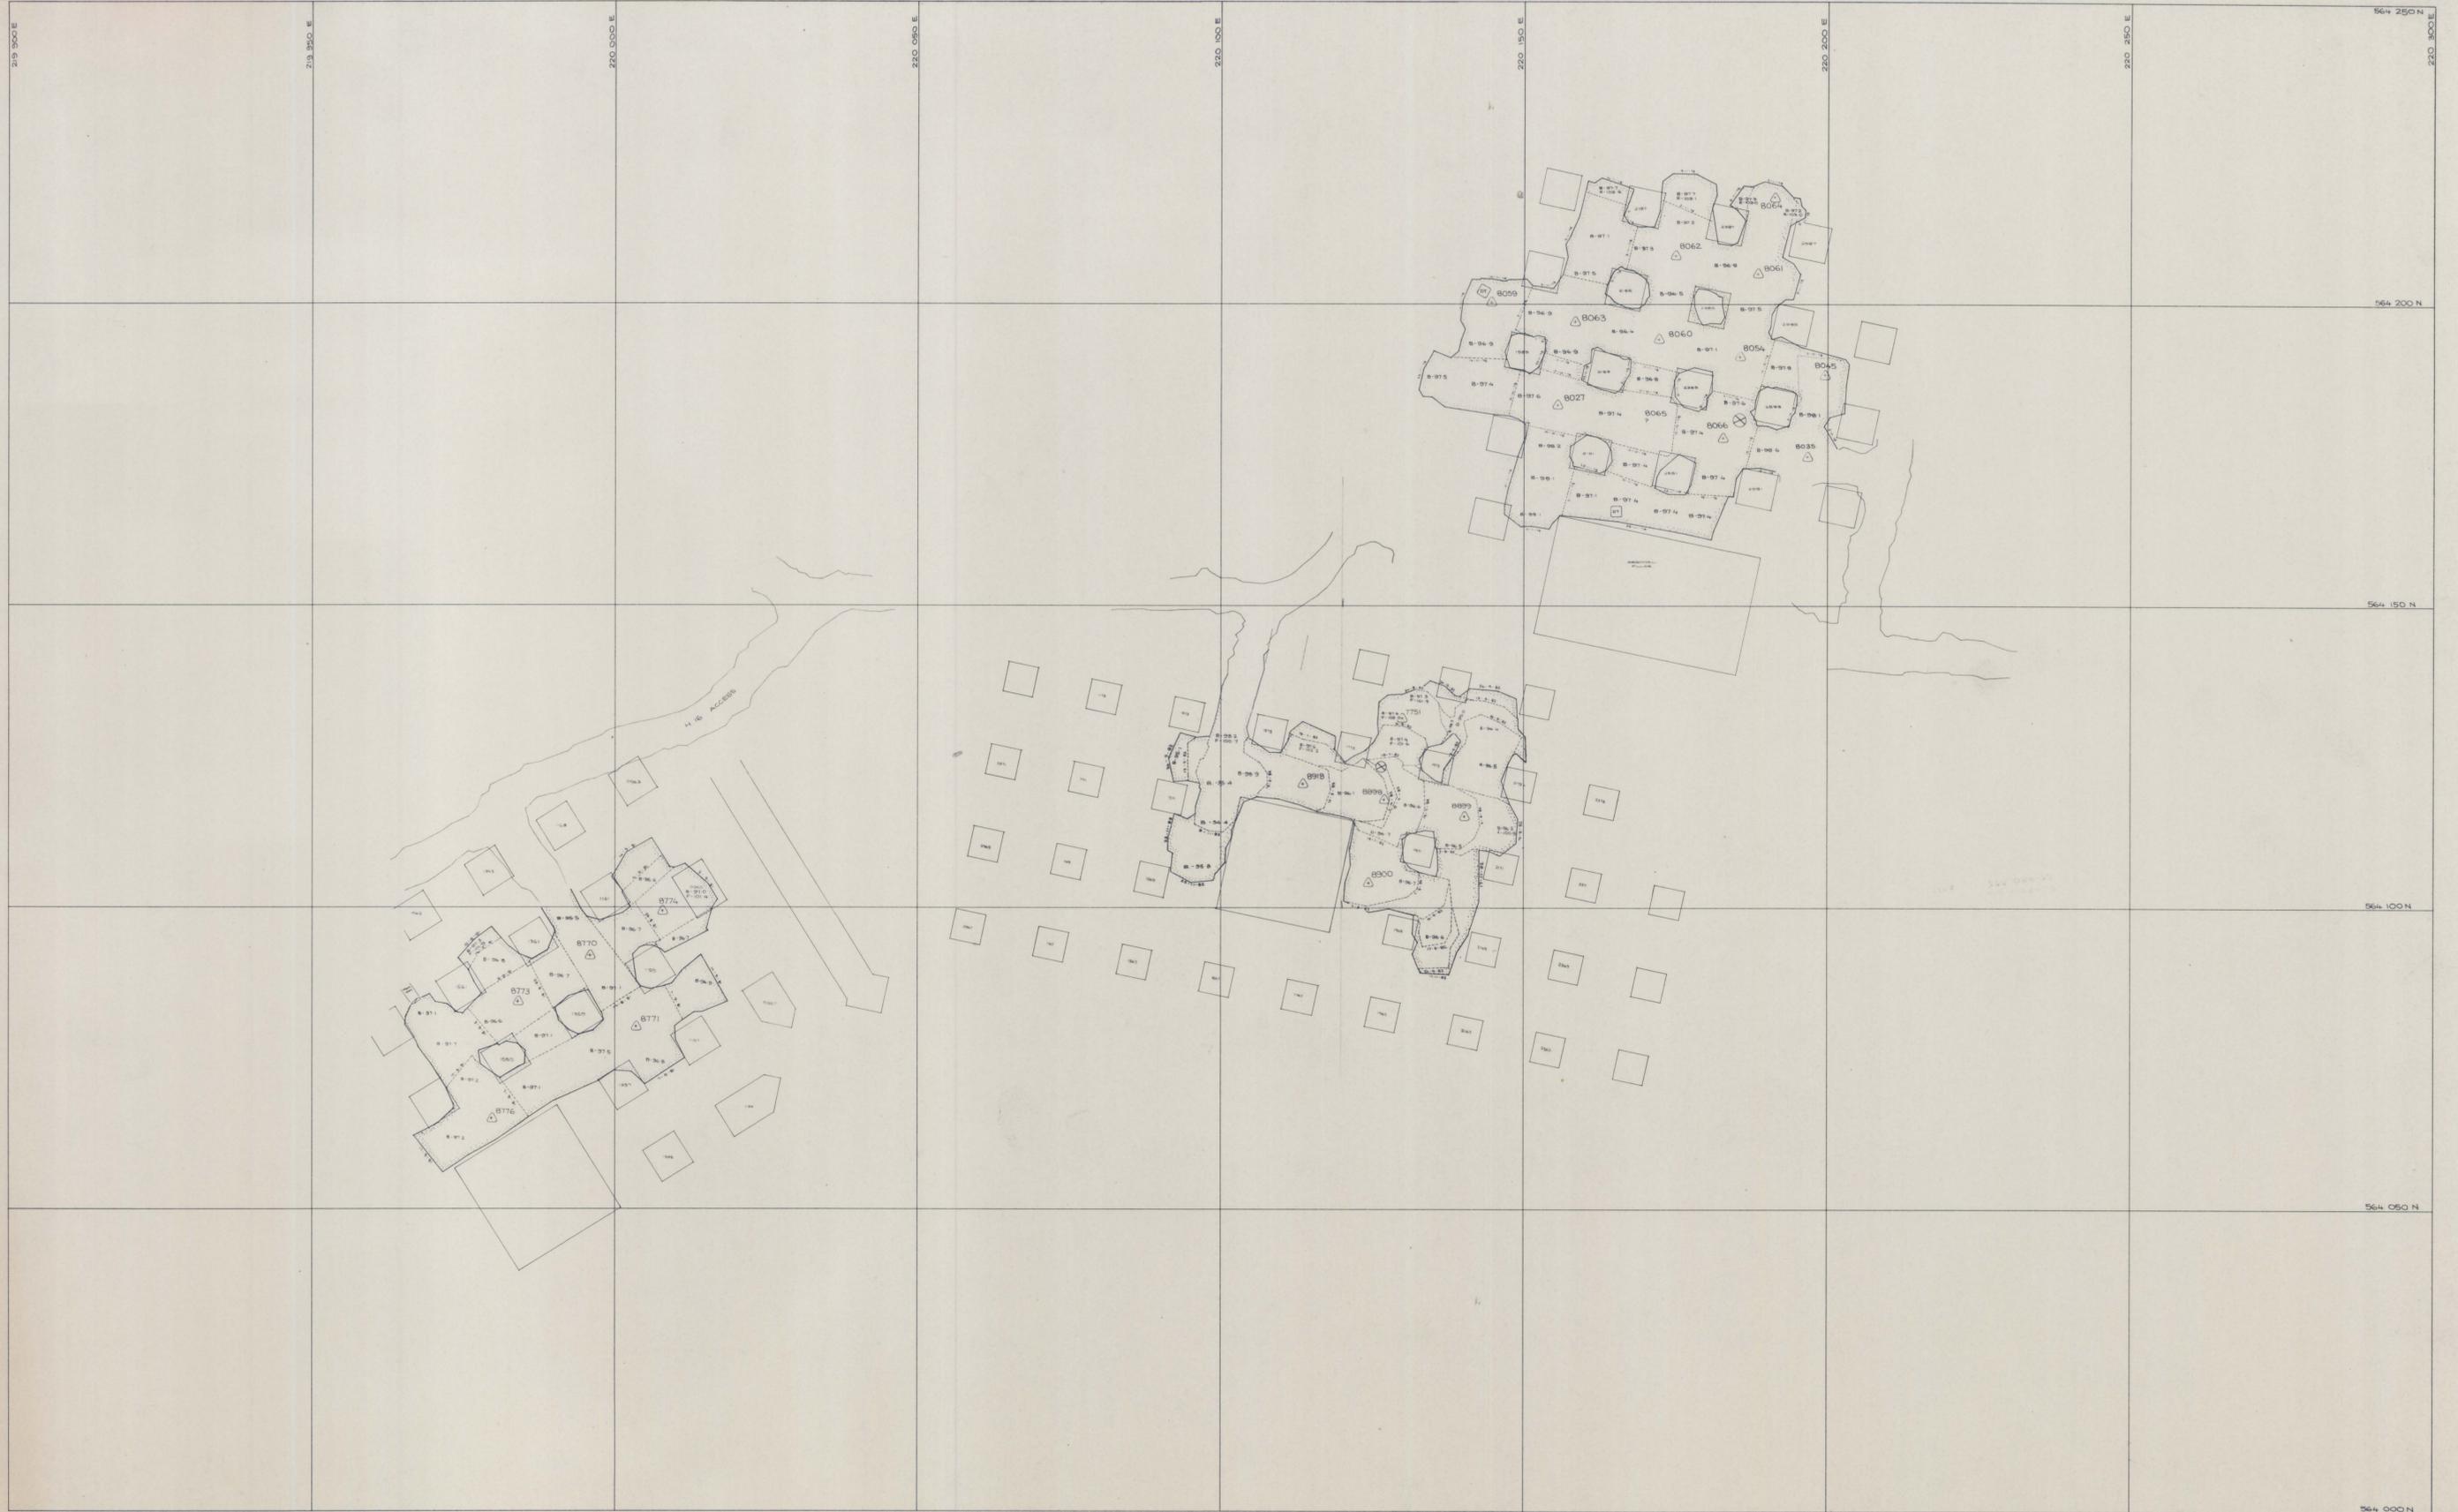

|   |  |   |
|---|--|---|
| <p>SCALE 1:500</p> <p>C WEDGE STOPE - LIFT NR 9<br/>         C CENTRAL STOPE - LIFT NR 14<br/>         C PIT STOPE - LIFT NR 15</p> <p>5 cm</p> | <p>LOCATION DOLPHIN MINE</p> <p>SUBJECT C WEDGE STOPE -101m CONTOUR<br/>         PIT -100m CONTOUR<br/>         CENTRAL</p> <p>north</p> | <p><b>KIS</b> KING ISLAND SCHEELITE<br/> <small>A DIVISION OF WARMAN INTERNATIONAL</small></p> <p>GRASSY KING ISLAND</p> <p>PLAN NUMBER 04DM15 - 1014</p> |
|---|--|---|

833439