
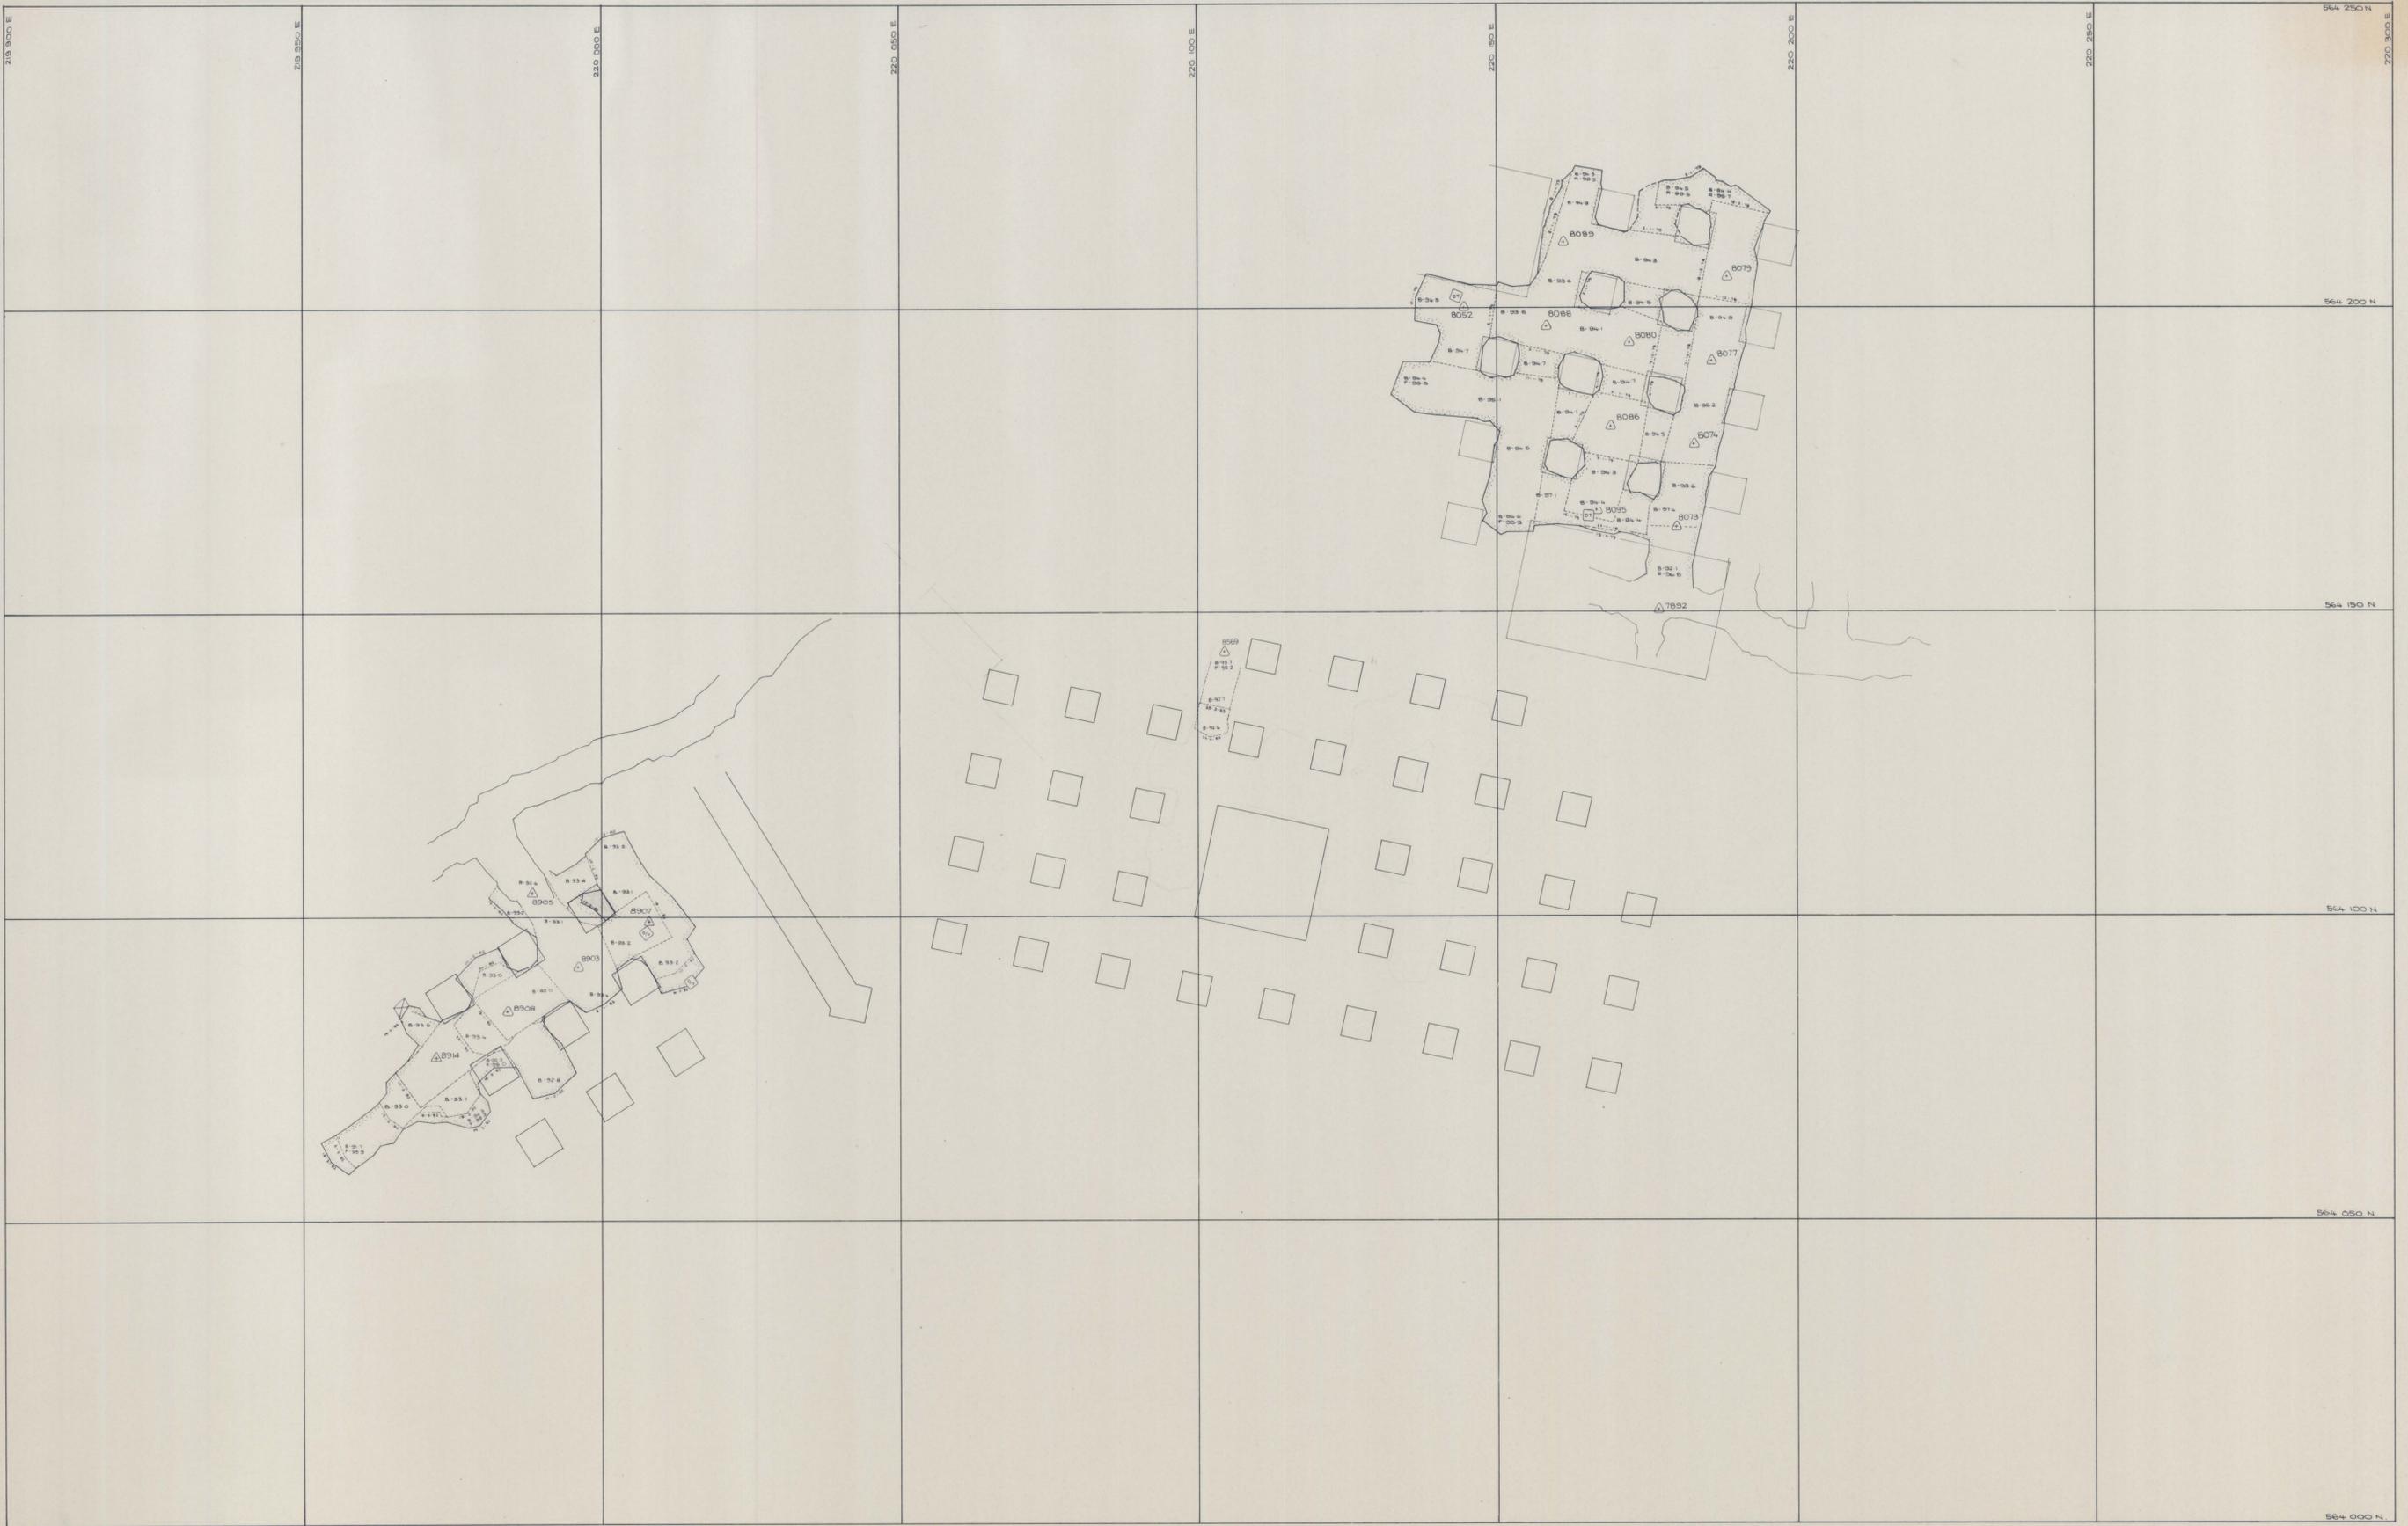
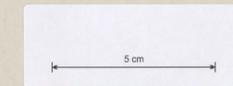


0374-043

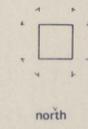

<p>SCALE 1: 500</p> <div style="text-align: center;">  <p>5 cm</p> </div>	 <p>north</p>	<p>LOCATION DOLPHIN MINE</p> <p>SUBJECT</p> <p>C WEDGE STOPE -98 m CONTOUR  PIT -96.5 m  CENTRAL -96.5 m</p>	 <p>KING ISLAND SCHEELITE  A DIVISION OF WARMAN INTERNATIONAL</p> <p>GRASSY KING ISLAND</p> <p>PLAN NUMBER 04DM15 - 1013</p>
--	--	--	---

83343f