
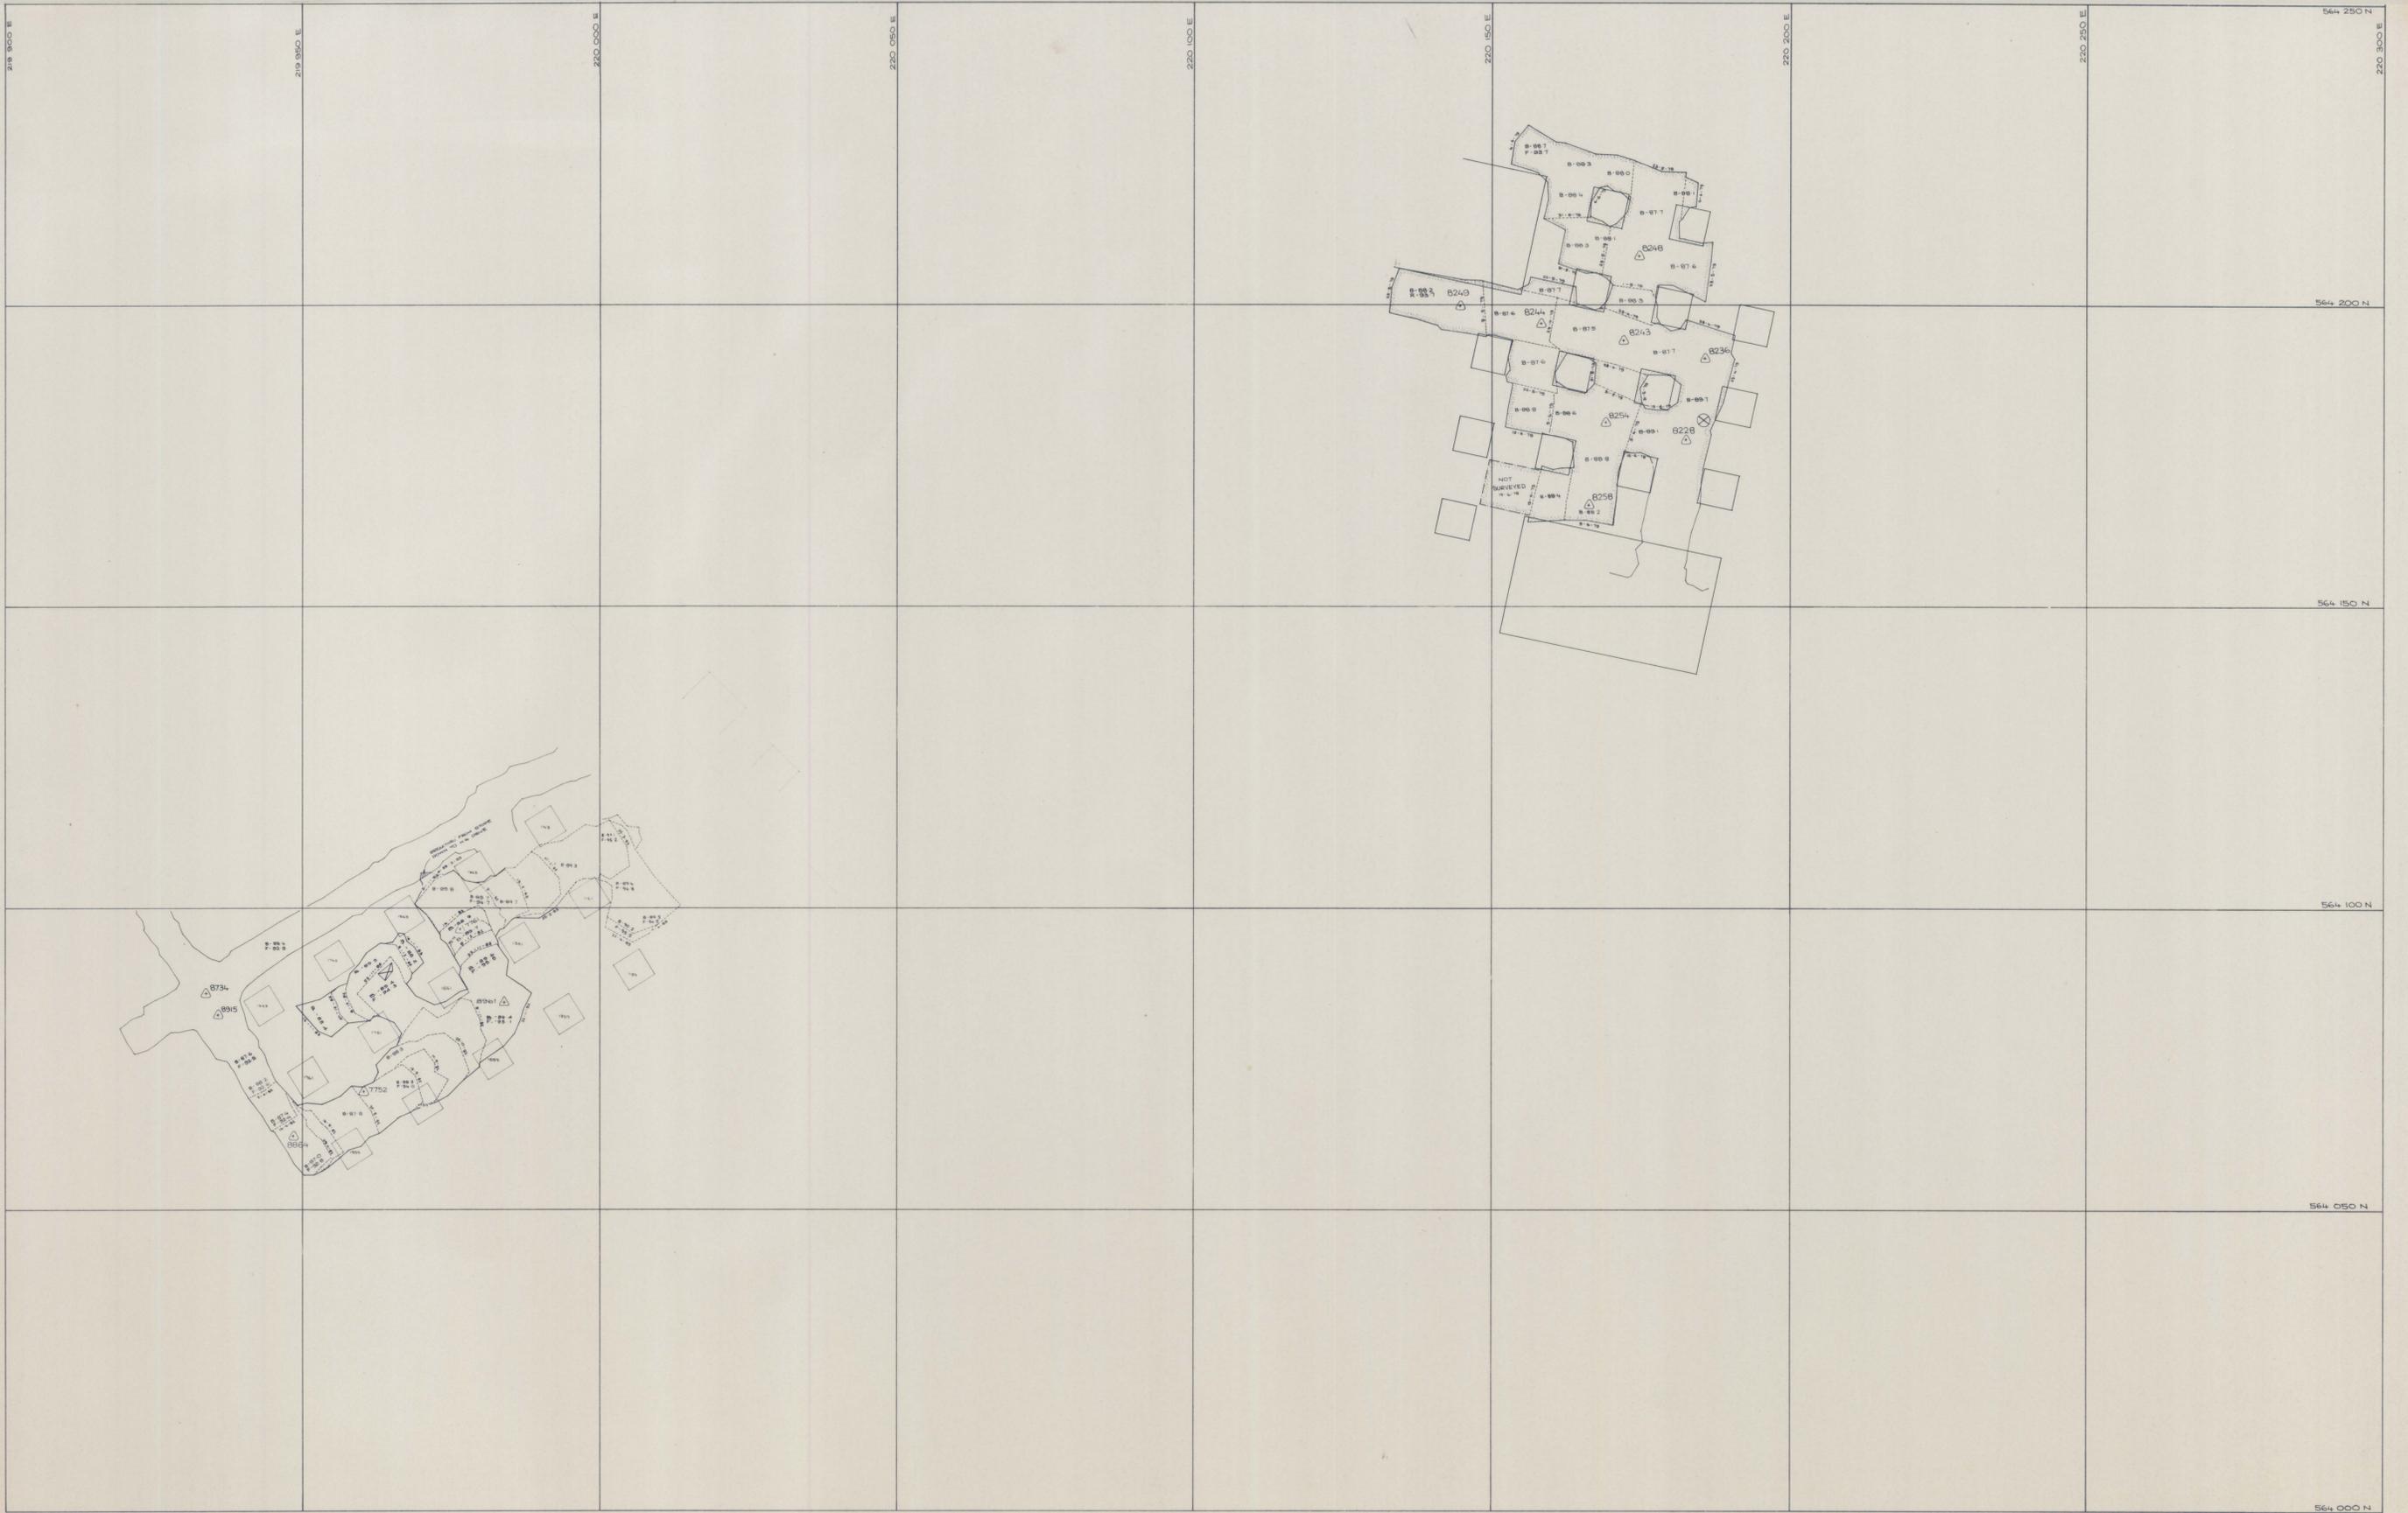


0374-044

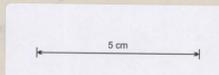

	SCALE 1:500 	LOCATION DOLPHIN MINE SUBJECT C WEDGE STOPE - 92.0m Contour PIT STOPE - 93.0m Contour CENTRAL STOPE - 93.0m Contour	 A DIVISION OF WARMAN INTERNATIONAL GRASSY KING ISLAND PLAN NUMBER 04DM15 - 1011
--	--	---	--

83343E