


0374-045



SCALE 1:500

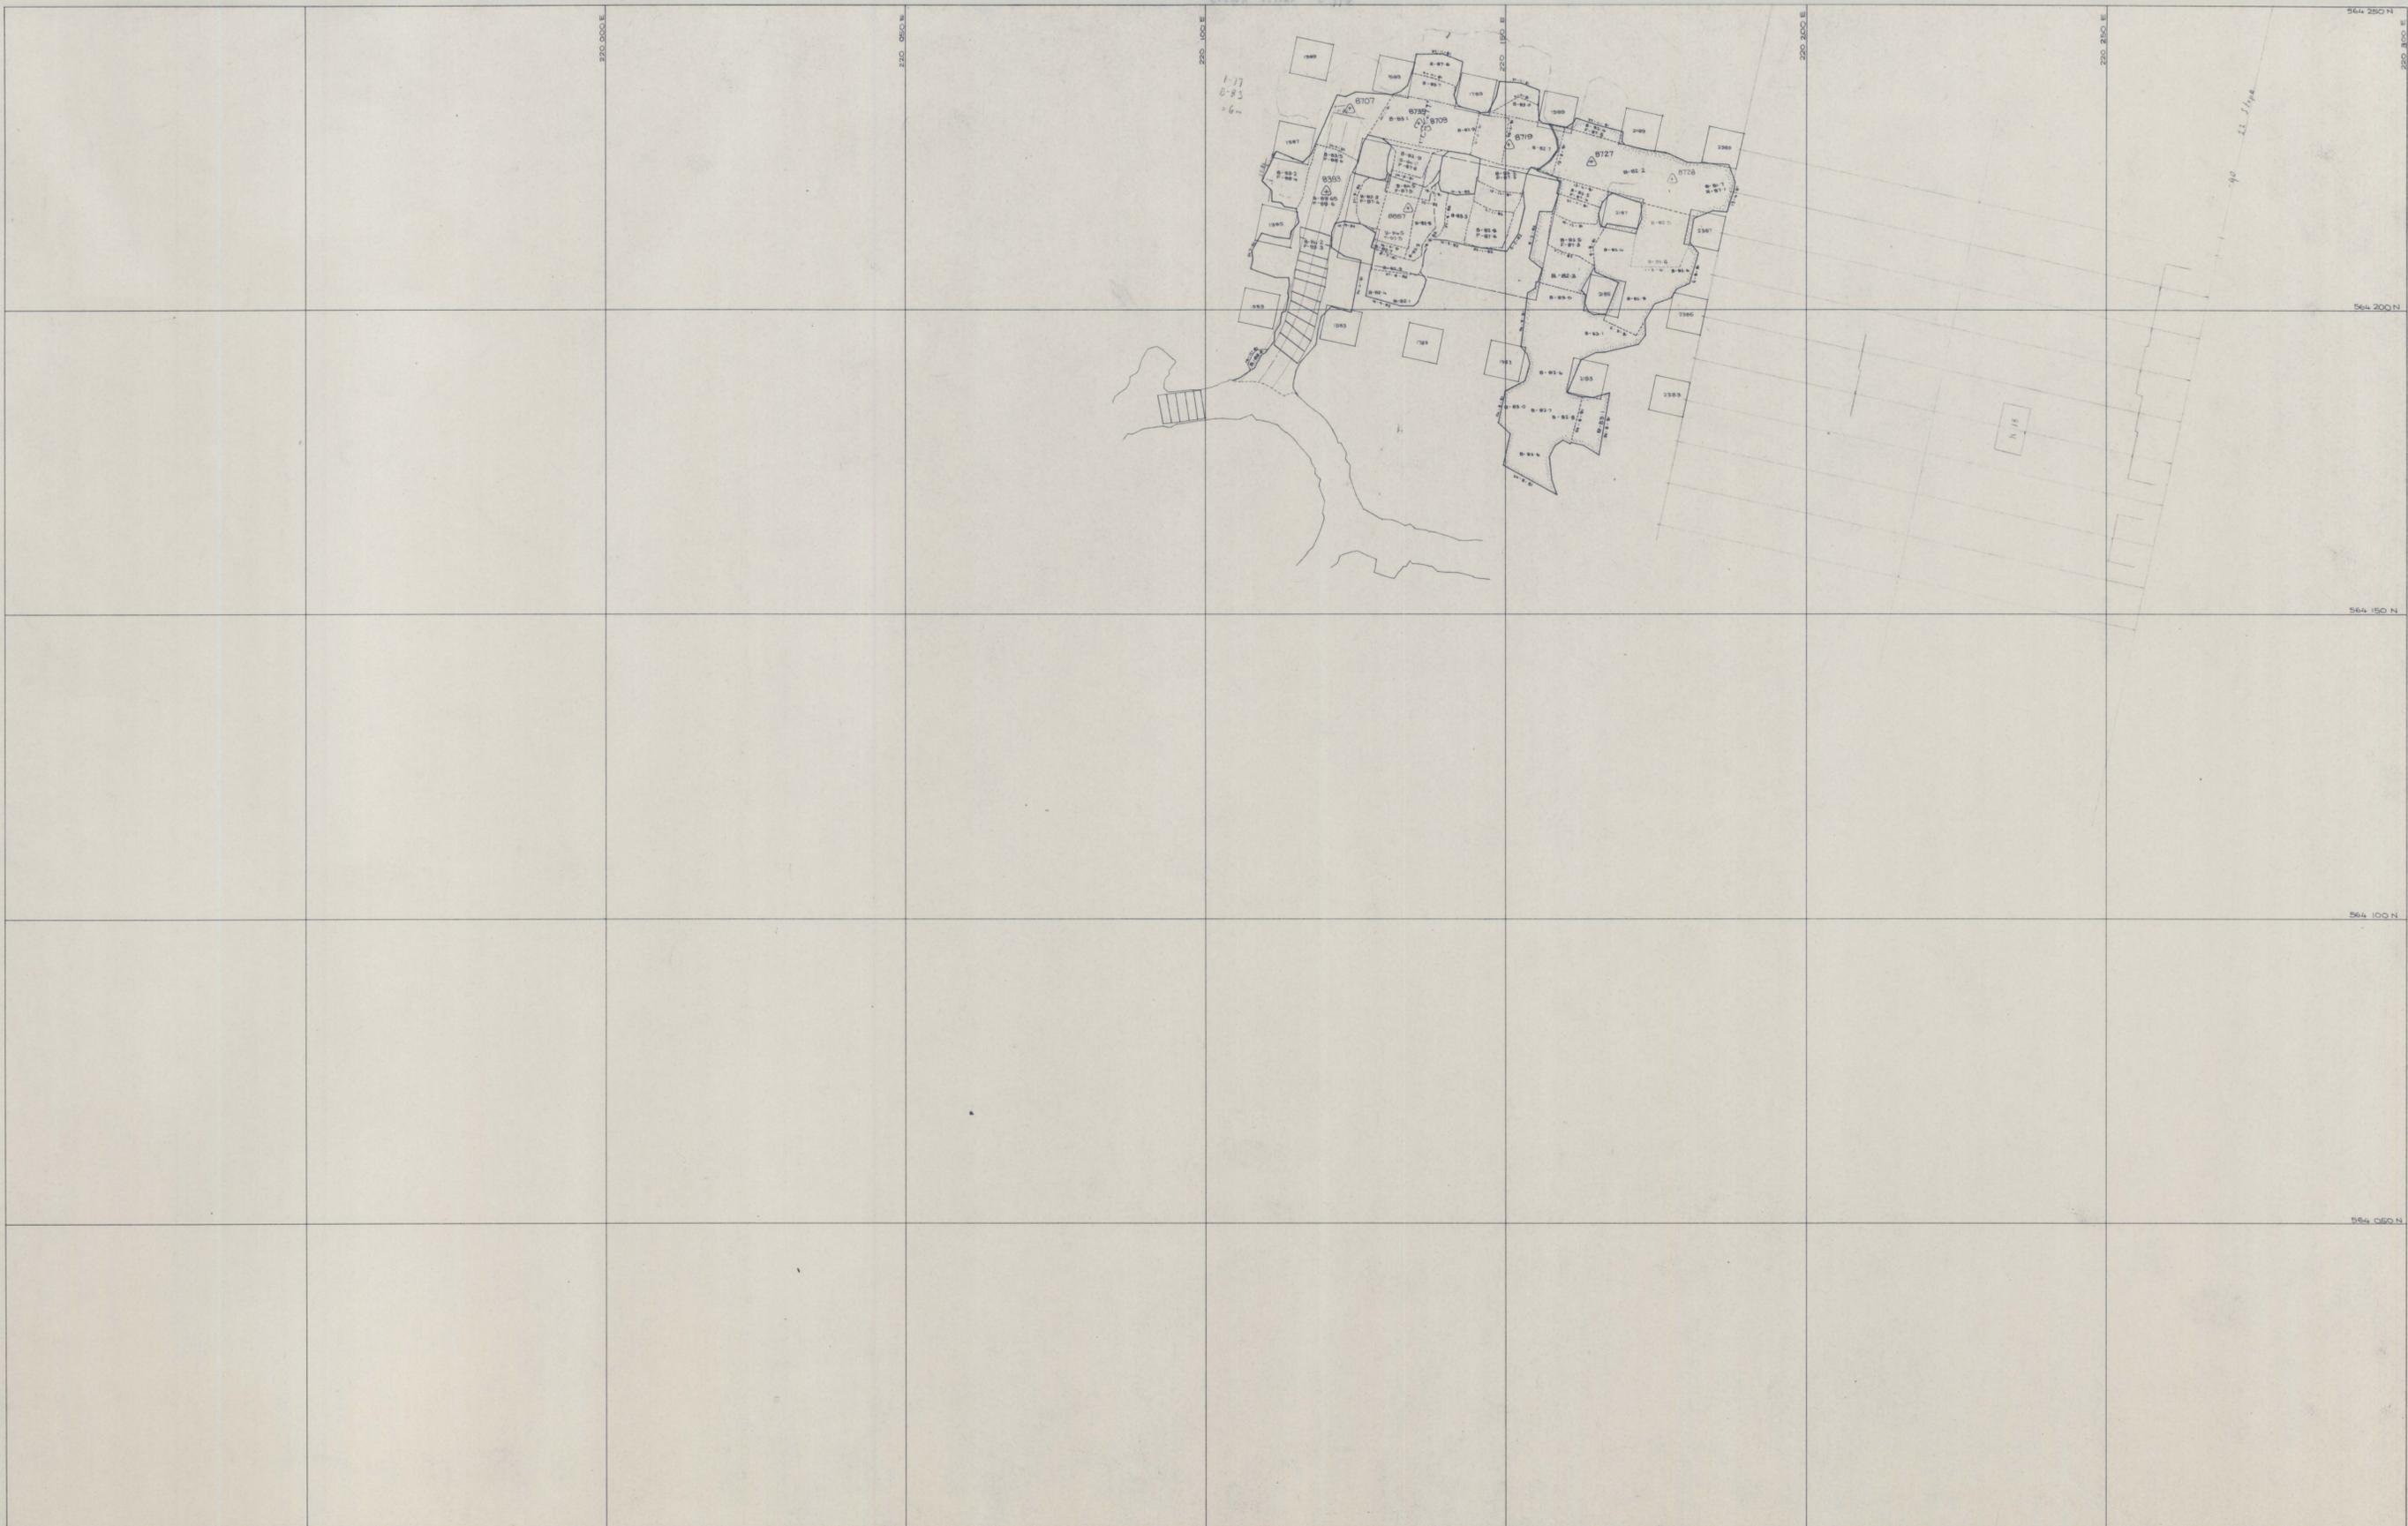

north

LOCATION

DOLPHIN MINE

SUBJECT

WEDGE STOPE
- 86m CONTOUR

30.5 m 14 m L/A

KIS KING ISLAND SCHEELITE
A DIVISION OF WARMAN INTERNATIONAL

GRASSY KING ISLAND

PLAN NUMBER

04DM15 - 1009

83543d