
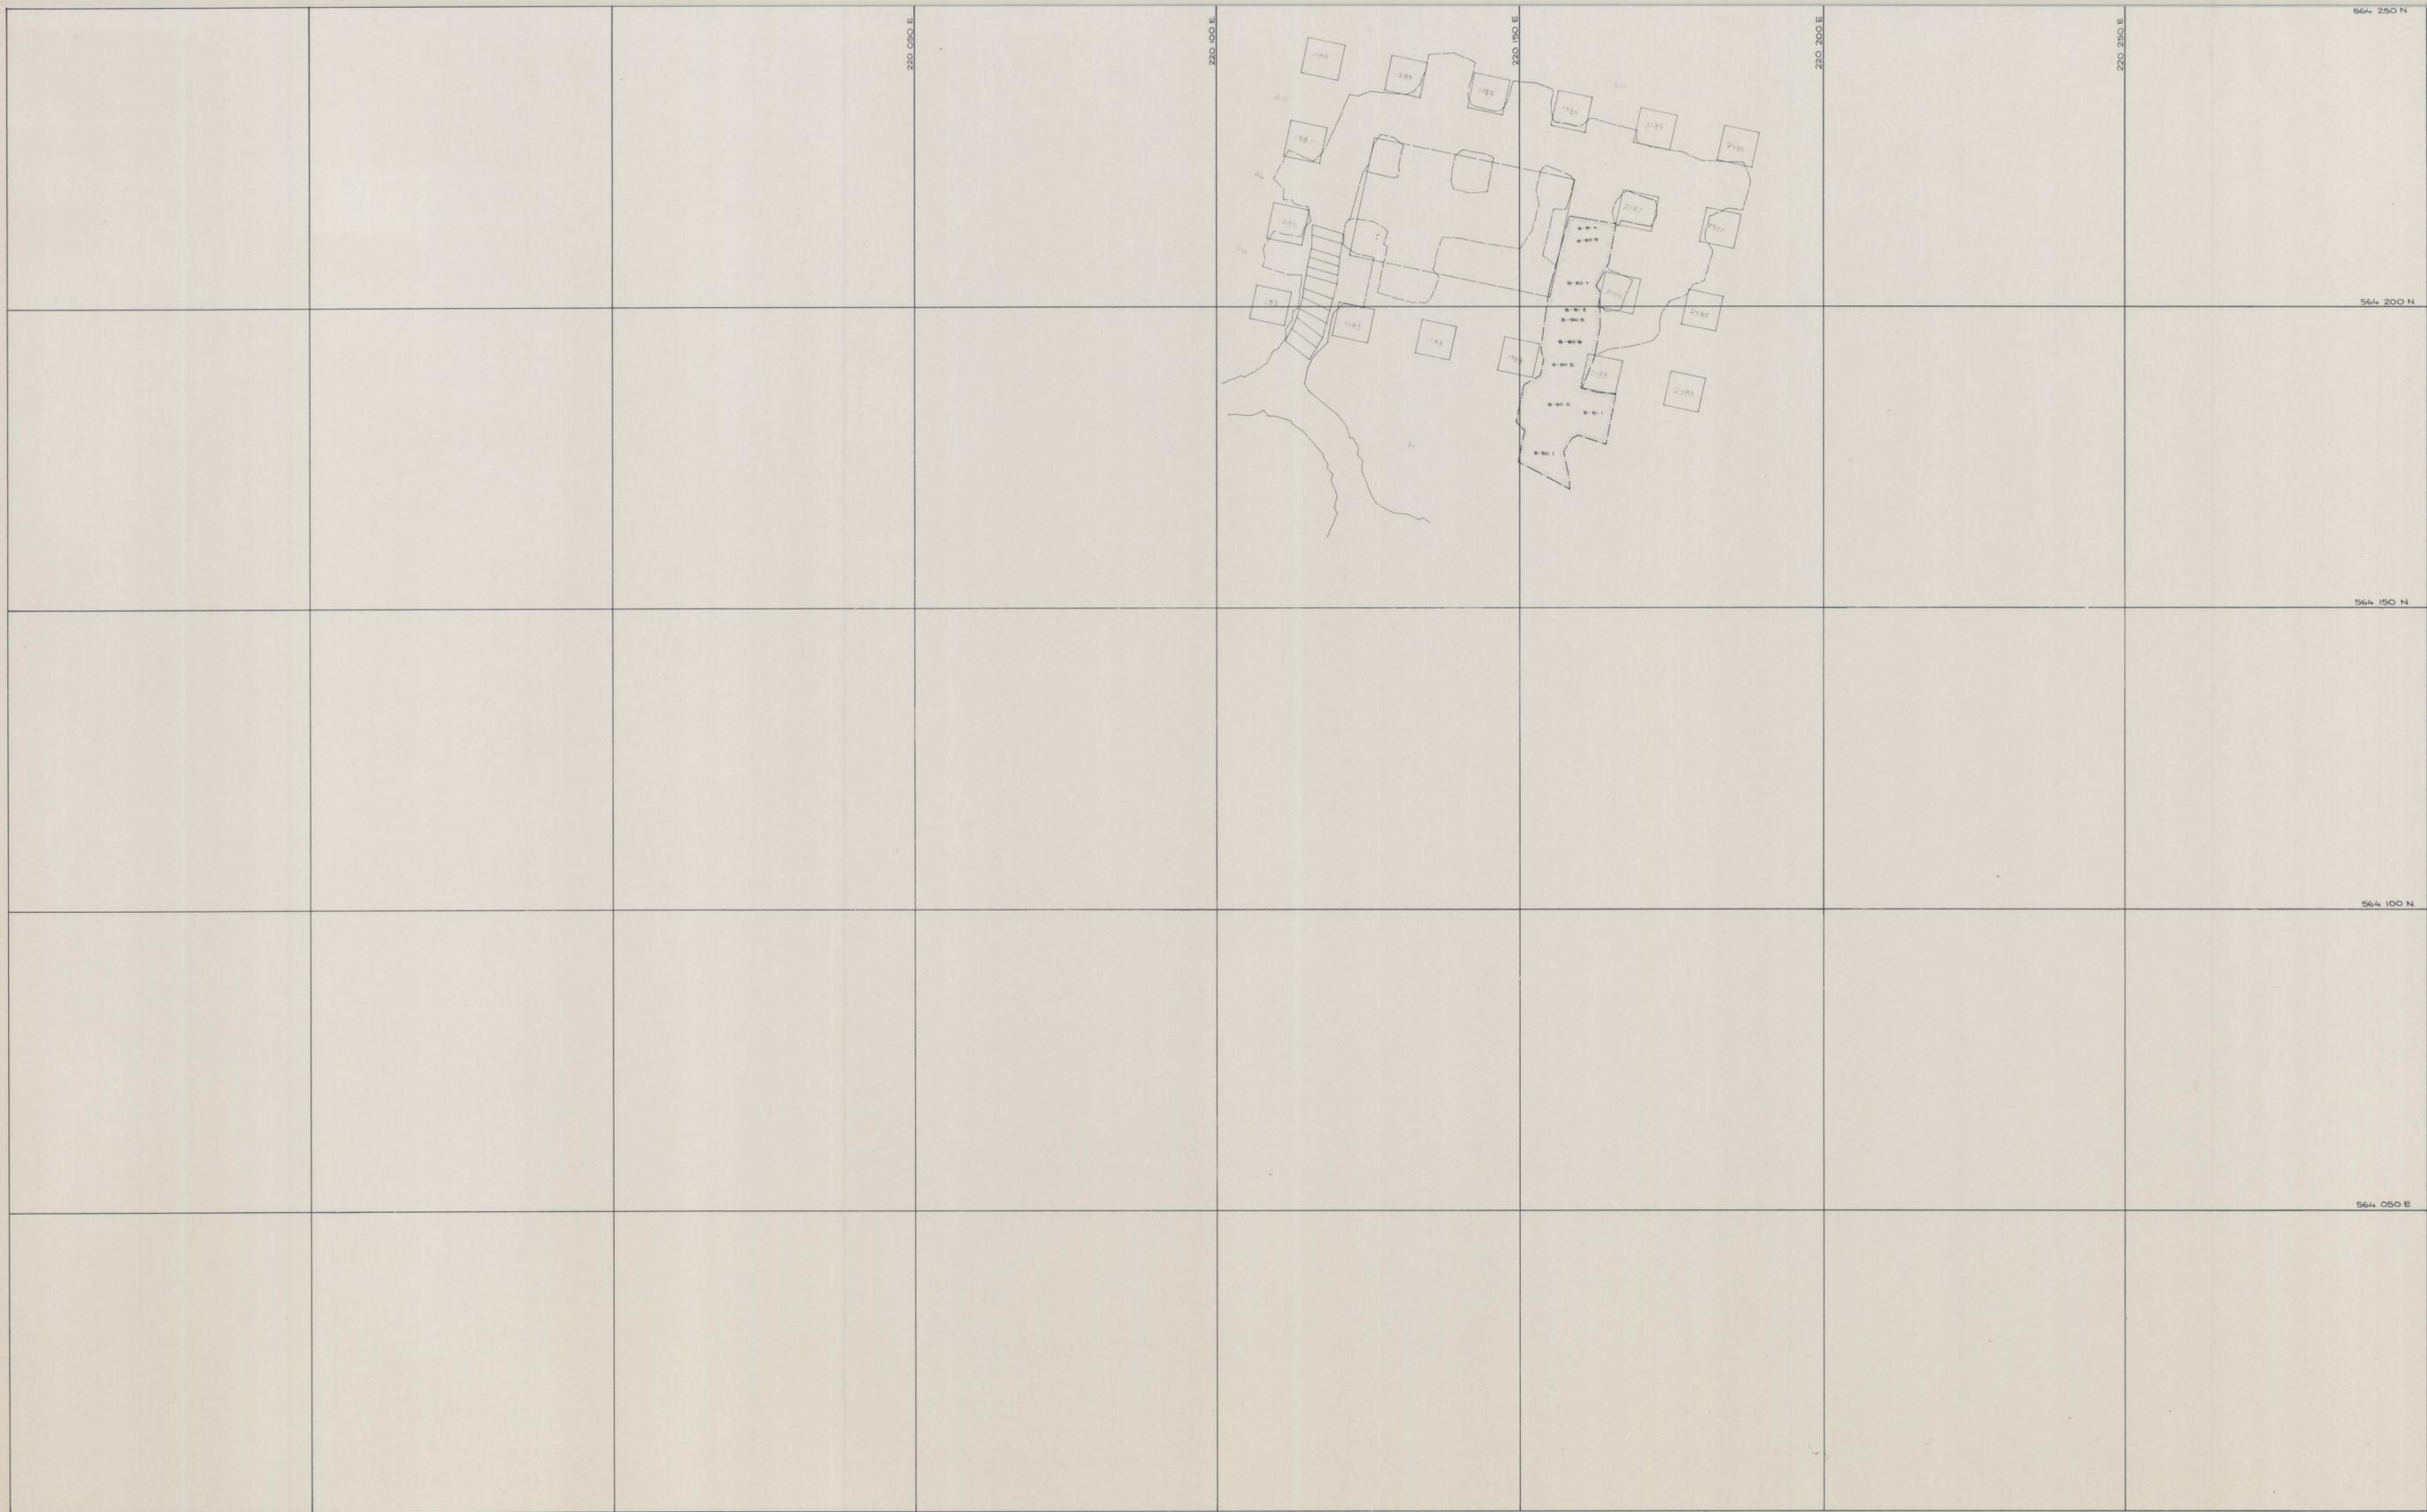


0374-046

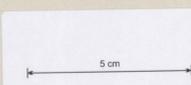

	<p>SCALE 1:500</p> 	 <p>north</p>	<p>LOCATION DOLPHIN MINE</p> <p>SUBJECT WEDGE STOPE BACKSTRIP - 14th lift</p>	 <p>KING ISLAND SCHEELITE A DIVISION OF WARMAN INTERNATIONAL</p> <p>GRASSY KING ISLAND</p> <p>PLAN NUMBER 04DM15 - 1008</p>
--	--	--	--	--

85343c