
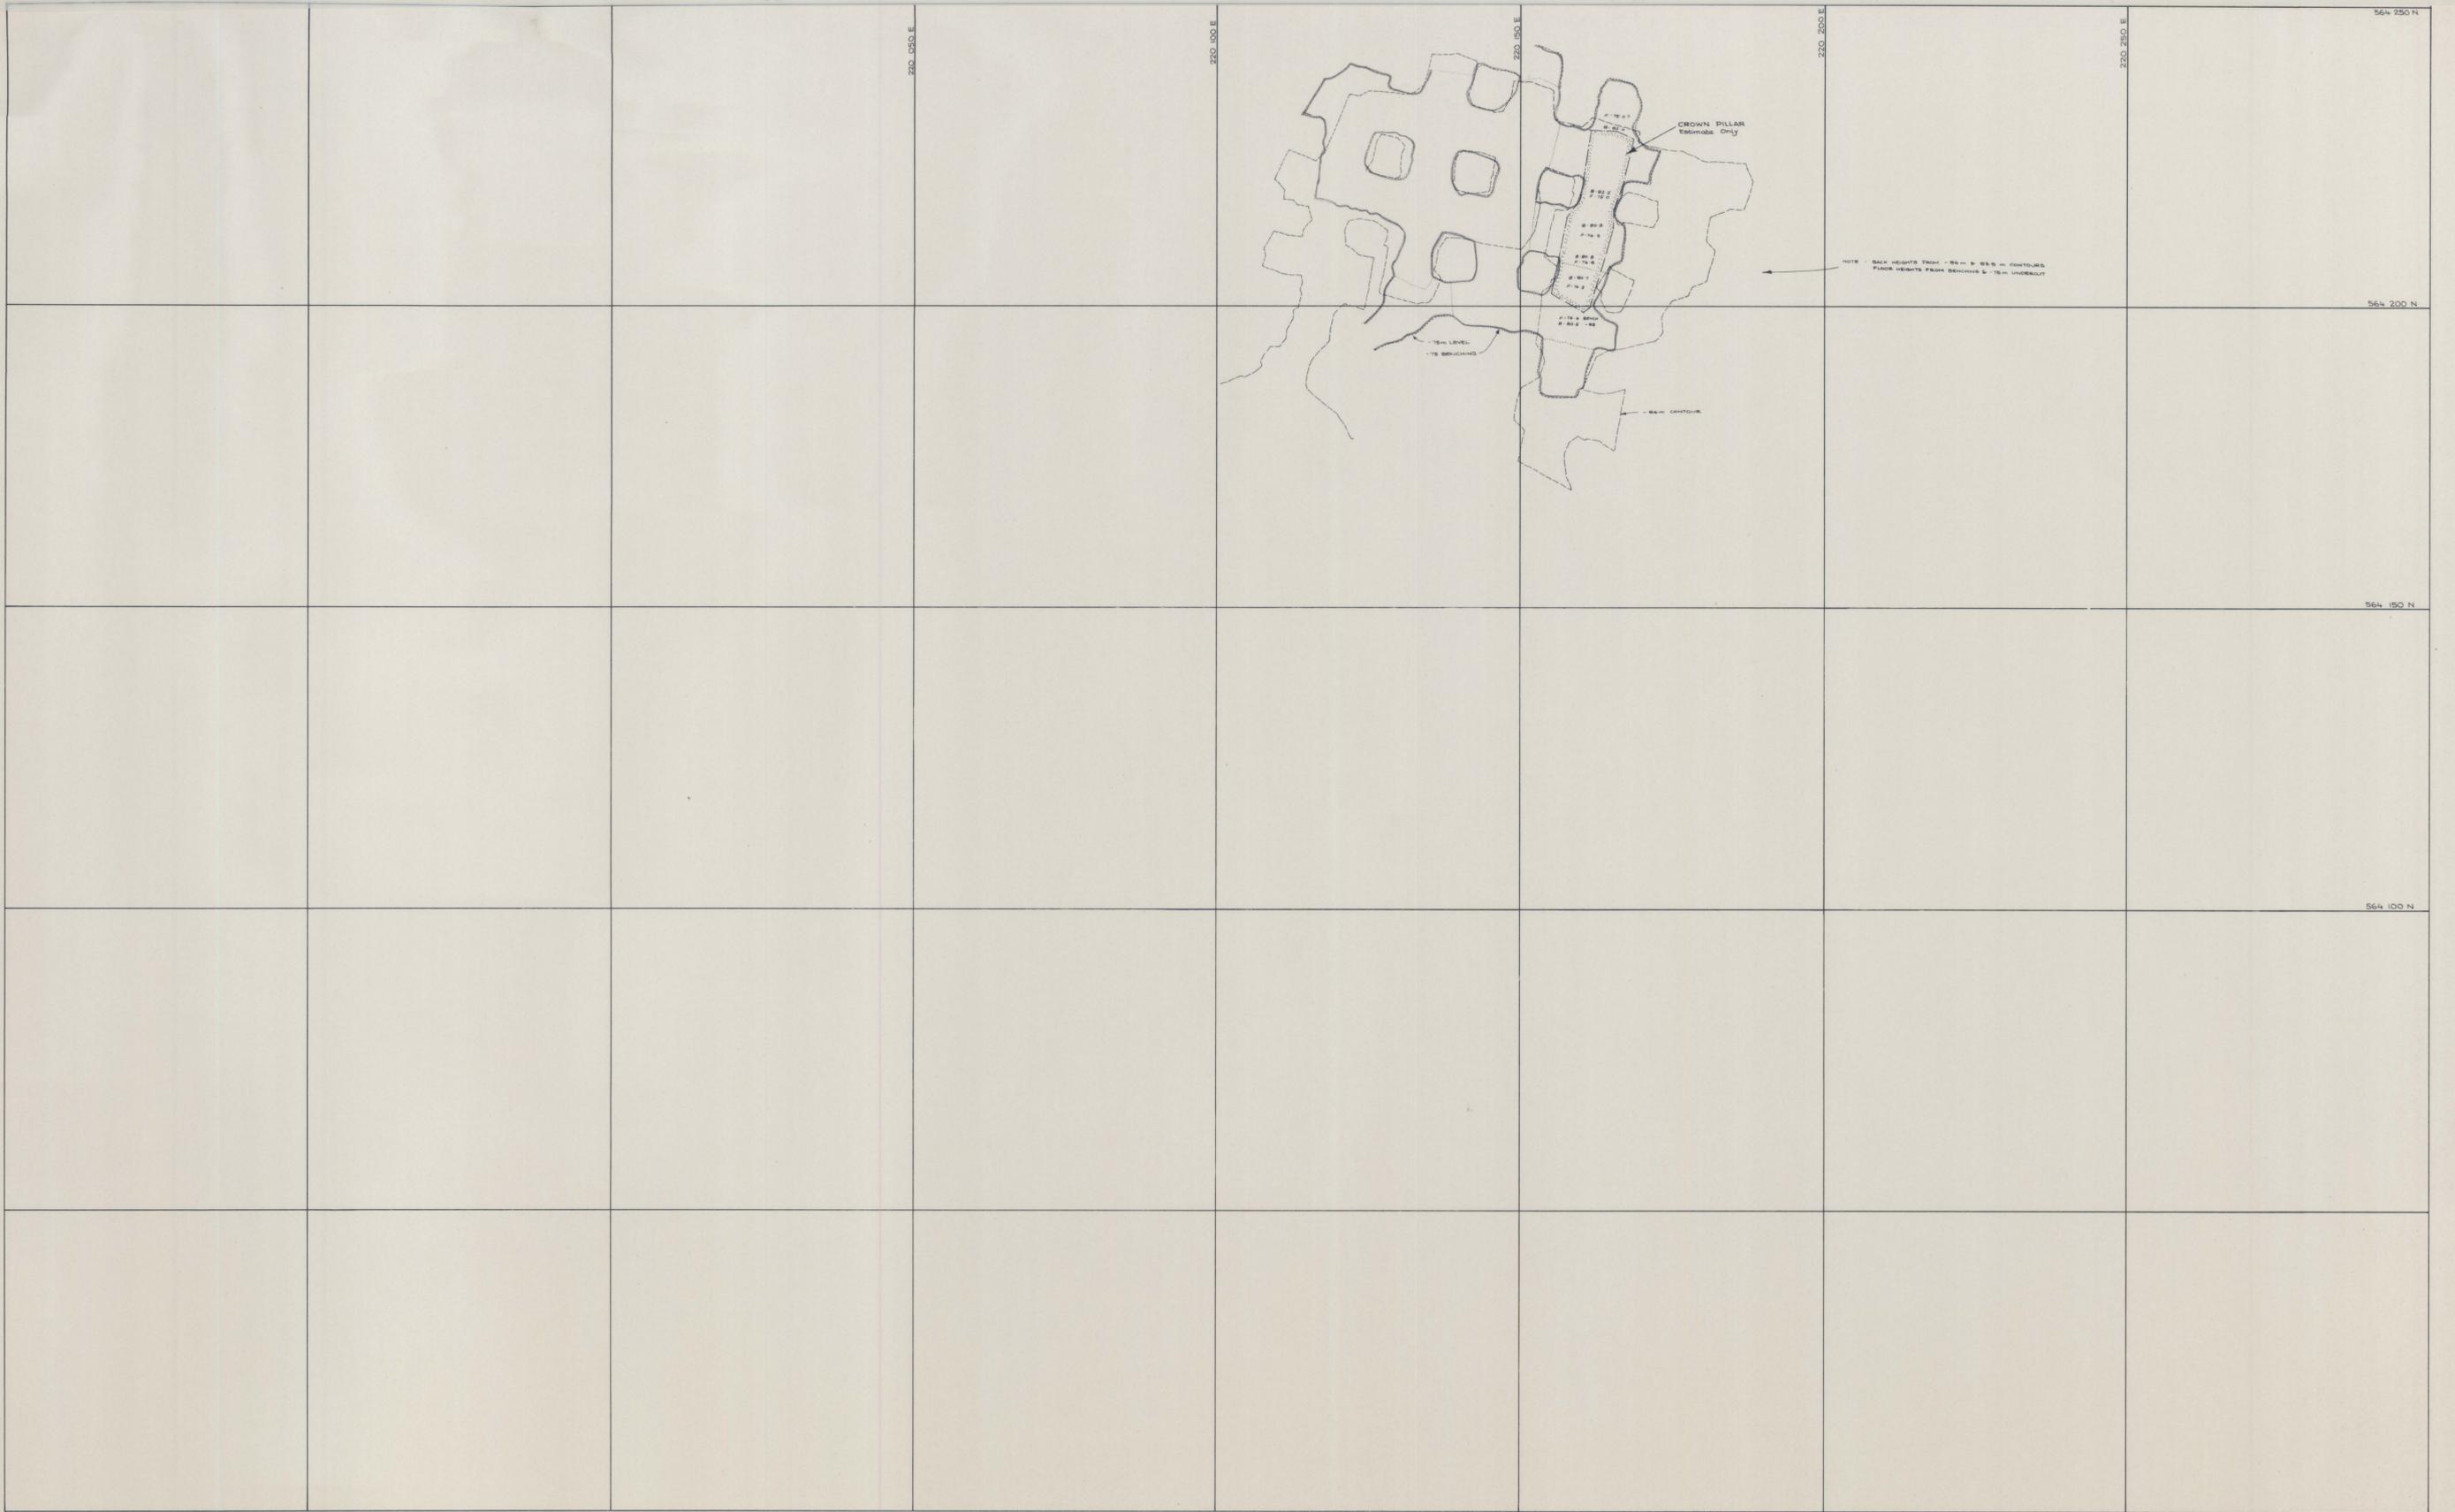
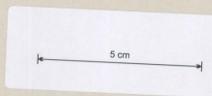


0374-047

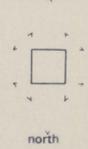

	<p>SCALE 1:500</p> 	 <p>north</p>	<p>LOCATION DOLPHIN MINE</p> <p>SUBJECT WEDGE STOPE CROWN PILLAR</p>	 <p>KING ISLAND SCHEELITE A DIVISION OF WARMAN INTERNATIONAL</p> <p>Our Mine PLAN NUMBER 04DM15 - 1007</p>
--	--	--	--	---

833436