
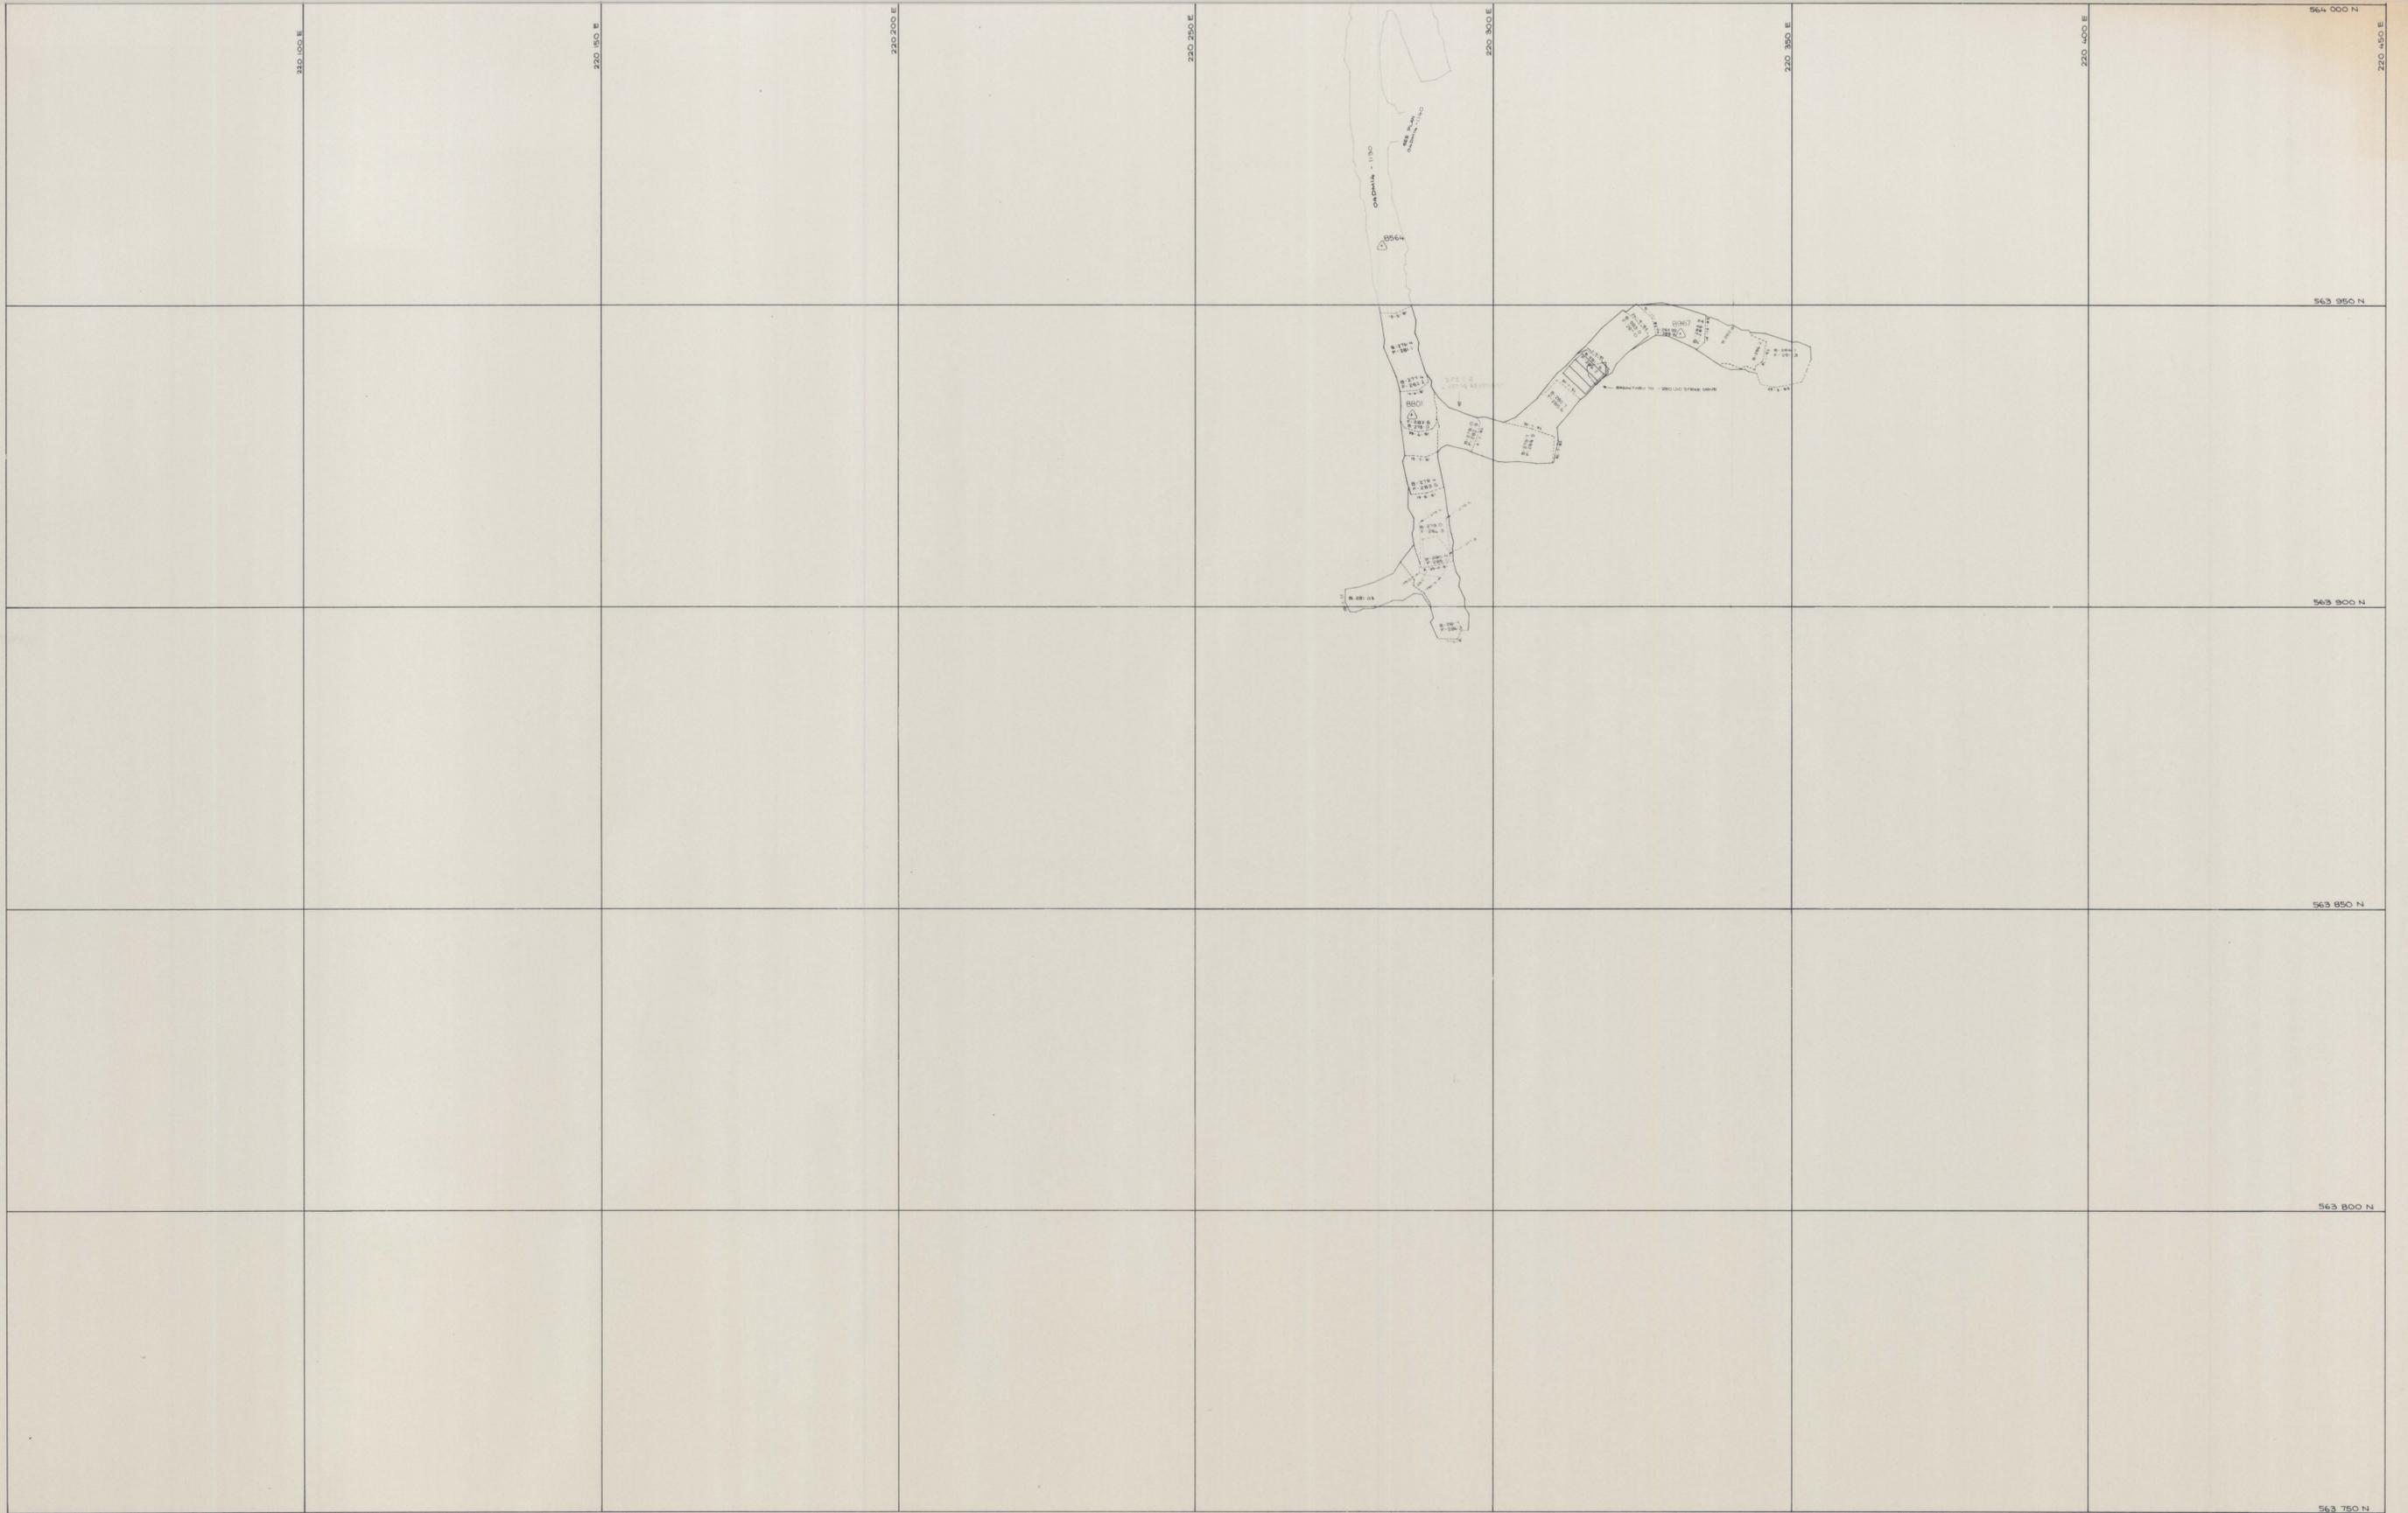


0374-048

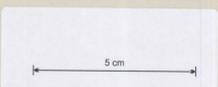

	<p>SCALE 1:500</p> 	 <p>north</p>	<p>LOCATION DOLPHIN MINE</p> <p>SUBJECT</p> <p>- 280m ZONE</p>	 <p>KING ISLAND SCHEELITE A DIVISION OF WARMAN INTERNATIONAL</p> <p>GRASSY KING ISLAND</p> <p>PLAN NUMBER 04DM14 - 1150</p>
--	----------------------------------------------------------------------------------------------------------	----------------------------------------------------------------------------------------------------	----------------------------------------------------------------	----------------------------------------------------------------------------------------------------------------------------------------------------------------------------------------------------------------------

83343a