
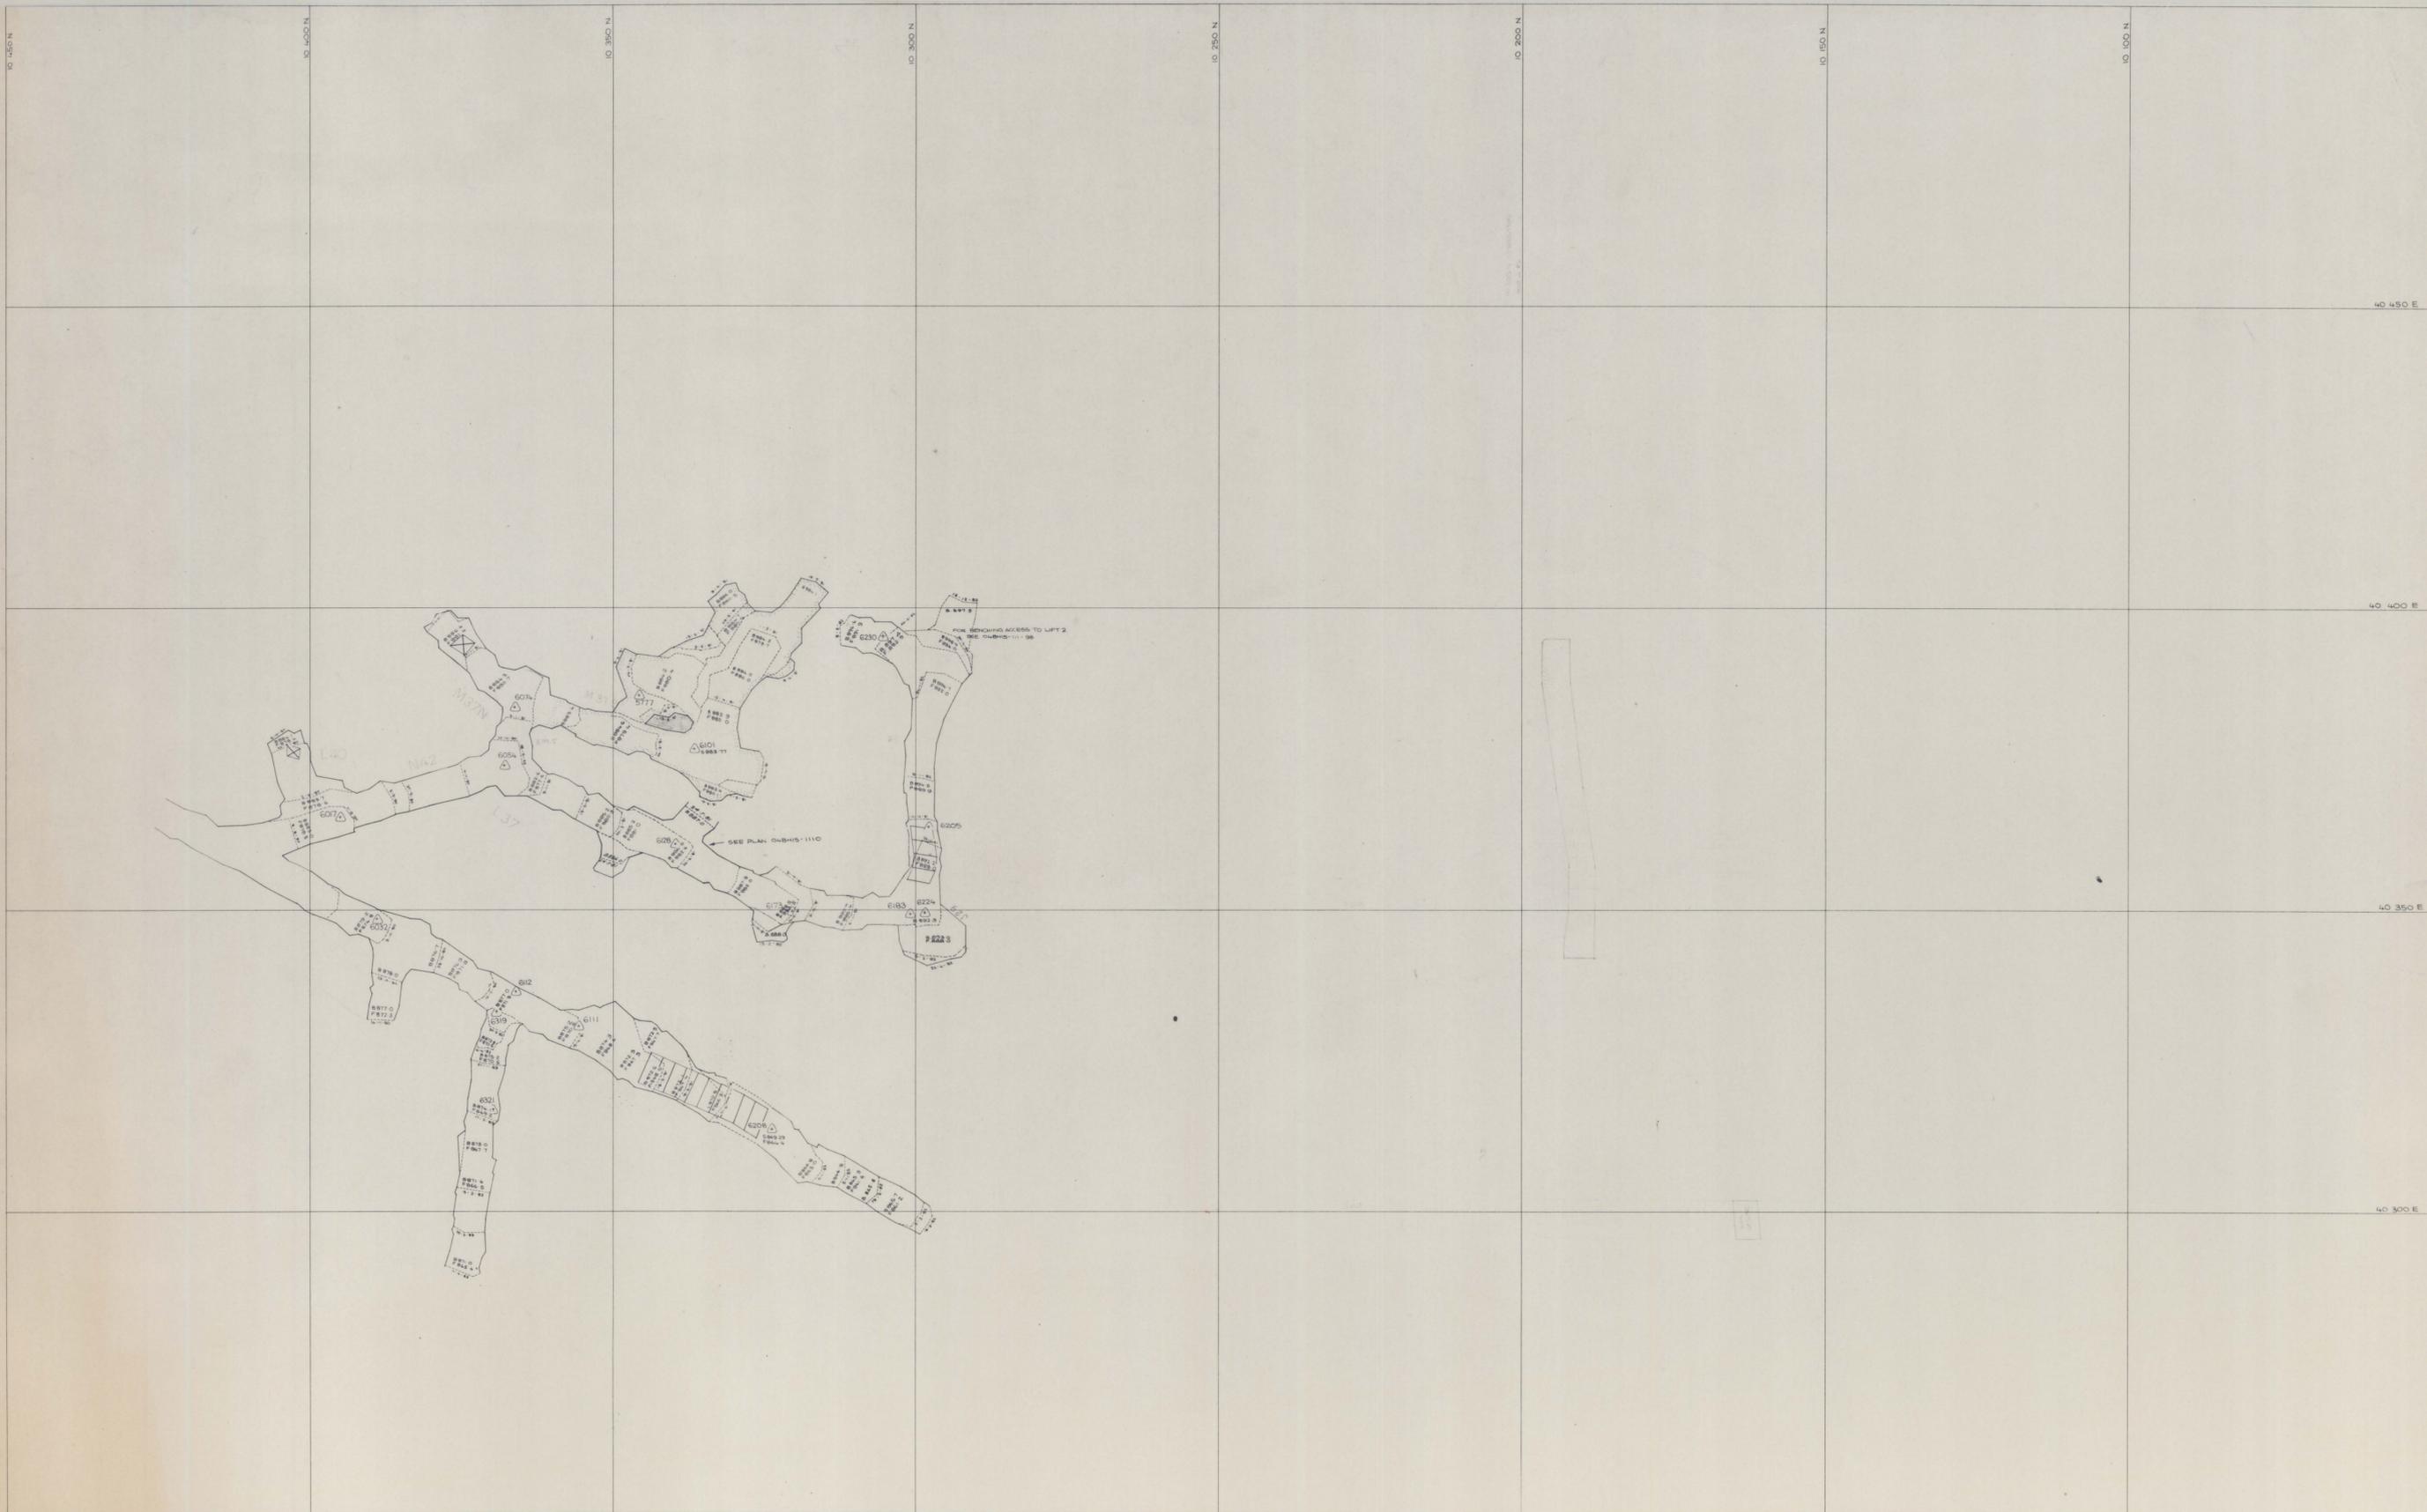


0374-058

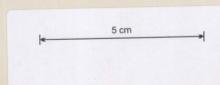

	SCALE 1:500 	north	LOCATION BOLD HEAD MINE SUBJECT MAIN DECLINE	 A DIVISION OF WARMAN INTERNATIONAL GRASSY KING ISLAND PLAN NUMBER 04BH14 - 1015
--	--	-------	---	---

83374