



0374-059

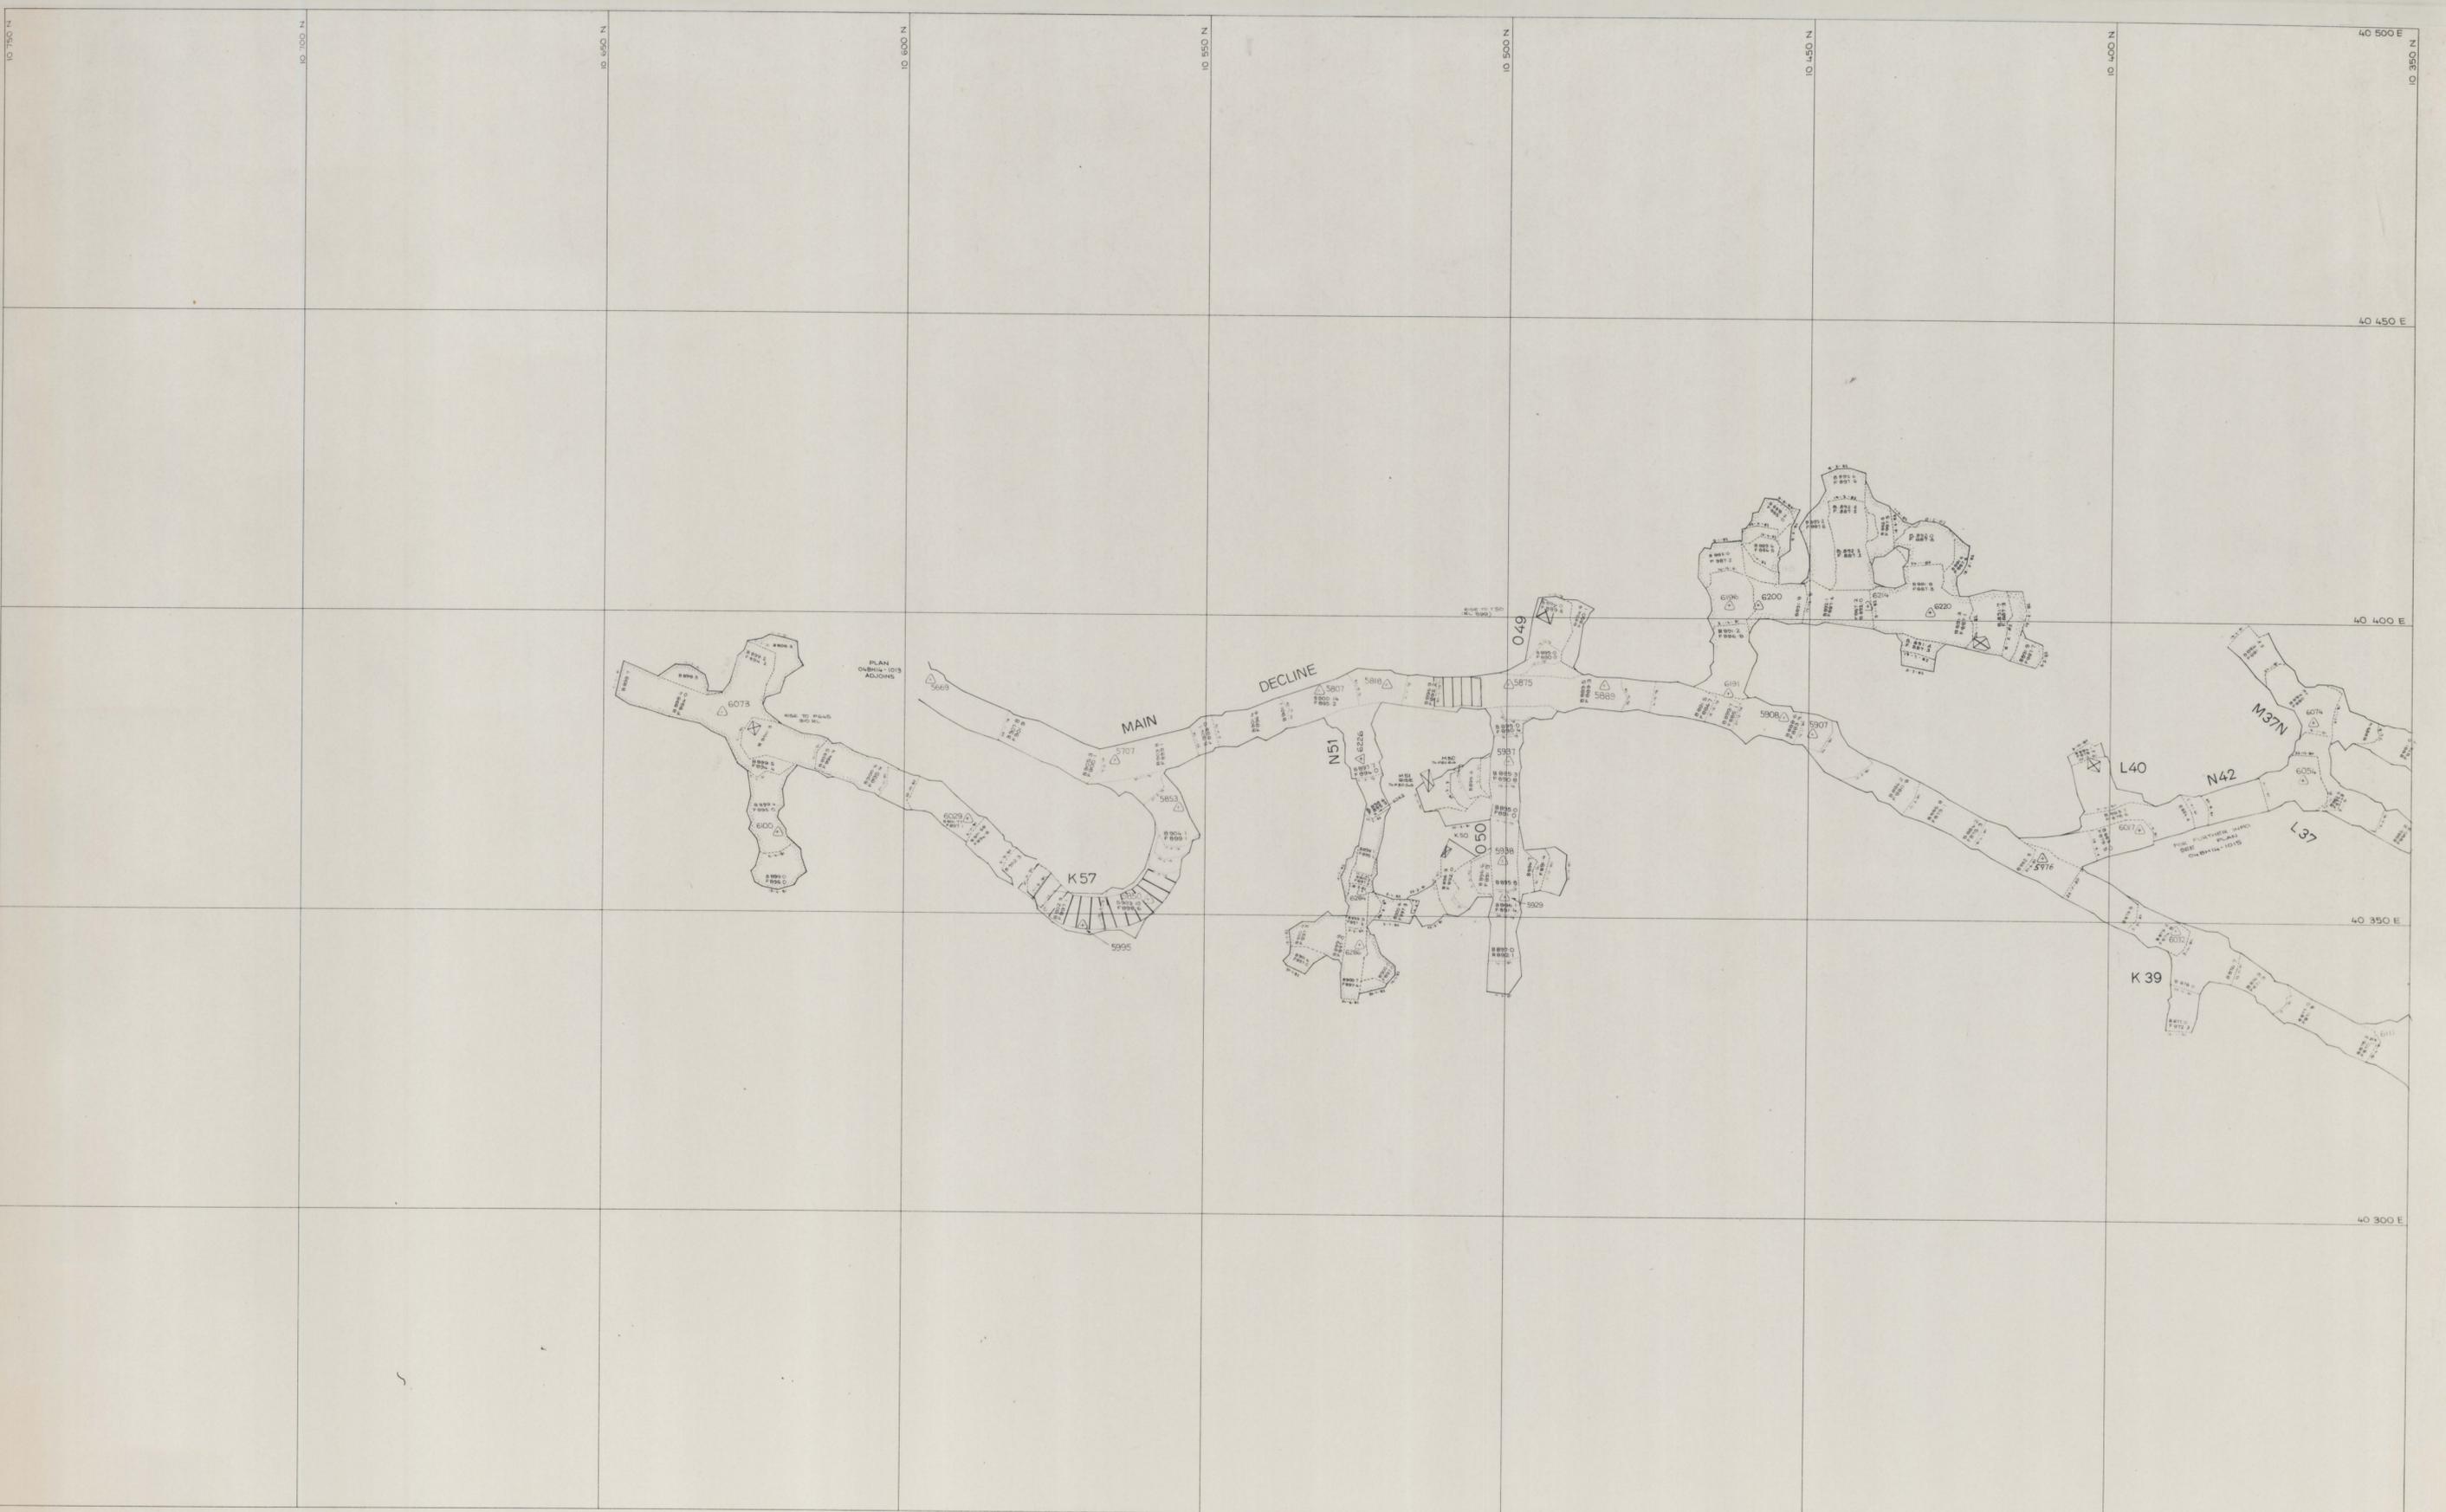

SCALE 1: 500

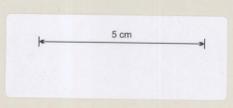

north

LOCATION

BOLD HEAD MINE

SUBJECT

DECLINE DEVELOPMENT

**KIS** KING ISLAND SCHEELITE  
 A DIVISION OF WARMAN INTERNATIONAL

GRASSY KING ISLAND

PLAN NUMBER

04BH14 - 1014

83375