


0374-064

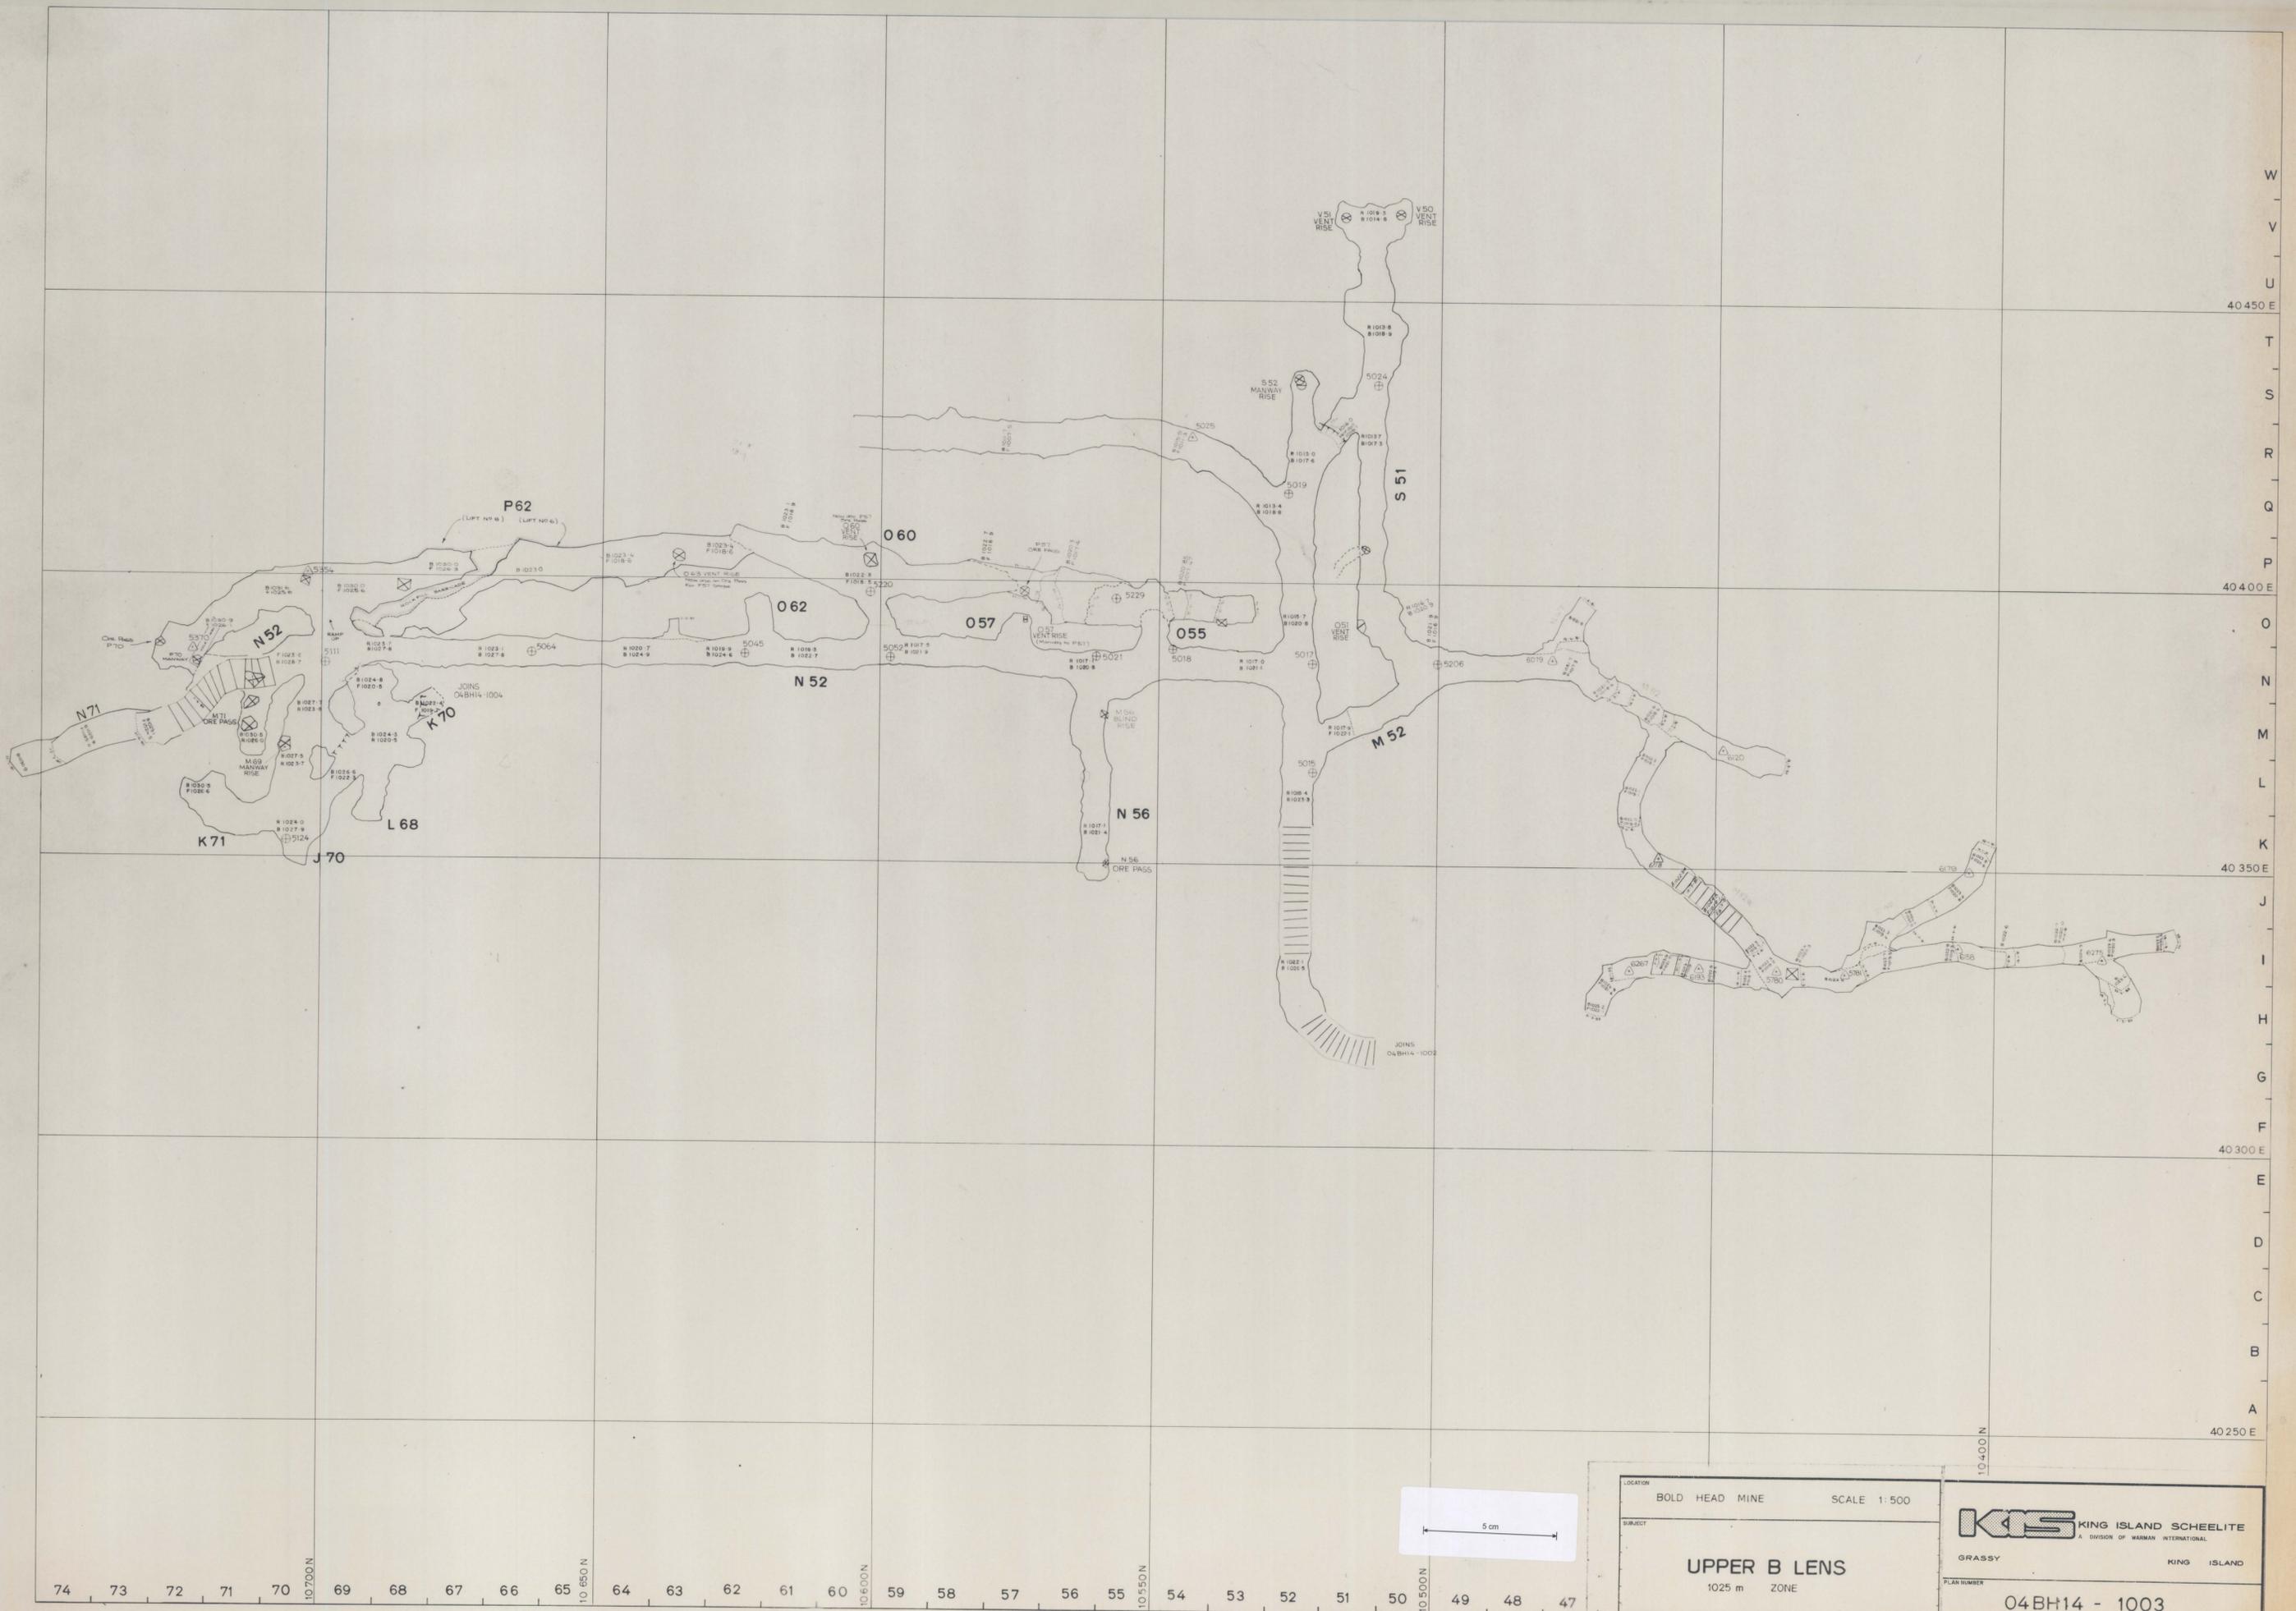

LOCATION BOLD HEAD MINE	SCALE 1:500
SUBJECT <b>UPPER B LENS</b> 1025 m ZONE	
 A DIVISION OF WARMAN INTERNATIONAL GRASSY KING ISLAND	
PLAN NUMBER 04BH14 - 1003	