



0374\_067

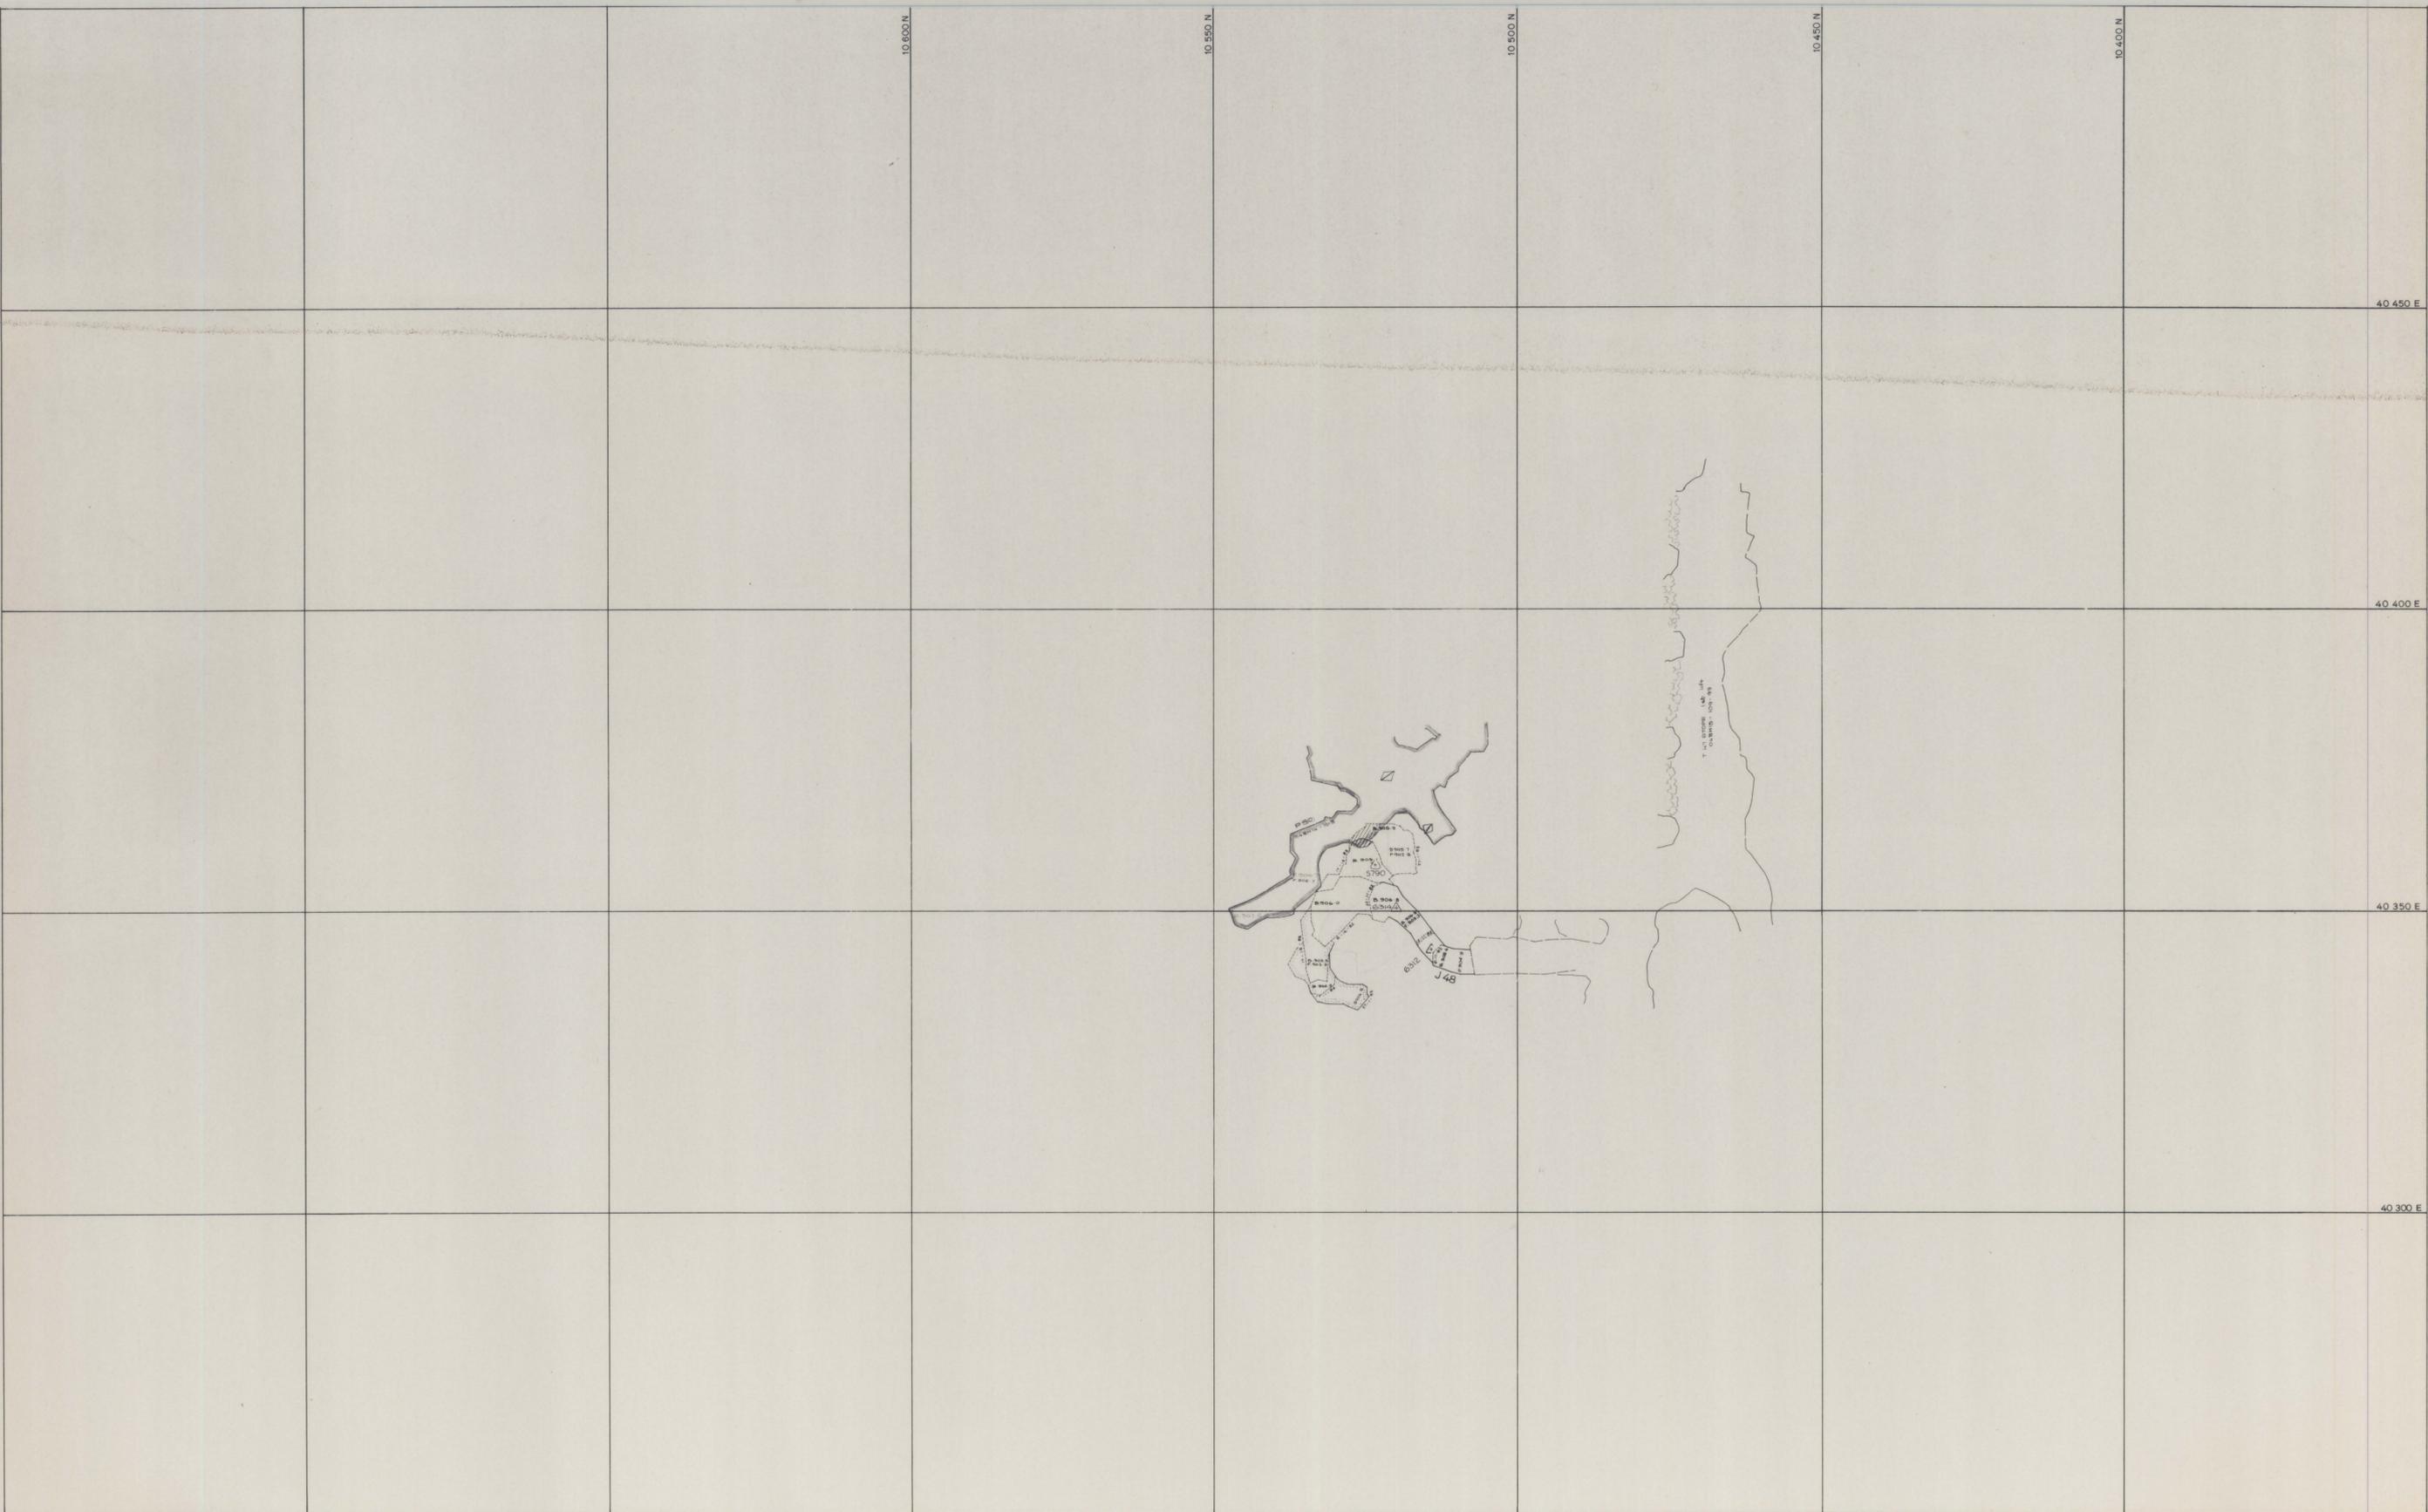

SCALE 1: 500

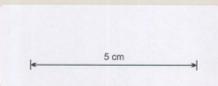

LOCATION

BOLD HEAD MINE

SUBJECT

N 51  
2nd Lift

**KIS** KING ISLAND SCHEELITE  
A DIVISION OF WARMAN INTERNATIONAL

GRASSY KING ISLAND

PLAN NUMBER

04 BH15 - 113 - 98

83367