
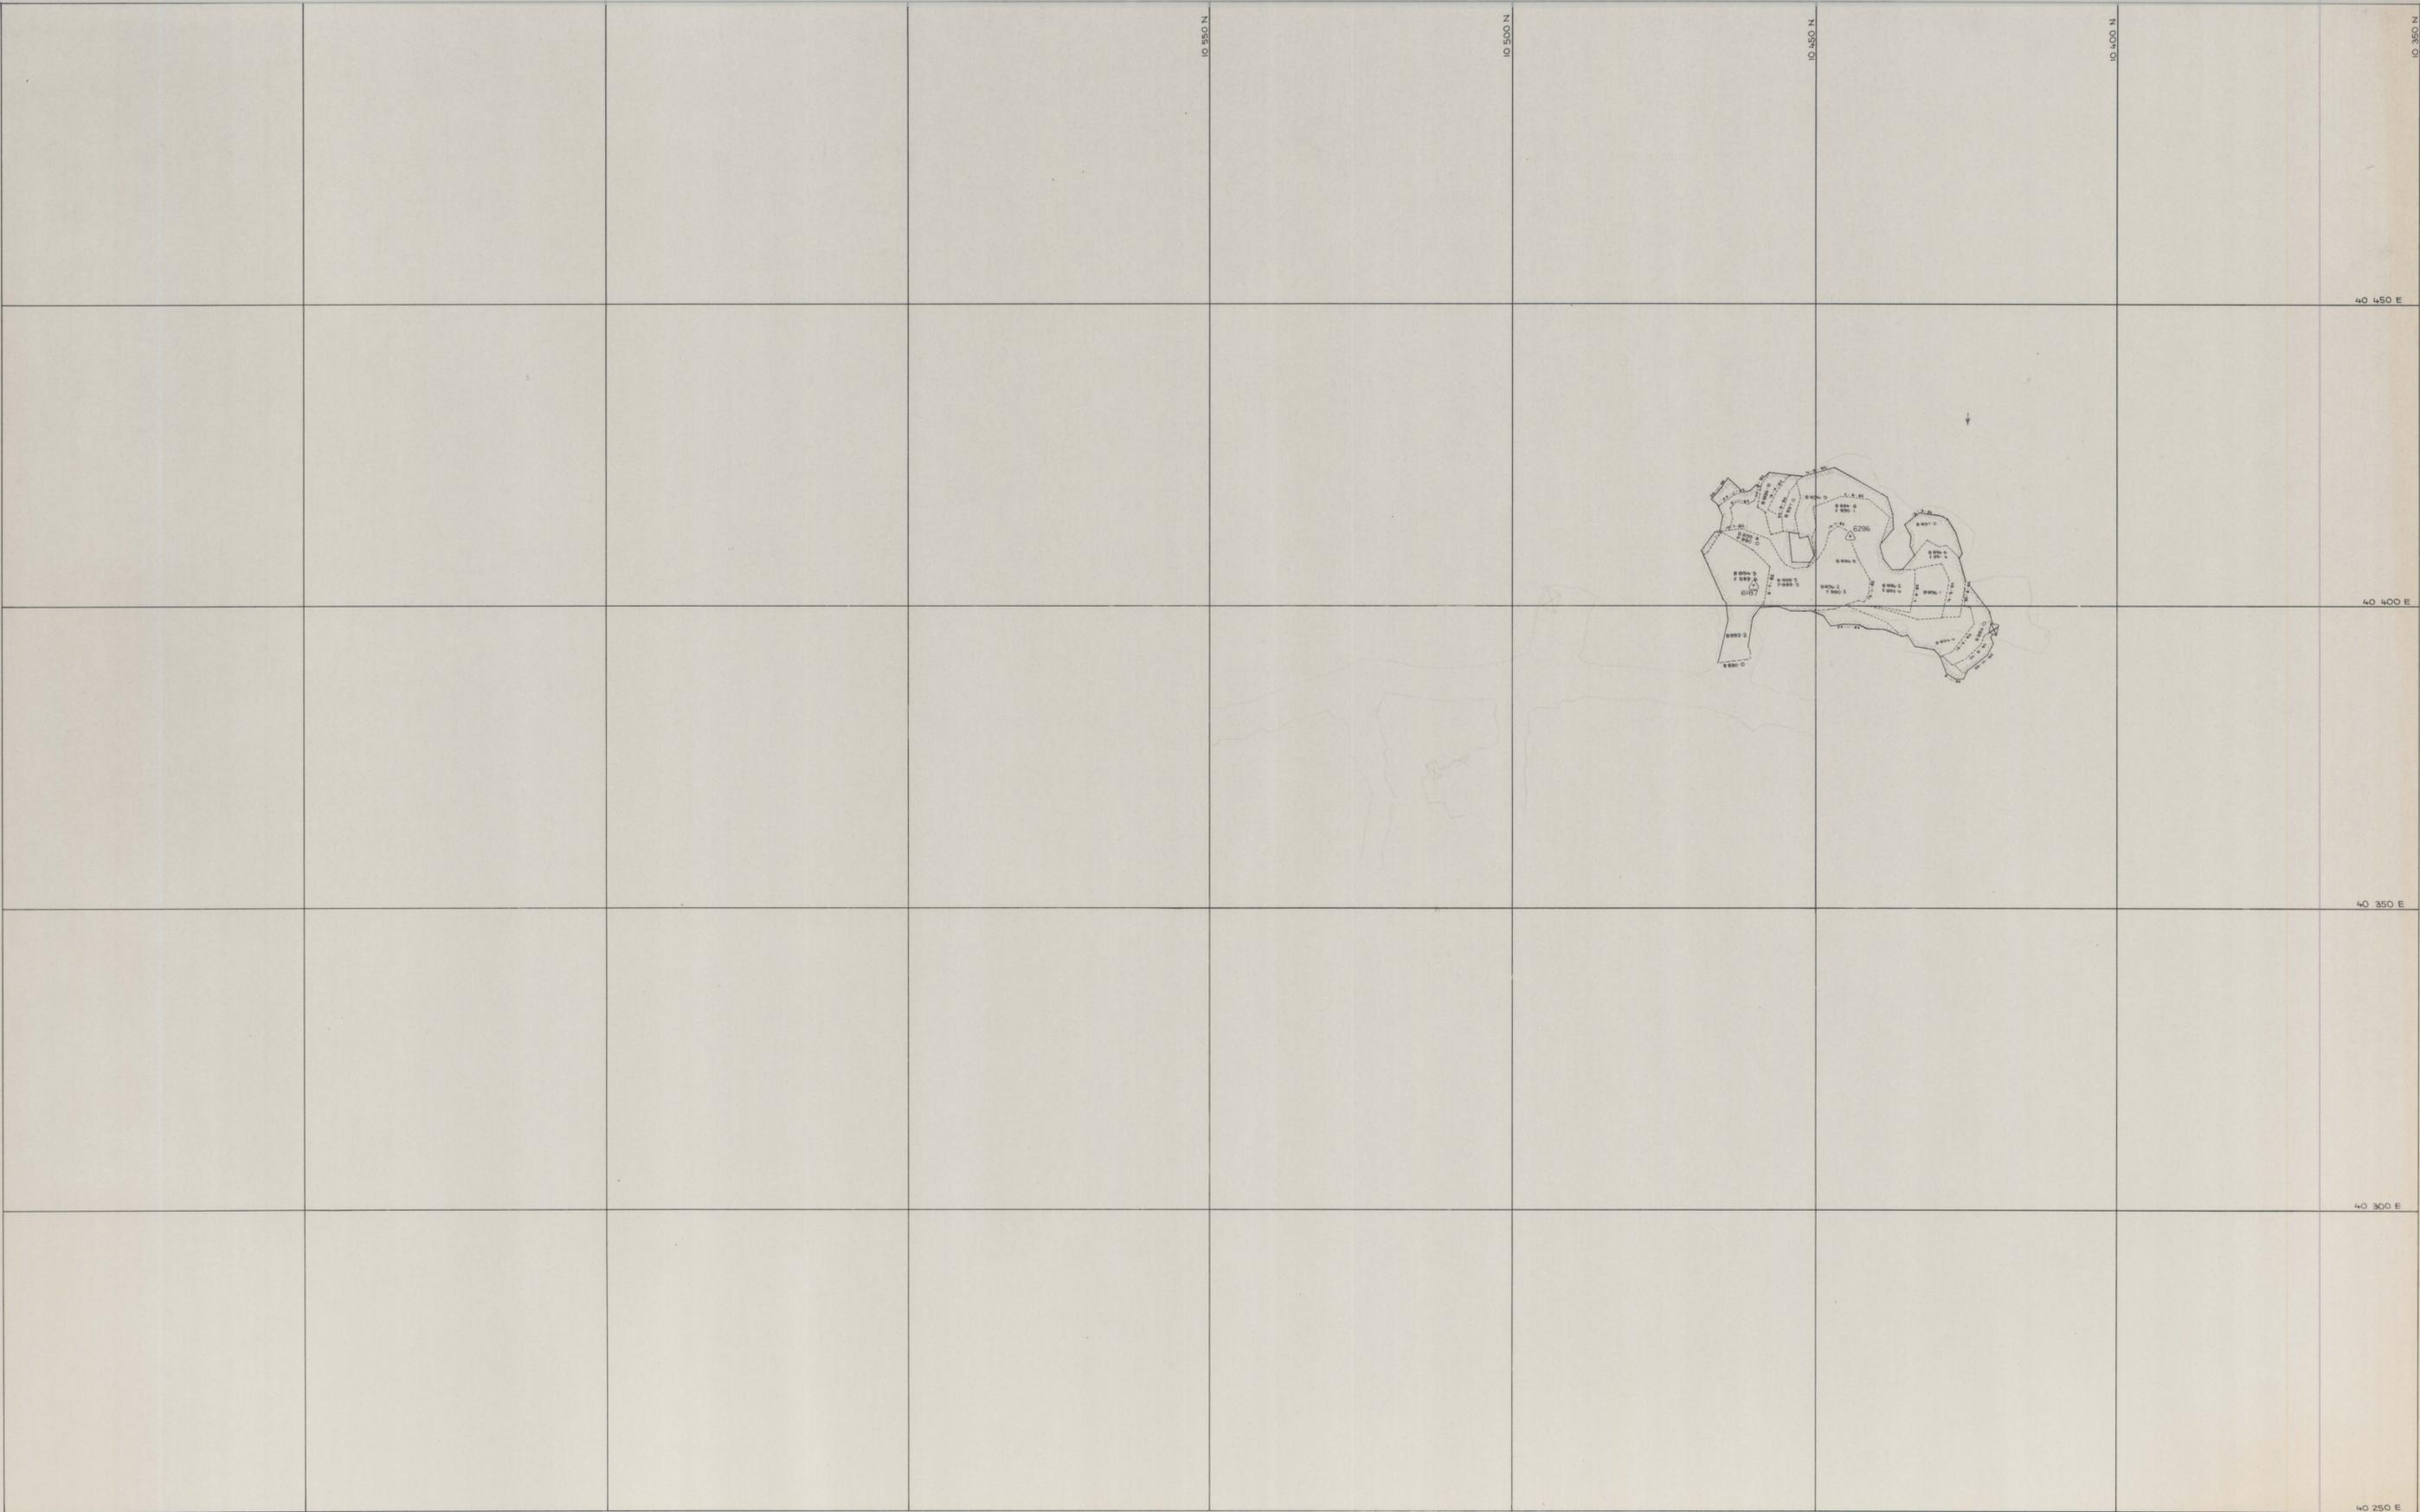
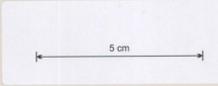


0374-068

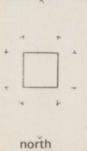

SCALE 1: 500 	 north	LOCATION BOLD HEAD MINE SUBJECT <p style="text-align: center;"><b>P 43 STOPE</b> 1st lift</p>	 KING ISLAND SCHEELITE A DIVISION OF WARMAN INTERNATIONAL GRASSY KING ISLAND PLAN NUMBER 04BH15 - 112 - 99
---	--	---	--

8336